


v:\B53\active\B53\0002\transportation\drawing\contract_nplot_files\zd307\cxs_nb.pftf

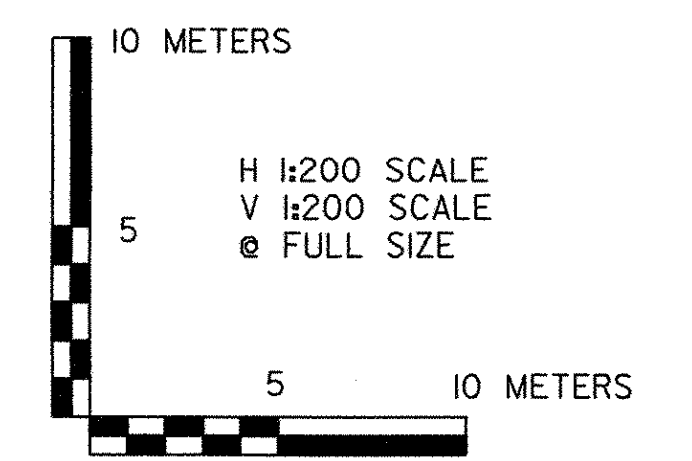

VERMONT AGENCY OF TRANSPORTATION	
	PROJECT NAME: BENNINGTON
	PROJECT NUMBER: AC NH 019-(51)
FILE NAME: ...\plot_files\zd307\cxs_nb.pftf	PLOT DATE: 2/2/2009
DESIGN SUPERVISOR: GREG EDWARDS	DRAWN BY: STANTEC
DESIGNED BY: MARC FOISY	CHECKED BY: GARY SANTY
NB MAINLINE CROSS SECTIONS NBX-07	SHEET 367 OF 367