


NOTE: SEE SHEET 4a AND 4 FOR STR126770P1S2 AND STR126770P5S2 JOINT PROFILE RESPECTIVELY.

CONFIRM REFERENCES

NOTE: EXPANSION JOINT DESIGN AND FABRICATED AT A JOINT OPENING (DIM "J") OF 140 (MORANGE)

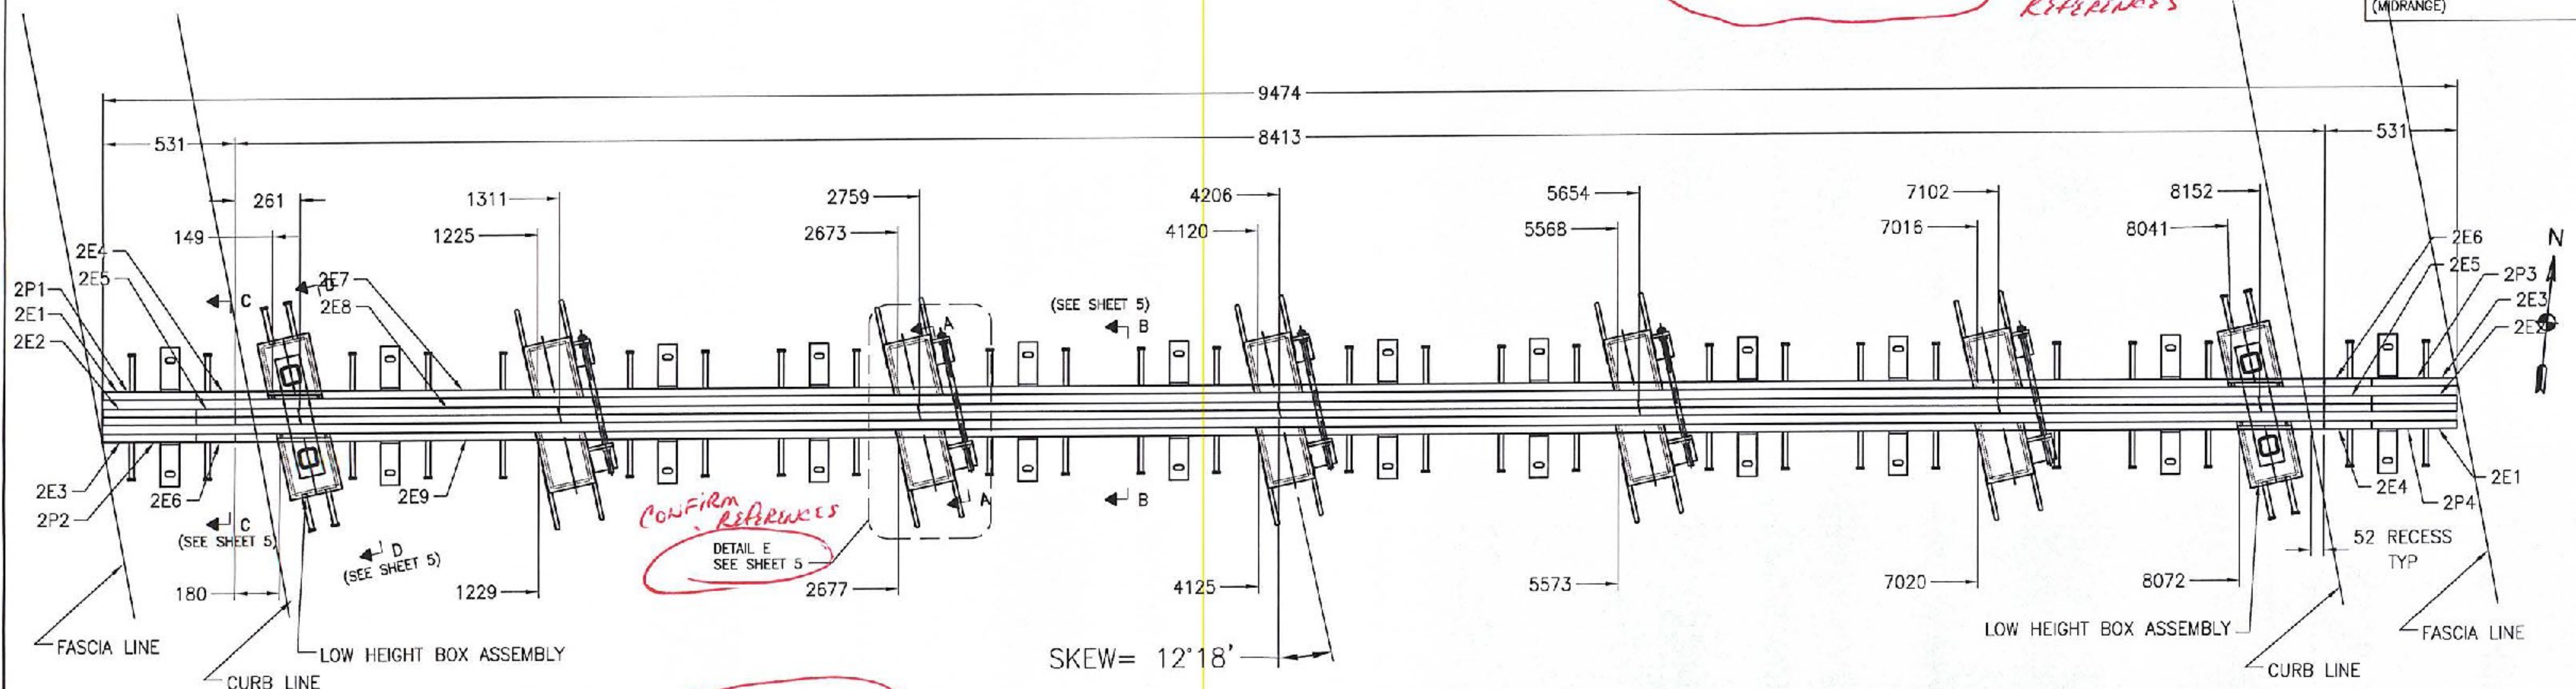

CONFIRM REFERENCES

ENSURE THIS SUPPORT BOX FITS WITHIN 400mm BLOCKOUT. REFER TO CONTRACT PLANS, SHEET BR 292

STR127660AB
1 REQUIRED @ RAMP D ABUTMENT 2
NTS

SEE CURB DETAILS ON SHEET 3

- NOTE:
- INSTALLATION WIDTH "J" AND DECK OPENING DIMENSION "A" TO BE DETERMINED BY ENGINEER.
 - MIN. ALLOWABLE JOINT OPENING = 64
MAX. ALLOWABLE JOINT OPENING = 216

TVGA CONSULTANTS

NO EXCEPTIONS TAKEN REJECTED
 FURNISH AS CORRECTED
 REVISE AND RESUBMIT

ENGINEER has reviewed Shop Drawings and Samples and other data which Contractor is required to submit, only for conformance with the information given in the Contract Documents and compatibility with the design concept of the completed Project as a functioning whole as indicated in the Contract Documents. Such reviews do not extend to means, methods, techniques, sequences or procedures of construction or to safety precautions and programs incident thereto. Such reviews do not extend to any LEED certification or accreditation. Contractor is responsible for dimensions to be confirmed and correlated at the job site; for information that pertains solely to the fabrication processes or to techniques of construction; and for coordination of the work of all trades.


W.B.A. PRODUCT NO.		"J" DIMENSIONS						
LOCATION		-20' C	-10' C	0' C	10' C	20' C	30' C	40' C
STR126770AA	RAMP A ABUT.2	179	162	145	129	112	95	78

FIX

INSPECTION REQUIRED

DATE: 6/17/2010

VERMONT AGENCY OF TRANSPORTATION
 COUNTY: BENNINGTON
 PROJECT NO.: AC NH 019-1(51)
 CAPITAL PROJECT ID NO.:
 BRIDGE NO.: B15, B15N, B15S
 WBA PRODUCT DESCRIPTION: MODULAR
 WBA PRODUCT NO.: STM126770AA

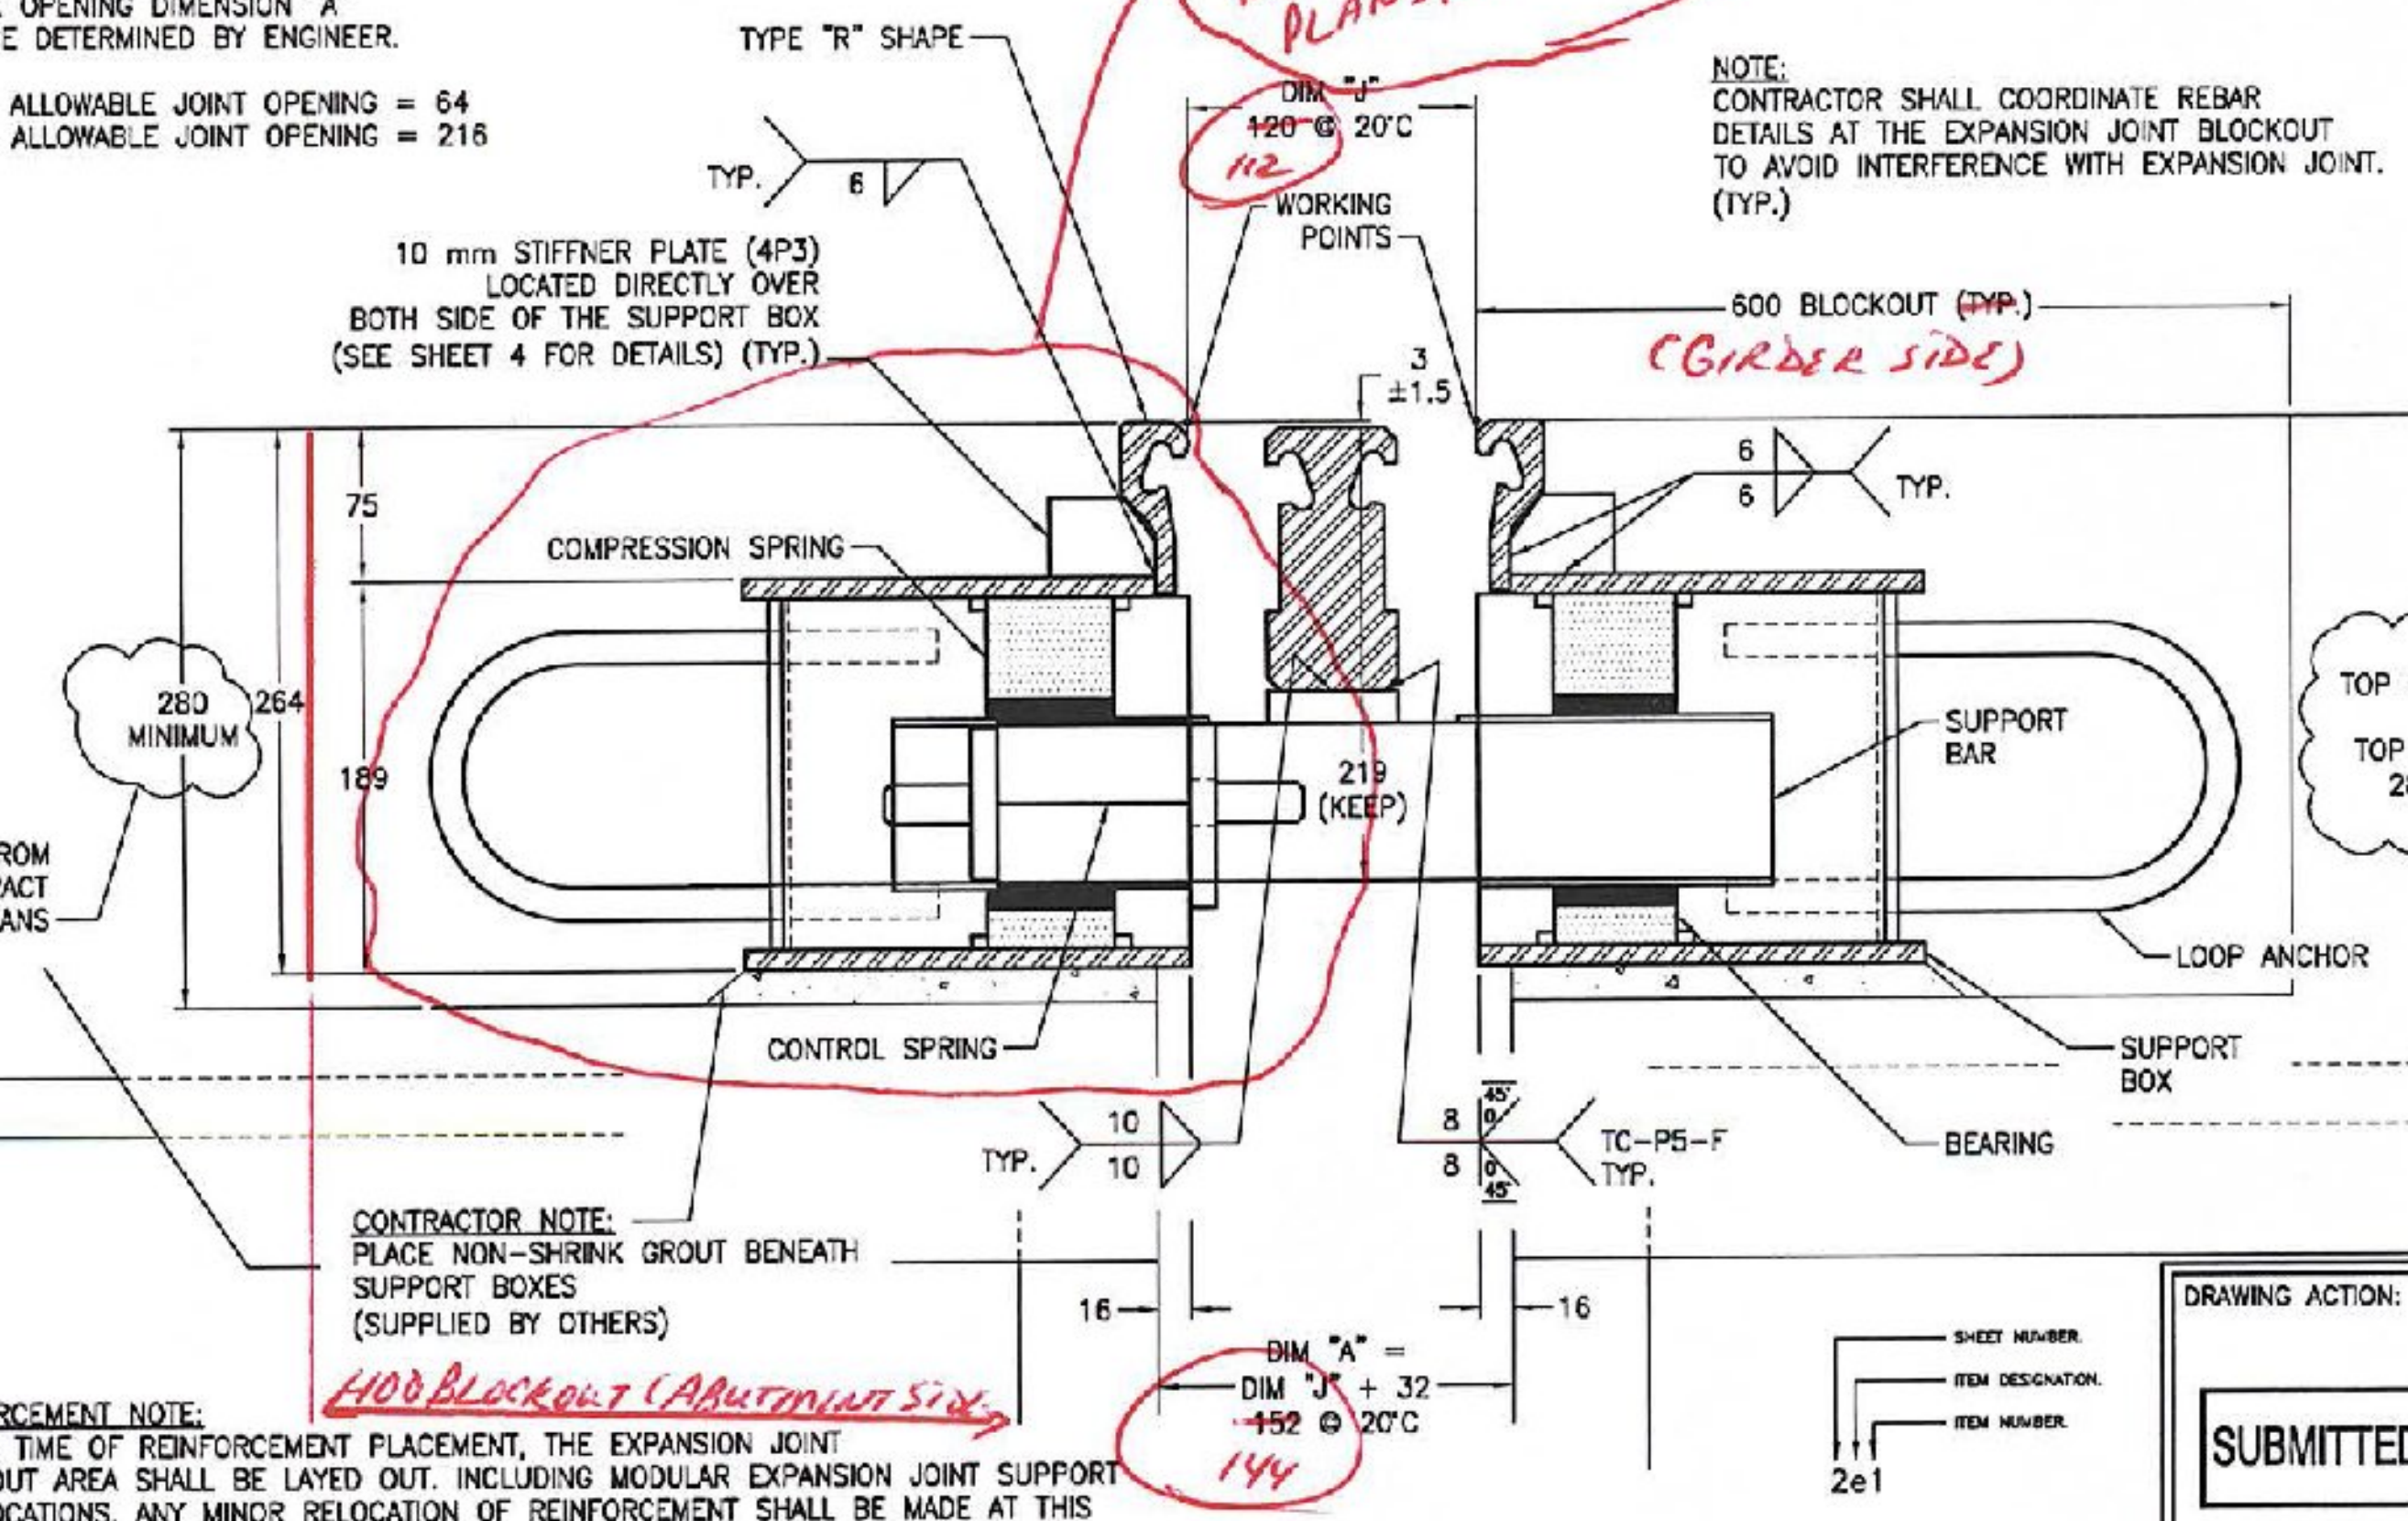

DRAWING ACTION:
SUBMITTED FOR APPROVAL
 1/20/10

Watson Bowman Acme
 25 Pioneer Drive
 Arden, NY 14208
 phone: (716) 884-7508
 fax: (716) 881-8225
 www.watsonbowman.com

BASF
 The Chemical Company

PROJECT: WWII VETERAN'S MEMORIAL HIGHWAY
 VT ROUTE 279, PRINCIPAL ARTERIAL
 WBA MODULAR STM-600 EXPANSION JOINT DETAILS

DATE: 12/23/09
 DATE: 1/7/10
 WBA JOB NO.: 126770
 DRAWING NO.: B-27574

SECTION A-A