

SUPPORT BOX ASSEMBLY
STR126770P1S203

7P1 & 7P2 DETAIL
10 PLATE (3/8\"/>

7P3 & 7P5 DETAIL
10 PLATE (3/8\"/>

TVGA CONSULTANTS

NO EXCEPTIONS TAKEN REJECTED
 FURNISH AS CORRECTED
 REVISE AND RESUBMIT
 ENGINEER has reviewed Shop Drawings and Samples and other data which Contractor is required to submit, only for conformance with the information given in the Contract Documents and compatibility with the design concept of the completed Project as a functioning whole as indicated in the Contract Documents. Such reviews do not extend to means, methods, techniques, sequences or procedures of construction or to safety precautions and programs incident thereto. Such reviews do not extend to any LEED certification or accreditation. Contractor is responsible for dimensions to be confirmed and correlated at the job site; for information that pertains solely to the fabrication processes or to techniques of construction; and for coordination of the work of all trades.

BY: *[Signature]*
 DATE: 1/20/10


VERMONT AGENCY OF TRANSPORTATION
 COUNTY: BENNINGTON
 PROJECT NO.: AC NH 019-1(51)
 CAPITAL PROJECT ID NO.: -
 BRIDGE NO.: B15, B15N, B15S
 WBA PRODUCT DESCRIPTION: MODULAR
 WBA PRODUCT NO.: STM126770AA

STR126770AA03 QTY: 1 REQ'D. STRUCTURED BILL OF MATERIALS

LV	PART NO.	QTY	UM	DESCRIPTION	CLASS	MATERIAL	REVISION
0	STR126770AA03	1	EA	STR-600 SUPPORT BOX (X)		UNCOATED	
1	3550	13.50	KG	PLATE 10 A 588	A	ASTM A-588	
1	STR126770AA03A	1.00	EA	SUPPORT BOX HARDWARE PARTS (U)			
2	4317	2.00	EA	MOD LOOP BOX ANCHOR C1146B*(W)	A	ASTM A-36	
2	7233	2.00	EA	PIPE 190, SCHEDULE 40 x 25 LONG	A	SCHEDULE 40	
2	4286	2.00	EA	MOD BEARING KPR RING A22201*(W)	A	ASTM A-500 GRADE B	

STR126770AA04 QTY: 1 REQ'D. STRUCTURED BILL OF MATERIALS

LV	PART NO.	QTY	UM	DESCRIPTION	CLASS	MATERIAL	REVISION
0	STR126770AA04	1	EA	STR-600 SUPPORT BOX (X)		UNCOATED	
1	3550	13.50	KG	PLATE 10 A 588	A	ASTM A-588	
1	STR126770AA04A	1.00	EA	SUPPORT BOX HARDWARE PARTS (U)			
2	4317	2.00	EA	MOD LOOP BOX ANCHOR C1146B*(W)	A	ASTM A-36	
2	4286	2.00	EA	MOD BEARING KPR RING A22201*(W)	A	ASTM A-500 GRADE B	

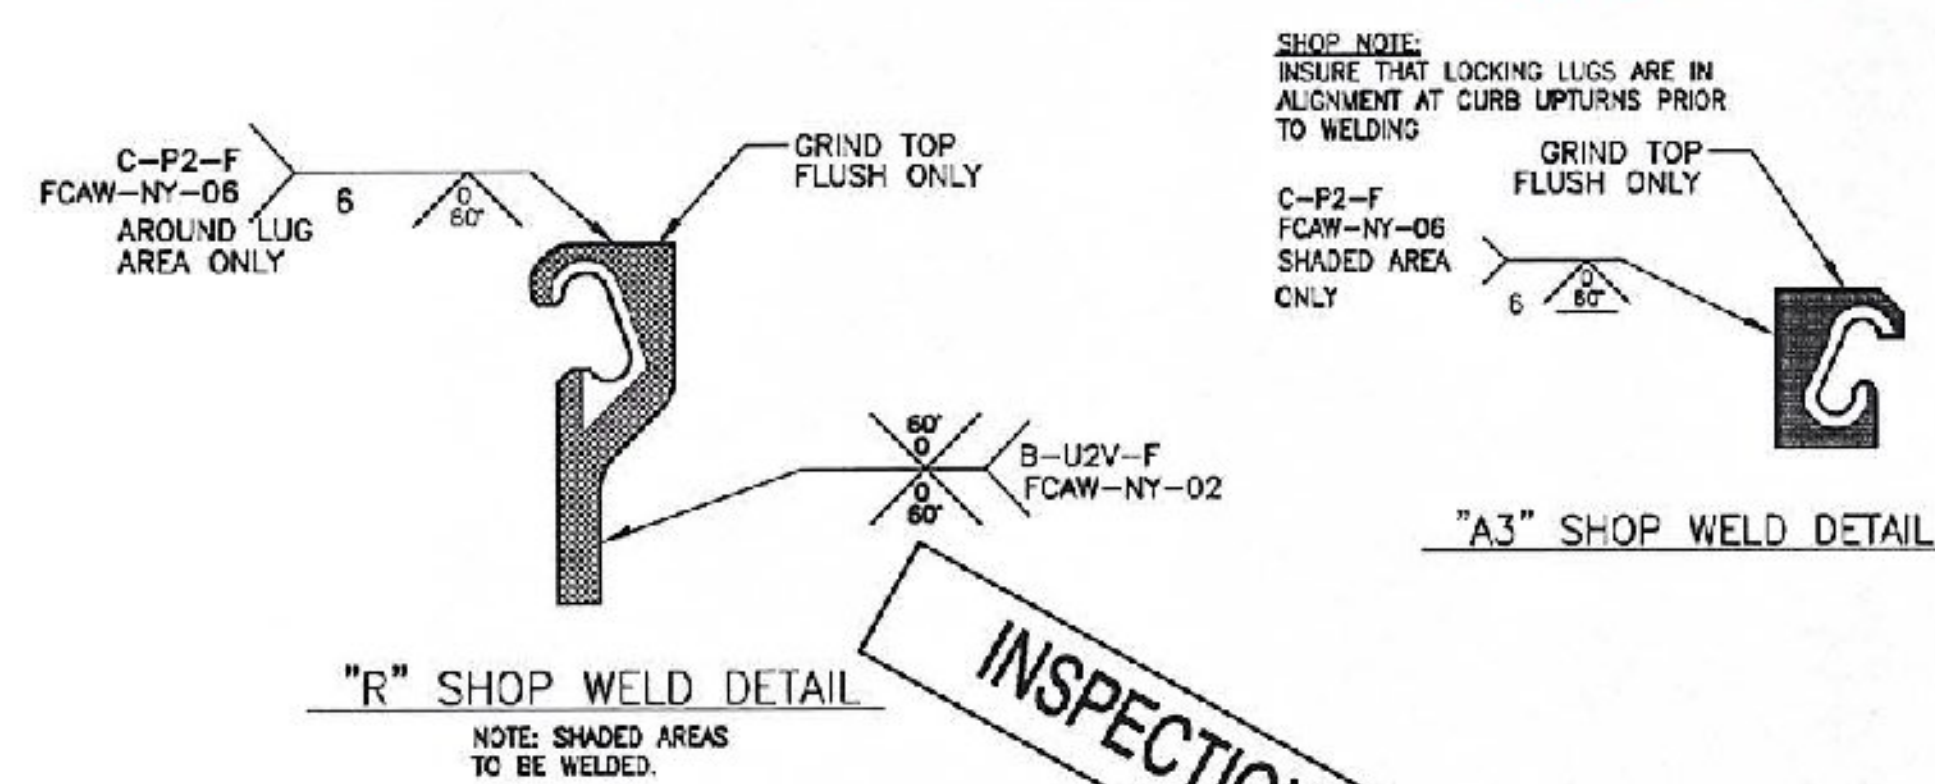

INSPECTION REQUIRED

MARK SYSTEM

2e1

DRAWING ACTION:
 SUBMITTED FOR APPROVAL
 1/20/10

Information provided herein, including but not limited to, any drawing, design, photograph, graphic, or statimetric(s) ("Materials") are proprietary and the property of Watson Bowman Acme Corporation ("Company"). Reproduction, translation, or reaction to any electronic medium or machine readable form, in whole or part, is strictly prohibited, except for the express purpose for which it has been furnished, without prior written consent of Company. All Materials contained herein are provided by Company for informational purposes only. Company reserves the right to amend or withdraw any information contained in the Materials without notice. All technical or other advice by Company, whether verbal or written, concerning products, or the use of products in specific situations ("Advice") is given by Company and is used at the Users own risk.

Watson Bowman Acme
 45 Pawnee Circle
 Andover, NY 14203
 phone: (716) 757-7888
 fax: (716) 751-6231
 www.wbcorp.com

BASF
 The Chemical Company

PROJECT: WWII VETERAN'S MEMORIAL HIGHWAY
 VT ROUTE 279, PRINCIPAL ARTERIAL
 WBA MODULAR STM-600 EXPANSION JOINT DETAILS

DATE:	12/23/09
DRAWN BY:	TPL
CHECKED BY:	TEB
SCALE:	NTS
SHEET NO.:	7 of 14
WBA JOB NO.:	126770
DRAWING NO.:	B-27574