
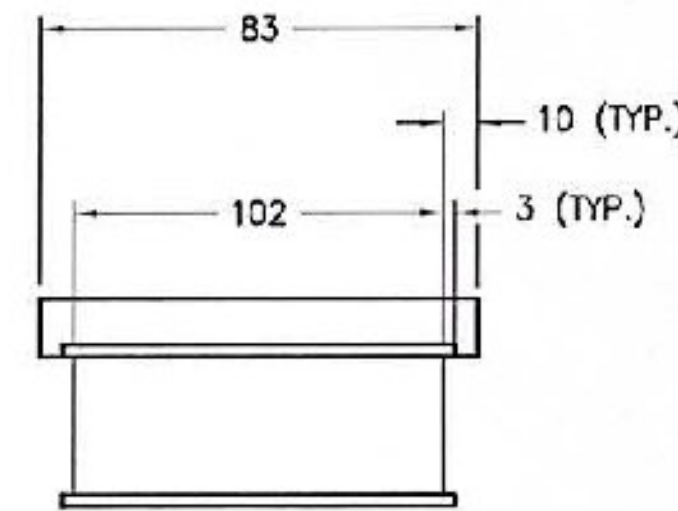


STR126770AA08 QTY: 1 REQD. **STRUCTURED BILL OF MATERIALS**

LV	PART NO.	QTY	UM	DESCRIPTION	CLASS	MATERIAL	REVISION
0	STR126770AA08	1	EA	STR-600 SUPPORT BAR (8P1) (X)		UNCOATED	
1	3733	17.10	KG	PLATE 76 A 588	B	ASTMA-588	
2	STR126770AA08A	4.00	EA	STAINLESS STEEL 12 GAGE 70 x 154 (8M1) (X)			
2	8570	0.30	KG	STNLS STL 12GA TYP304 2BFIN(A)	A		

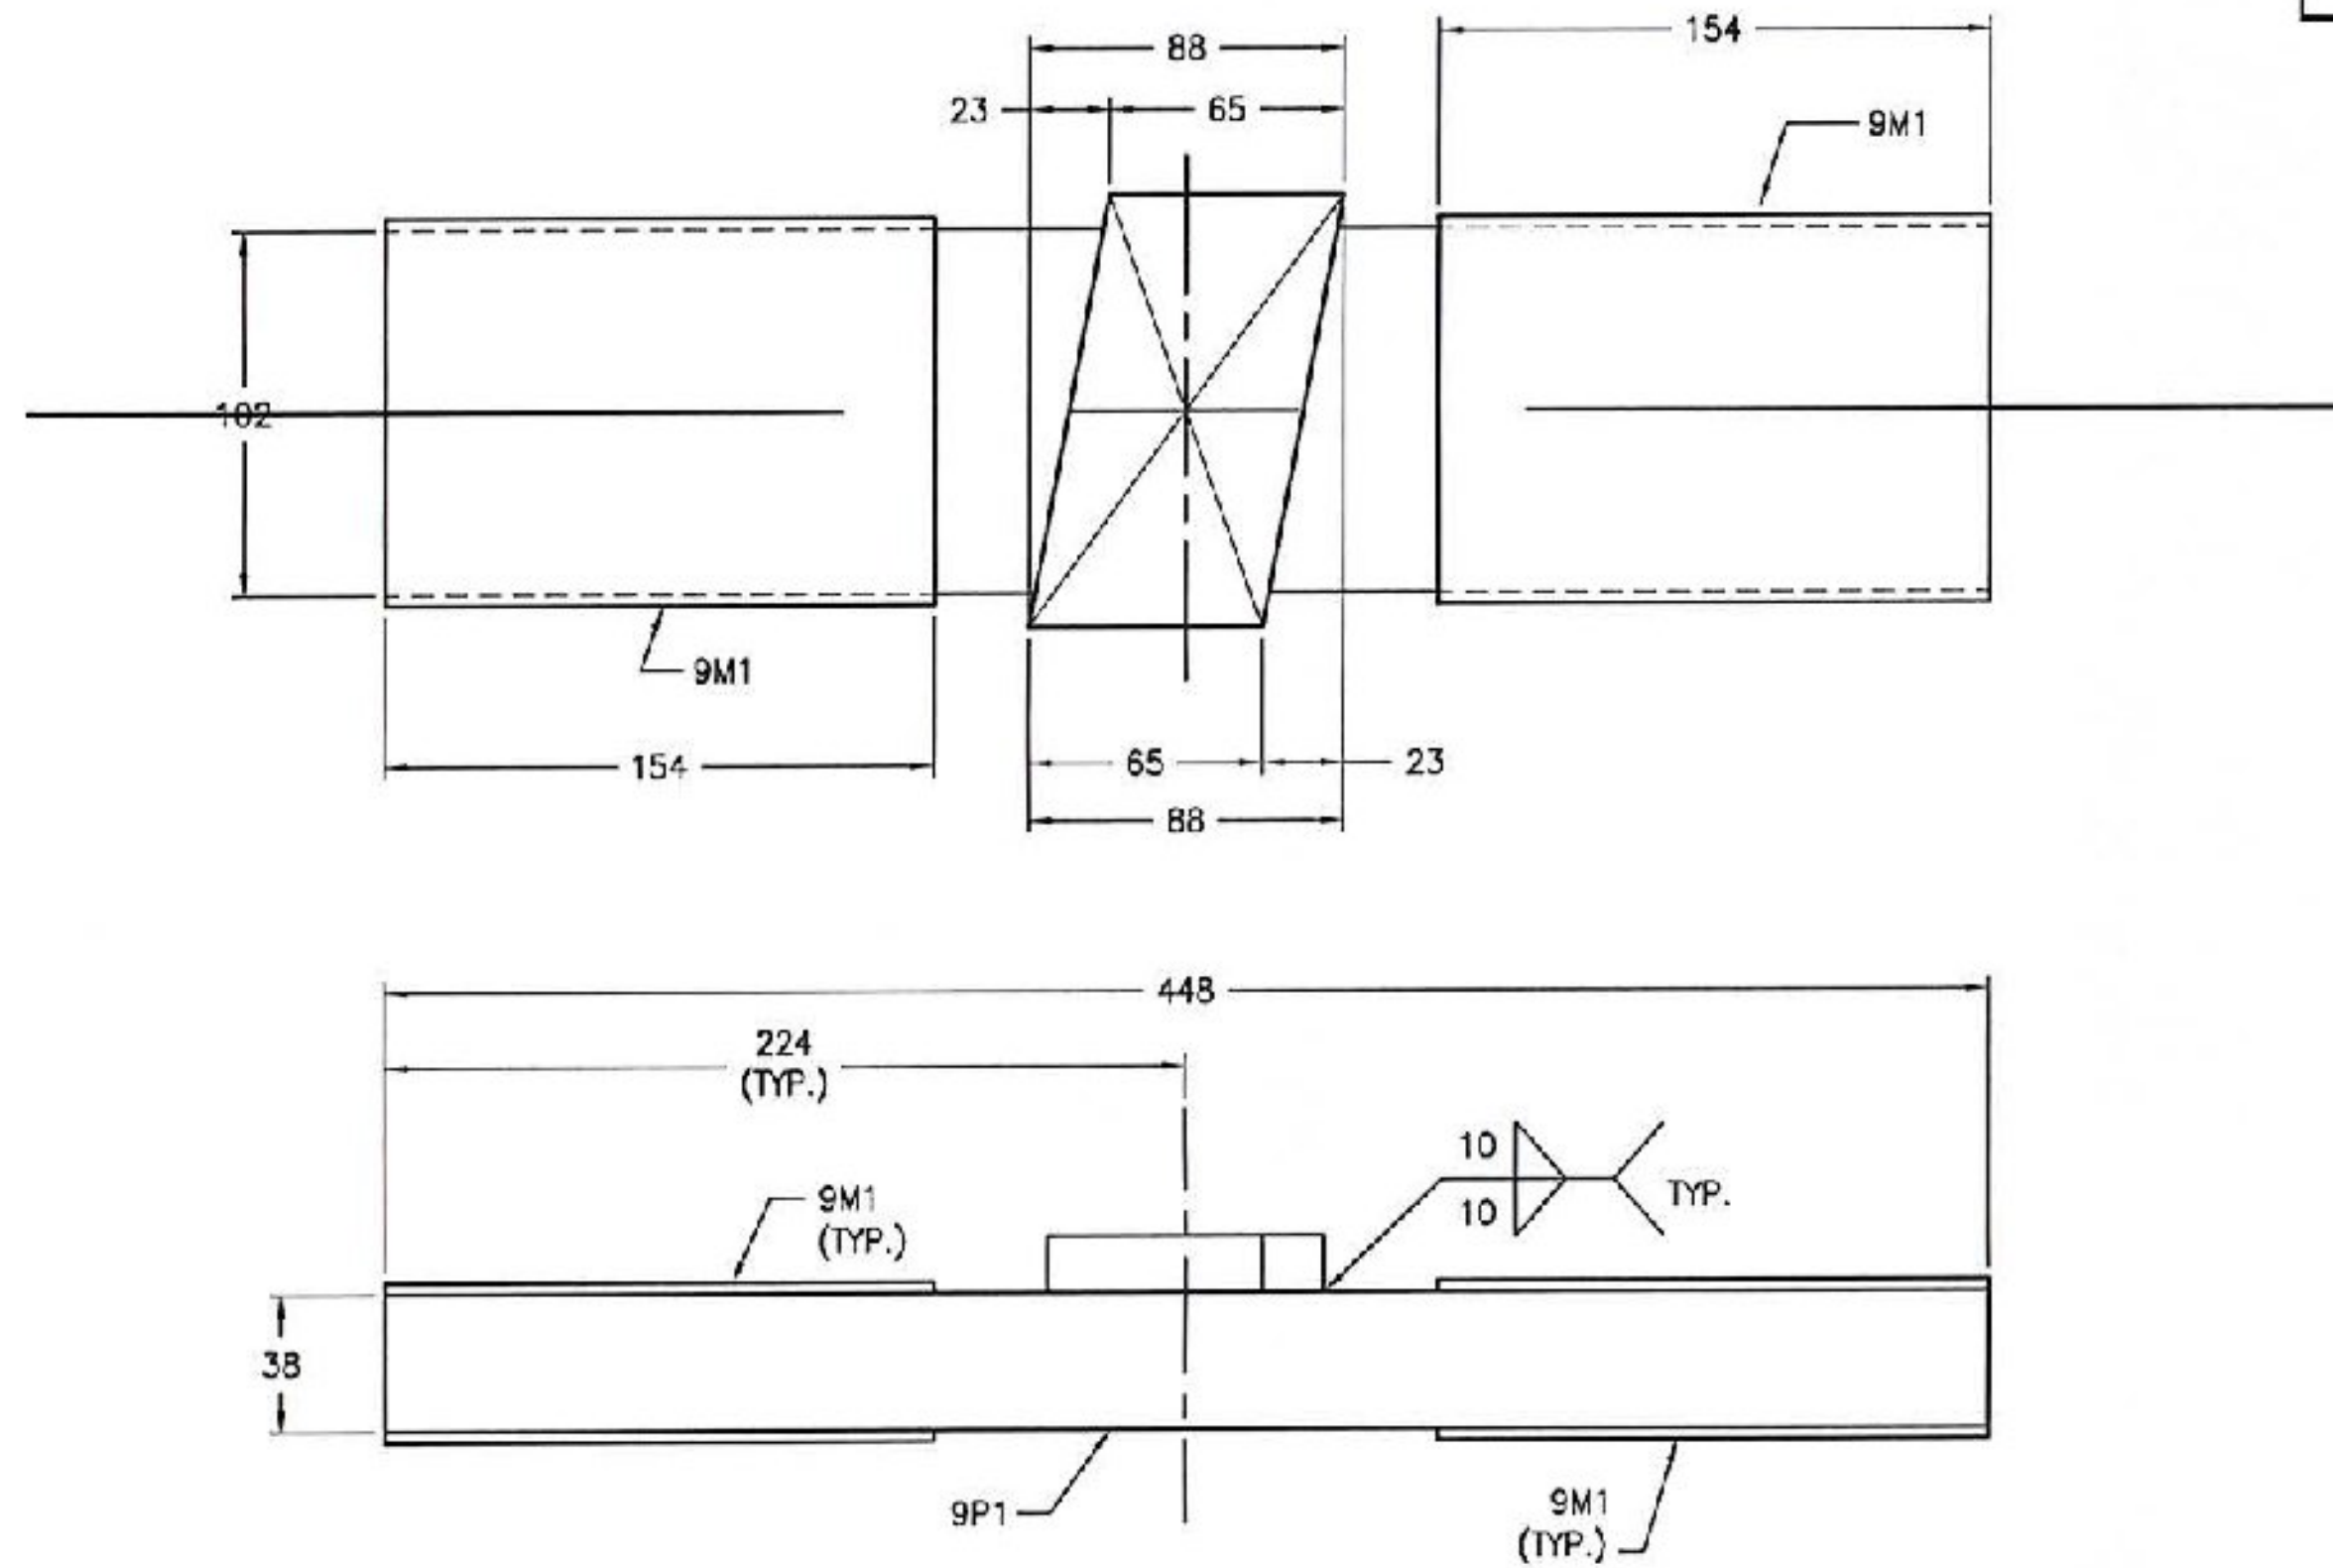

END VIEW

INSPECTION REQUIRED


TVGA CONSULTANTS

- NO EXCEPTIONS TAKEN REJECTED
 FURNISH AS CORRECTED
 REVISE AND RESUBMIT


ENGINEER has reviewed Shop Drawings and Samples and other data which Contractor is required to submit, only for conformance with the information given in the Contract Documents and compatibility with the design concept of the completed Project as a functioning whole as indicated in the Contract Documents. Such reviews do not extend to means, methods, techniques, sequences or procedures of construction or to safety precautions and programs incident thereto. Such reviews do not extend to any LEED certification or accreditation. Contractor is responsible for dimensions to be confirmed and correlated at the job site; for information that pertains solely to the fabrication processes or to techniques of construction; and for coordination of the work of all trades.

BY: *[Signature]*
DATE: 6/17/10

VERMONT AGENCY OF TRANSPORTATION
 COUNTY: BENNINGTON
 PROJECT NO.: AC NH 019-1(51)
 CAPITAL PROJECT ID NO.: -
 BRIDGE NO.: B15, B15N, B15S
 WBA PRODUCT DESCRIPTION: MODULAR
 WBA PRODUCT NO.: STM126770AA

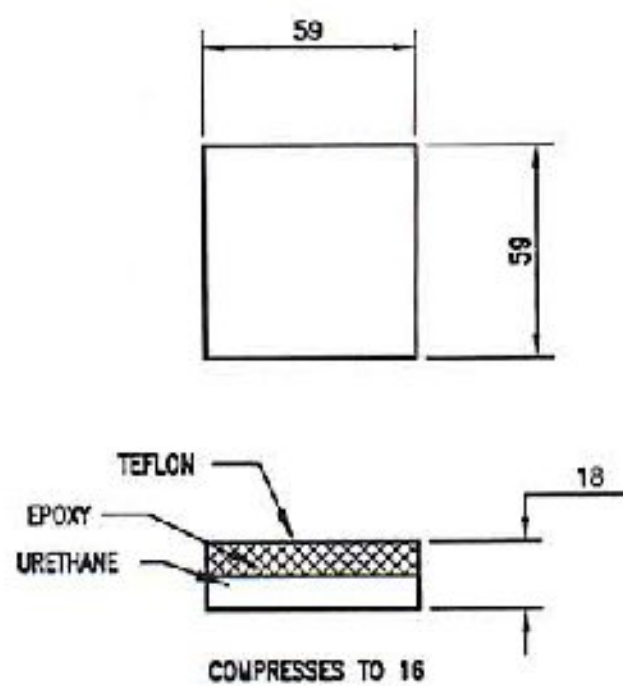

BEARING AND COMPRESSION SPRING

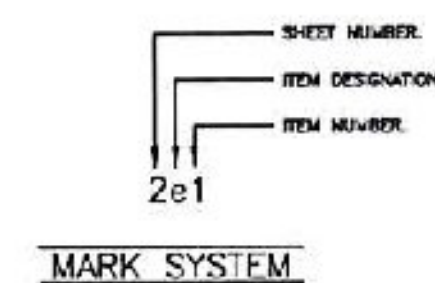

DRAWING ACTION:

SUBMITTED FOR APPROVAL

1/20/10

Information provided herein, including but not limited to any drawing, design, photograph, graphic, or statement(s) ("Materials") are proprietary and the property of Watson Bowman Acme Corporation ("Company"). Reproduction, translation, or reduction to any electronic medium or machine readable form, in whole or part, is strictly prohibited, except for the express purpose for which it has been furnished, without prior written consent of Company. All Materials contained herein are provided by Company for information purposes only. Company reserves the right to amend or withdraw any information contained in the Materials without notice. All technical or other advice by Company, whether verbal or written, concerning products, or the use of products in specific situations ("Advice") is given by Company and is used at the Users own risk.

Watson Bowman Acme
 85 Phoenix Drive
 Ashland, NH 03220
 Phone: (781) 991-7500
 Fax: (781) 991-0200
 www.wbcorp.com

BASF
 The Chemical Company

DRAWN BY:	TPL	DATE:	12/23/09
CHECKED BY:	TEB	DATE:	1/7/10
SCALE:	NTS	WORK JOB NO.:	126770
SHEET NO.:	10 of 14	DRAWING NO.:	B-27574

PROJECT: WWII VETERAN'S MEMORIAL HIGHWAY
 VT ROUTE 279, PRINCIPAL ARTERIAL
 WBA MODULAR STM-600 EXPANSION JOINT DETAILS