





16 DIA TAPERED HOLE IN SPLICE TUBE AND 29 X "C" SLOT IN RAIL TUBE FOR M16 BOLT AND PLAIN HARDENED WASHER

FOR DETAILS NOT SHOWN, SEE "RAIL TUBE SPLICE SECTION"

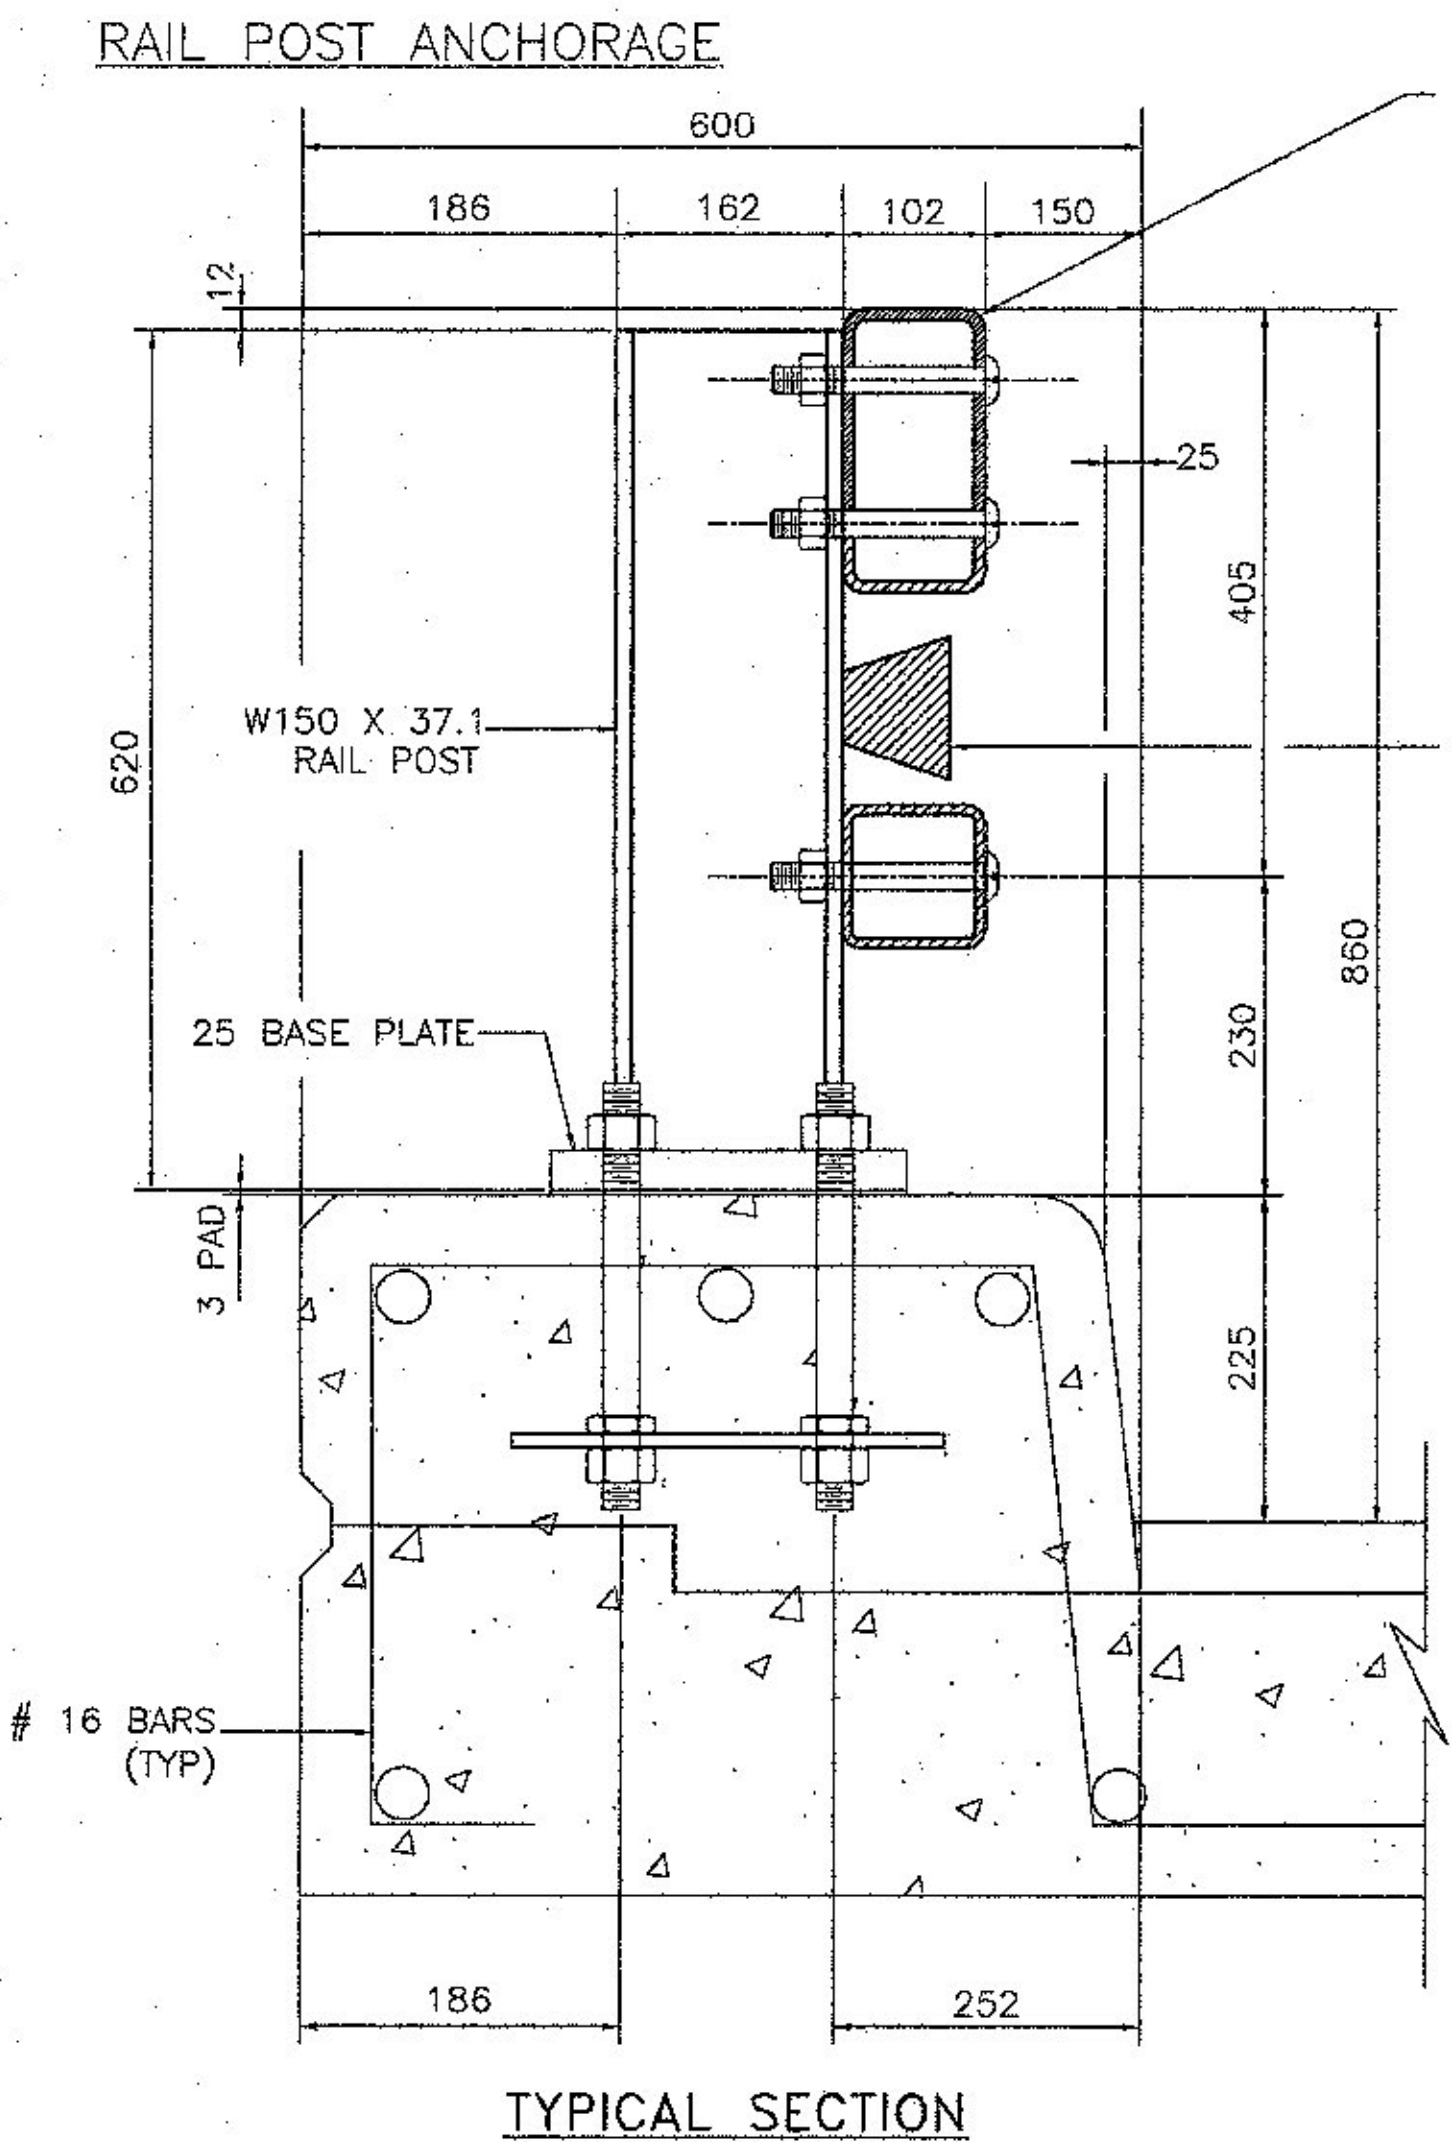



RAIL TUBES  
TS 203 X 102 X 8 (TOP)  
TS 102 X 102 X 6 (BOTTOM)

18 DIA HOLE FOR ATTACHMENT OF REFLECTOR UNITS (BY OTHERS)

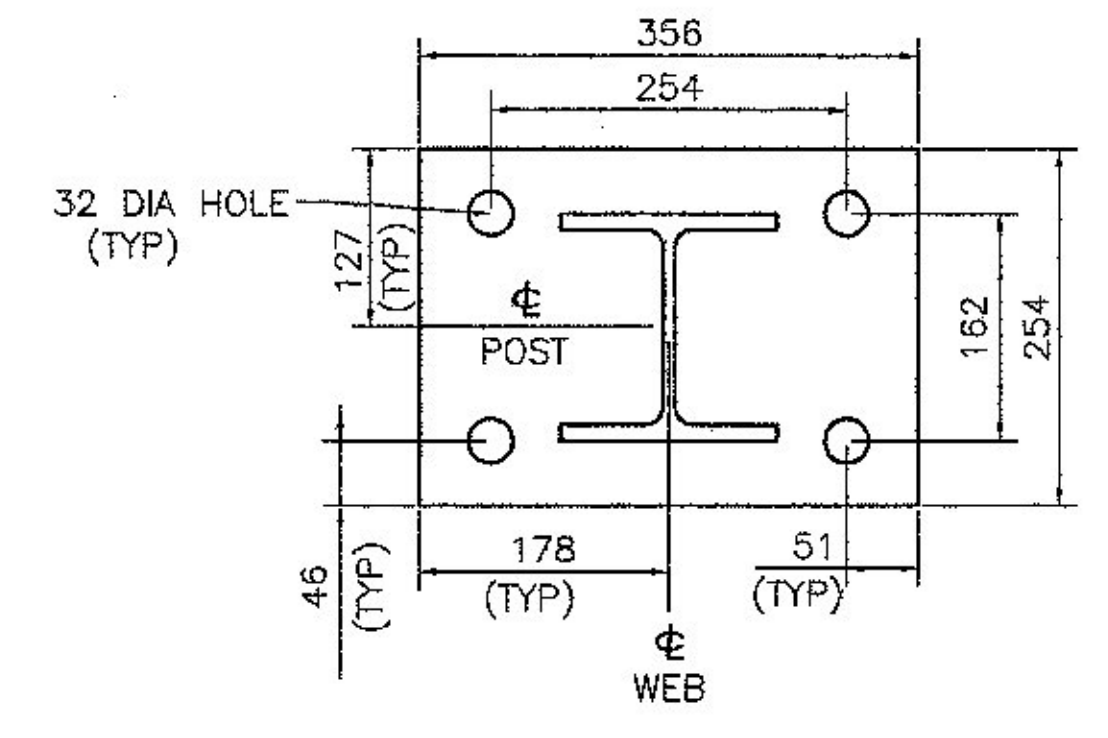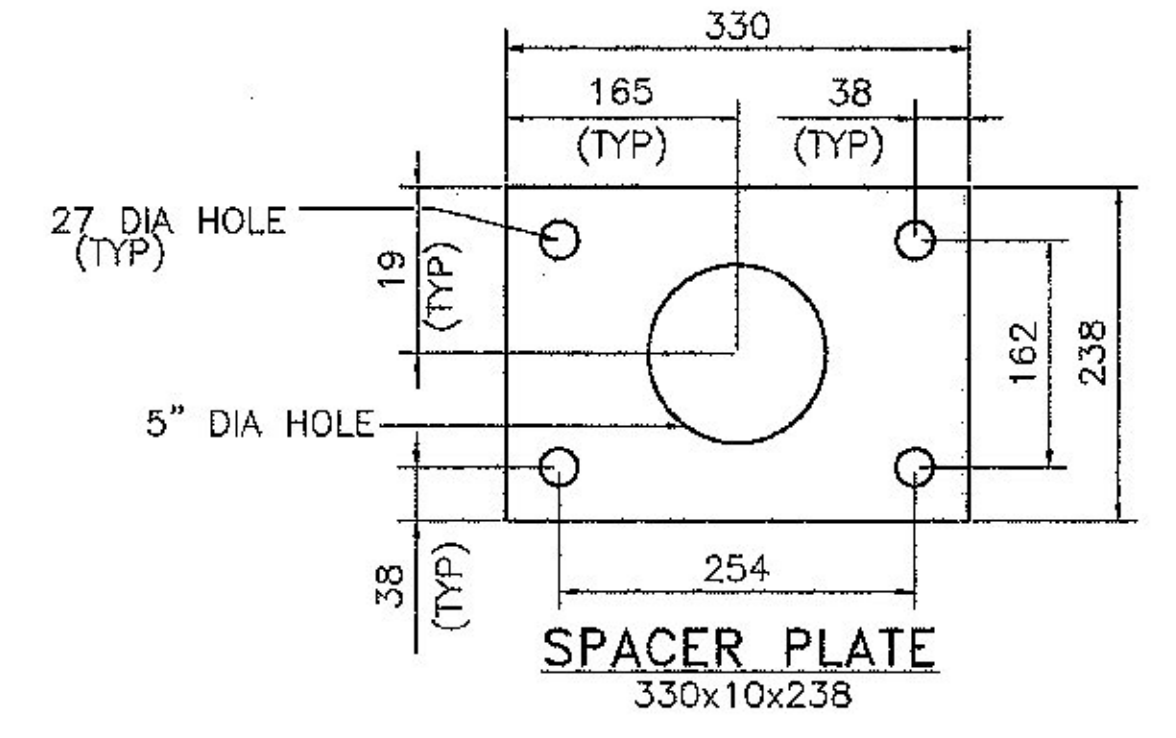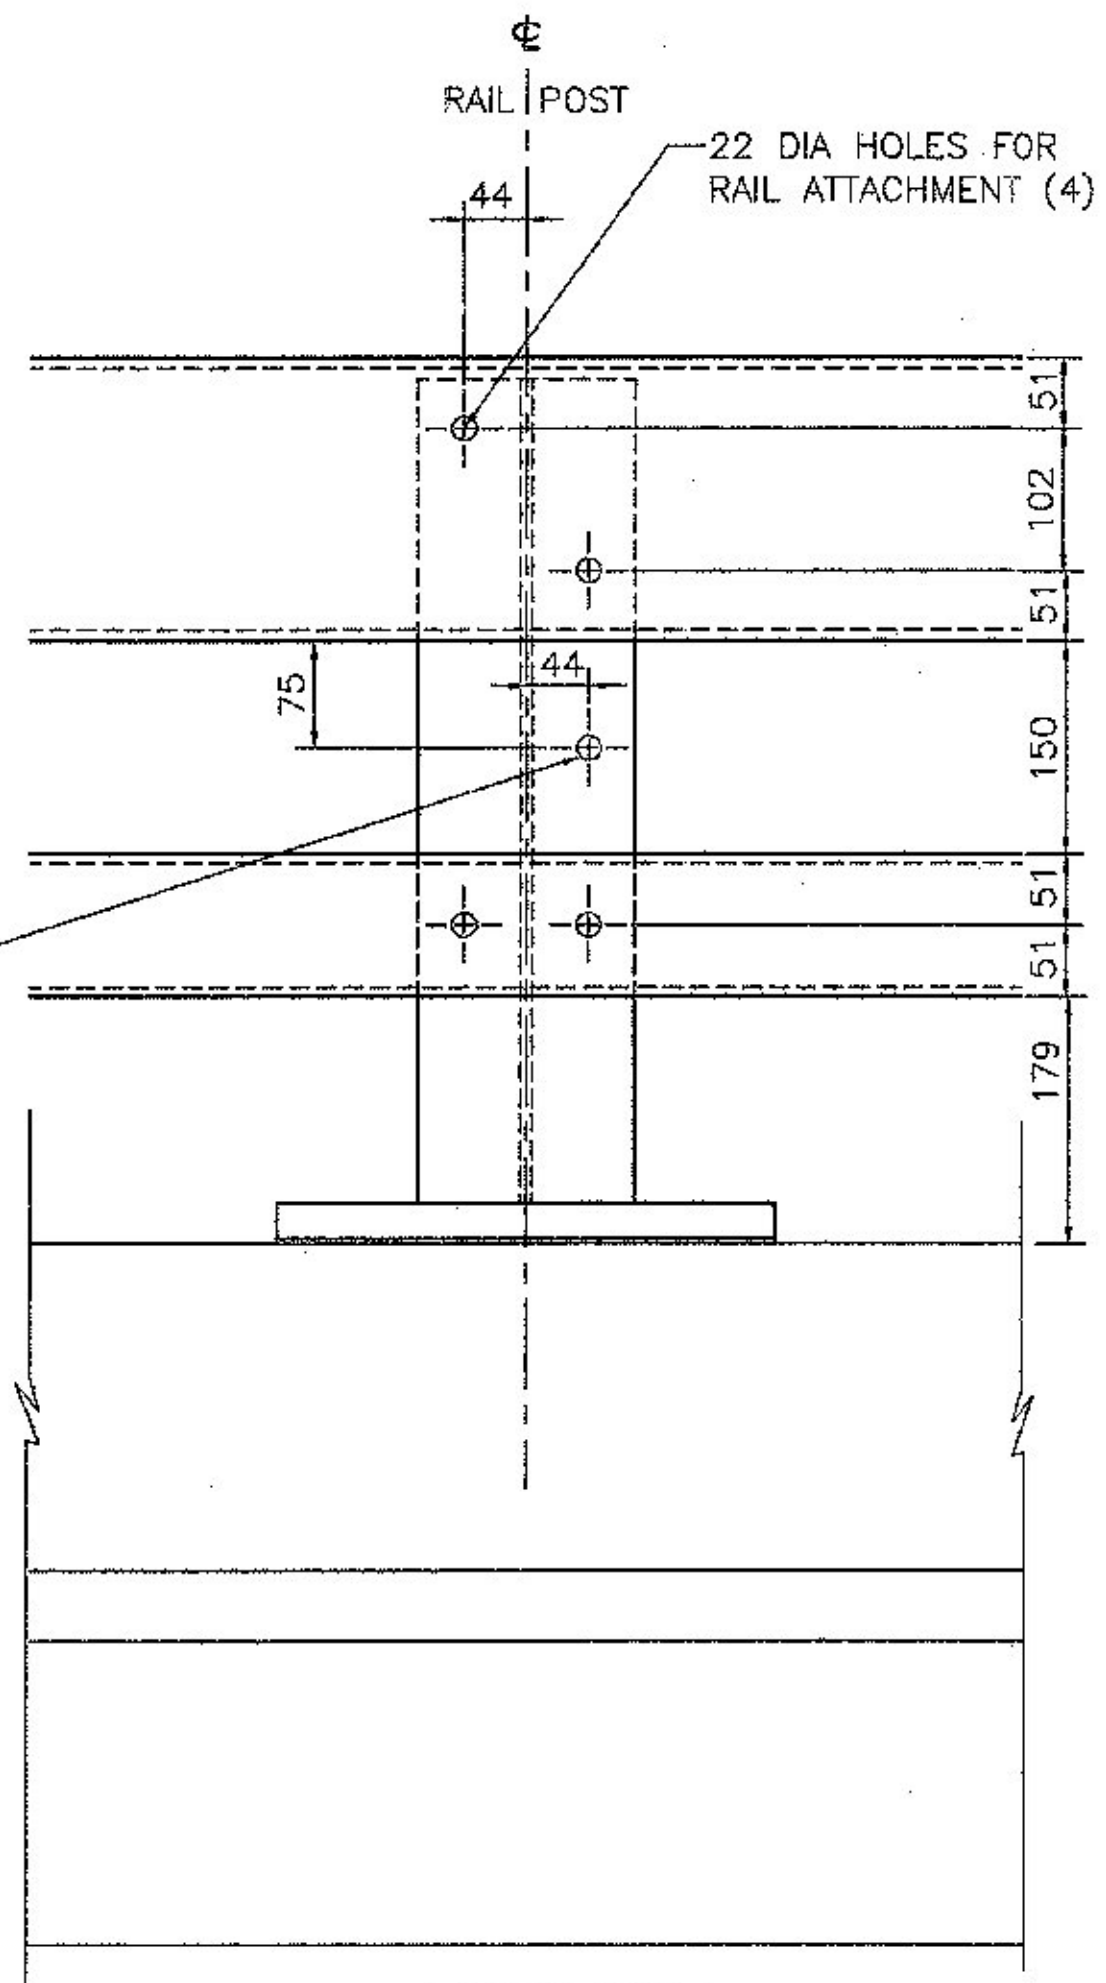

SPLICE TABLE					
T	A	B	C	L	X
NA	100	50	--	510	20
EXPANSION JOINT TABLE					
<100	100	50	85	510	65
>100 <165	140	60	90	605	105
>165 <230	165	85	230*	705	130
>230 <330	215	110	280*	860	180


T = TOTAL MOVEMENT BETWEEN BRIDGE EXPANSION JOINTS. SEE NOTE 6  
\* = SINGLE SLOT

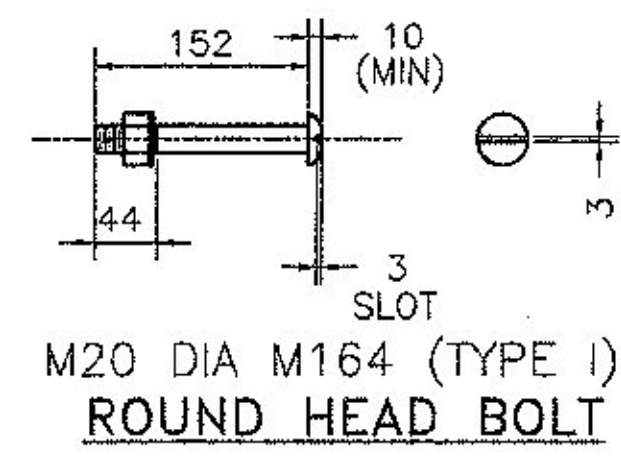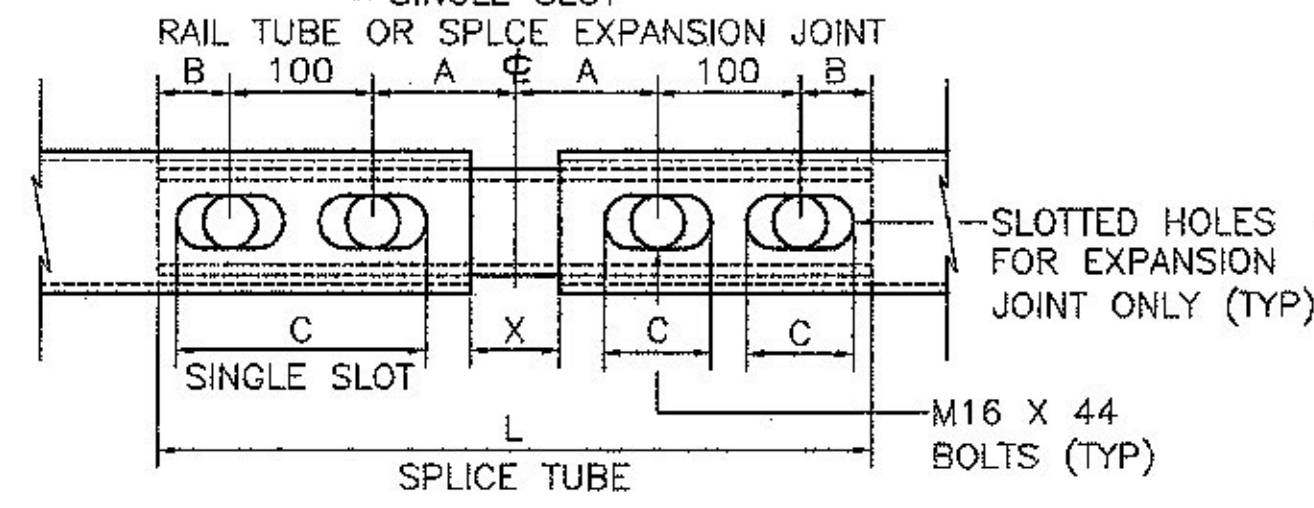

(WITH WASHER AND PREVAILING TORQUE TYPE LOCK NUT) (SEE NOTE #9)  
ONLY FULL DIAMETER BODY BOLTS WILL BE ALLOWED

- NOTES
- 1 ALL WORK AND MATERIALS SHALL CONFORM TO THE PROVISIONS OF SECTION 525 "RAILINGS OF THE STANDARD SPECIFICATION FOR CONSTRUCTION".
  - 2 TUBING AND POSTS SHALL MEET THE REQUIREMENTS OF SECTION 732, "RAILING MATERIALS OF THE STANDARD SPECIFICATIONS FOR CONSTRUCTION" EXCEPT THE DROP WEIGHT TEAR TEST IN SECTION 732 SHALL NOT APPLY TO THE STRUCTURAL TUBING IN THIS STANDARD.
  - 3 ALL EXPOSED CUT OR SHEARED EDGES SHALL BE ROUNDED TO A 2mm RADIUS AND BE FREE OF BURRS.
  - 4 RAIL POSTS SHALL BE SET NORMAL TO GRADE.
  - 5 SECTIONS OF RAIL TUBE SHALL BE ATTACHED TO A MINIMUM OF TWO (2) RAIL POSTS AND PREFERABLY TO AT LEAST FOUR (4) POSTS.
  - 6 RAIL TUBE EXPANSION JOINTS SHALL BE PROVIDED IN ANY RAIL BAY SPANNING A SUPERSTRUCTURE EXPANSION JOINT. EXPANSION JOINT WIDTH SHALL BE "X" AT 7°C AND WILL BE ADJUSTED IN THE FIELD BY THE ENGINEER FOR OTHER TEMPERATURES.
  - 7 ALL PARTS SHALL BE GALVANIZED AFTER FABRICATION IN ACCORDANCE WITH AASHTO M311, EXCEPT THAT HARDWARE SHALL MEET THE REQUIREMENTS OF AASHTO M232.
  - 8 RAIL POSTS ANCHORING NUTS SHALL BE TIGHTENED TO A SNUG FIT AND GIVEN AN ADDITIONAL ONE-EIGHTH TURN.
  - 9 RAIL TUBES SHALL BE ATTACHED USING M20 FULL DIAMETER BODY AASHTO M164 (TYPE 1) ROUND HEAD BOLTS INSERTED THROUGH THE FACE OF THE TUBE. HOLES IN POSTS SHALL BE 2mm LARGER THAN THE BOLT SIZE.
  - 10 HOLES IN RAILS FOR RAIL TUBE ATTACHMENT MAY BE FIELD DRILLED. HOLES SHALL BE COATED WITH AN APPROVED ZINC RICH PAINT PRIOR TO ERECTION.
  - 11 IF THERE IS A CONFLICT BETWEEN THESE STANDARD DETAILS AND THE DESIGN, THE REQUIREMENTS OF THE DESIGN DRAWING SHALL BE FOLLOWED.
  - 12 ANY BENDING OF RAIL SHALL BE DONE BY SHOP PROCEDURE ONLY.
  - 13 THE FABRICATOR SHALL SUBMIT SHOP DRAWINGS INCLUDING WELDING PROCEDURES TO THE STRUCTURES SECTION FOR APPROVAL IN ACCORDANCE WITH THE PROVISION OF 506.04, SHOP DRAWINGS. ALL WELDING SHALL CONFORM WITH SECTION 506.10.
  - 14 RAIL POSTS AND BASE PLATES SHALL BE TESTED FOR IMPACT PROPERTIES IN ACCORDANCE WITH ASTM A-370 CHARPY IMPACT TESTING USING TYPE "A" SPECIMEN.

- MATERIALS
- RAIL TUBES.....ASTM A500, GRADE B OR ASTM A501
  - RAIL POSTS AND BASE PLATES.....ASTM A709/A709M, GRADE 345
  - ALL OTHER SHAPES AND PLATES.....ASTM A709/A709M, GRADE 250
  - ANCHOR STUDS.....ASTM F568M CLASS 8.8
  - ALL OTHER BOLTS (UNLESS NOTED).....AASHTO M164M, TYPE 1
- NUTS FOR AASHTO M164M (ASTM A325M) BOLTS AND FOR ANCHOR STUDS SHALL COMPLY WITH AASHTO M291M (ASTM A563M)
- WASHERS SHALL COMPLY WITH AASHTO M293M (ASTM F436M) SPECIFICATIONS
- 3mm PAD SHALL COMPLY WITH STANDARD SPECIFICATION SUBSECTION 731.01 OR 731.02

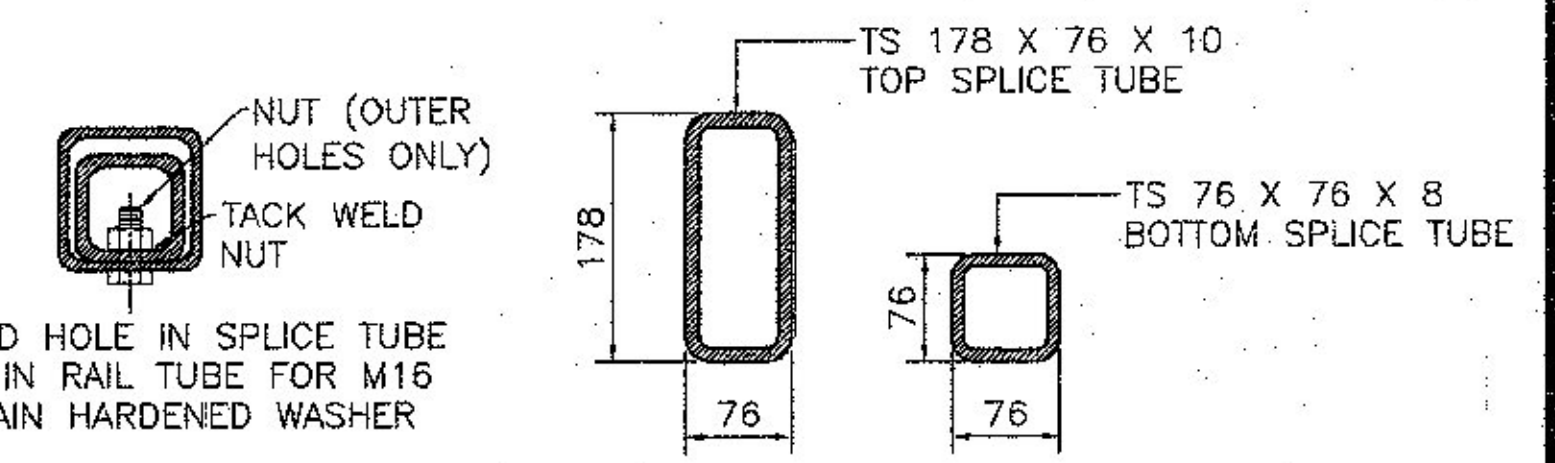

REVISIONS		
No.	Remarks	Date

TVGA CONSULTANTS

NO EXCEPTIONS TAKEN  REJECTED

PURNISH AS CORRECTED

REVISE AND RESUBMIT

ENGINEER has reviewed Shop Drawings and Standards and other data which Contractor is required to furnish, and has approved same, and certifies that the design complies with the Contract Documents and Specifications. Such approval does not extend to materials, methods, workmanship or performance of construction or to safety precautions and programs which are the responsibility of the Contractor. Contractor is responsible for continuing to provide shop drawings and specifications for construction that are complete and controlled in the field for information that is consistent with the construction processes or to facilitate construction, and for coordination of the work of all trades.

BY: *JSM*

DATE: 11-11-10

**HIGHWAY SAFETY CORP**

GLASTONBURY, CT  
860-633-9445

ITEM 525.33 BRIDGE RAILING - NETC 2 RAIL  
TOWN OF BENNINGTON  
COUNTY OF BENNINGTON  
PROJ. AC NH 019-1(51) BRIDGE B15N/S  
VT ROUTE 279 OVER ROARING BRANCH

CERTIFIED FABRICATOR!

NO. JOB NO. 1730

SHEET NO. 3 of 4

SUB CONTRACTOR: F.R. LAFAYETTE, INC.

DATE: 11/16/2009

SCALE: NONE

SIZE: D