
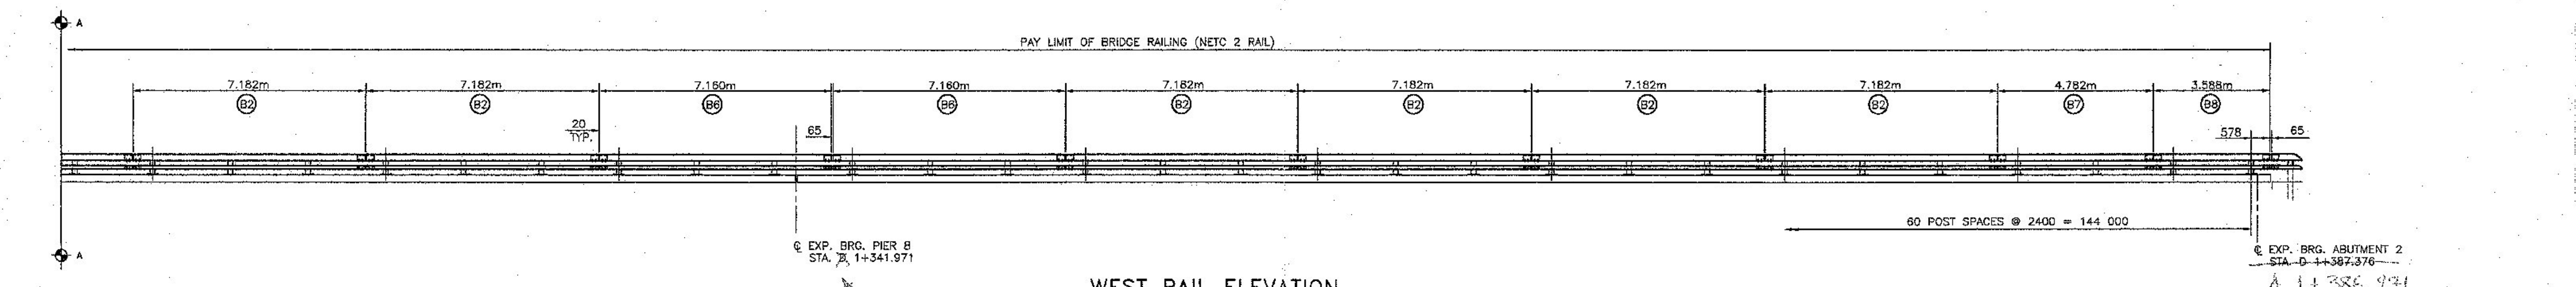


BILL OF MATERIAL FOR BRIDGE B155 (EAST & WEST)					
Mark #	Qty.	Description	Size/Shape	Unit	Material
122		W150x37.1 POST W/BASEPLATE 620 OAL			
122		POST UPRIGHT	W150 x 37	695	A709M Gr. 345
122		POST BASE PLATE	254 x 25	356	A709M Gr. 345
122		BEARING PAD	254 x 3	356	NEOPRENE
B1	2	TS 203 x 102 x 8 TOP RAIL		7.150m	A500 Gr. B
	2	TS 102 x 102 x 6 BOTTOM RAIL		7.150m	A500 Gr. B
B2	26	TS 203 x 102 x 8 TOP RAIL		7.182m	A500 Gr. B
	26	TS 102 x 102 x 6 BOTTOM RAIL		7.182m	A500 Gr. B
B3	2	TS 203 x 102 x 8 TOP RAIL		6.020m	A500 Gr. B
	2	TS 102 x 102 x 6 BOTTOM RAIL		6.020m	A500 Gr. B
B4	2	TS 203 x 102 x 8 TOP RAIL		5.944m	A500 Gr. B
	2	TS 102 x 102 x 6 BOTTOM RAIL		5.944m	A500 Gr. B
B5	4	TS 203 x 102 x 8 TOP RAIL		4.782m	A500 Gr. B
	4	TS 102 x 102 x 6 BOTTOM RAIL		4.782m	A500 Gr. B
B6	4	TS 203 x 102 x 8 TOP RAIL		7.182m	A500 Gr. B
	4	TS 102 x 102 x 6 BOTTOM RAIL		7.182m	A500 Gr. B
B7	2	TS 203 x 102 x 8 TOP RAIL		4.782m	A500 Gr. B
	2	TS 102 x 102 x 6 BOTTOM RAIL		4.782m	A500 Gr. B
B8	2	TS 203 x 102 x 8 TOP RAIL		3.588m	A500 Gr. B
	2	TS 102 x 102 x 6 BOTTOM RAIL		3.588m	A500 Gr. B
42		TS 178 x 76 x 10 SPLICE TUBE		510	A500 Gr. B
42		TS 76 x 76 x 8 SPLICE TUBE		510	A500 Gr. B
488		M24 ANCHOR STUD		305	A449
488		M24 WASHER			F436M
1464		M24 HEX NUTS			A563 DH
488		M20 ROUND HEAD BOLT		152	M164M
488		M20 HEX NUT			A563 DH
488		M20 WASHER			F436M
336		M16 SPLICE BOLT		44	A325M
336		M16 PLAIN HARDENED WASHER			F436M
168		M16 NUT WELDED TO SPLICE TUBE			A563M
32		DN 20 SCH. 40 PIPE SPACER		13	A53 Gr. B
122		SPACER PLATE	238 x 10	330	A709M GR. 36

NOTE:  
1. DIMENSIONS ARE IN MM UNLESS NOTED OTHERWISE.

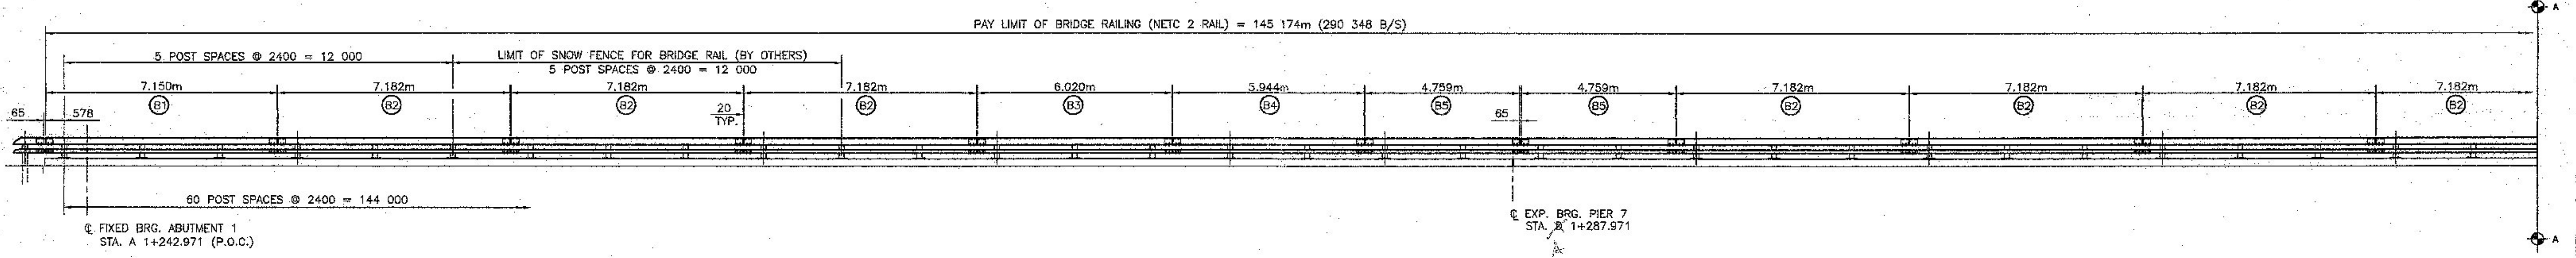

WEST RAIL ELEVATION  
LOOKING WEST FROM Q OF ROAD  
EAST SIDE SIMILAR  
BRIDGE NO. B155

REVISIONS		
No.	Remarks	Date

TVGA CONSULTANTS  
 NO EXCEPTIONS TAKEN  
 FURNISH AS CORRECTED  
 REVISE AND RESUBMIT  
 REJECT  
 REVISIONS: 1  
 DATE: 11/16/2009

**HIGHWAY SAFETY CORP**  
 GLASTONBURY, CT  
 860-633-9445

ITEM 525.33 BRIDGE RAILING - NETC 2 RAIL  
 TOWN OF BENNINGTON  
 COUNTY OF BENNINGTON  
 PROJECT AC NH 019-1(51) BRIDGE B155  
 VT ROUTE 279 OVER ROARING BRANCH

CERTIFIED FABRICATOR

GENERAL CONTRACTOR: F.R. LAFAYETTE, INC.  
 SHEET NO.: 1730  
 1 of 4  
 DATE: 11/16/2009  
 SCALE: NONE  
 SIZE: D