


DIMENSIONS SHOWN [] ARE IN MILLIMETER UNLESS OTHERWISE NOTED.

REVISIONS		
No.	Remarks	Date
0	Initial submittal	

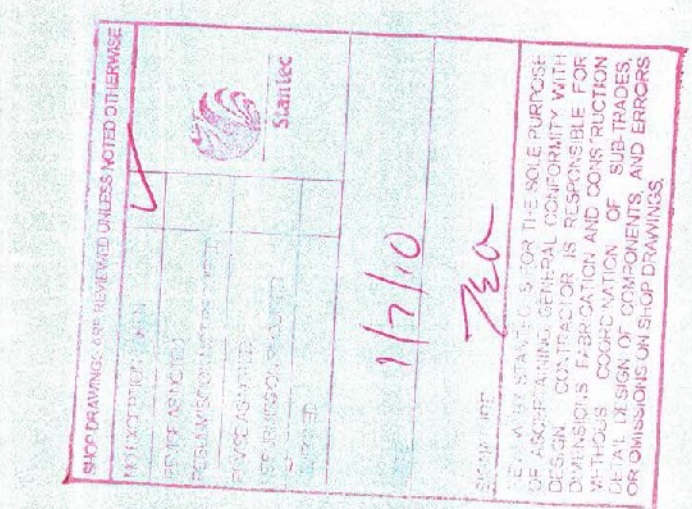

HIGHWAY SAFETY CORP.
GLASTONBURY, CT

OVERHEAD SIGN STRUCTURE NB 8+992.0
WWII VETERANS MEMORIAL HIGHWAY
COUNTY OF BENNINGTON
VT ROUTE 279, PRINCIPAL ARTERIAL
BENNINGTON AC NH 019-1(51)

DRAWN	MHM
CHECKED	
DATE	10/1/09
SCALE	N.T.S.
HSC REFERENCE NO.	1724a
SIZE	D REVISION 0
SHEET NO.	2 of 5

GENERAL CONTRACTOR
SUB CONTRACTOR F.R. LAFAYETTE