



TRUSS CONNECTION DETAIL

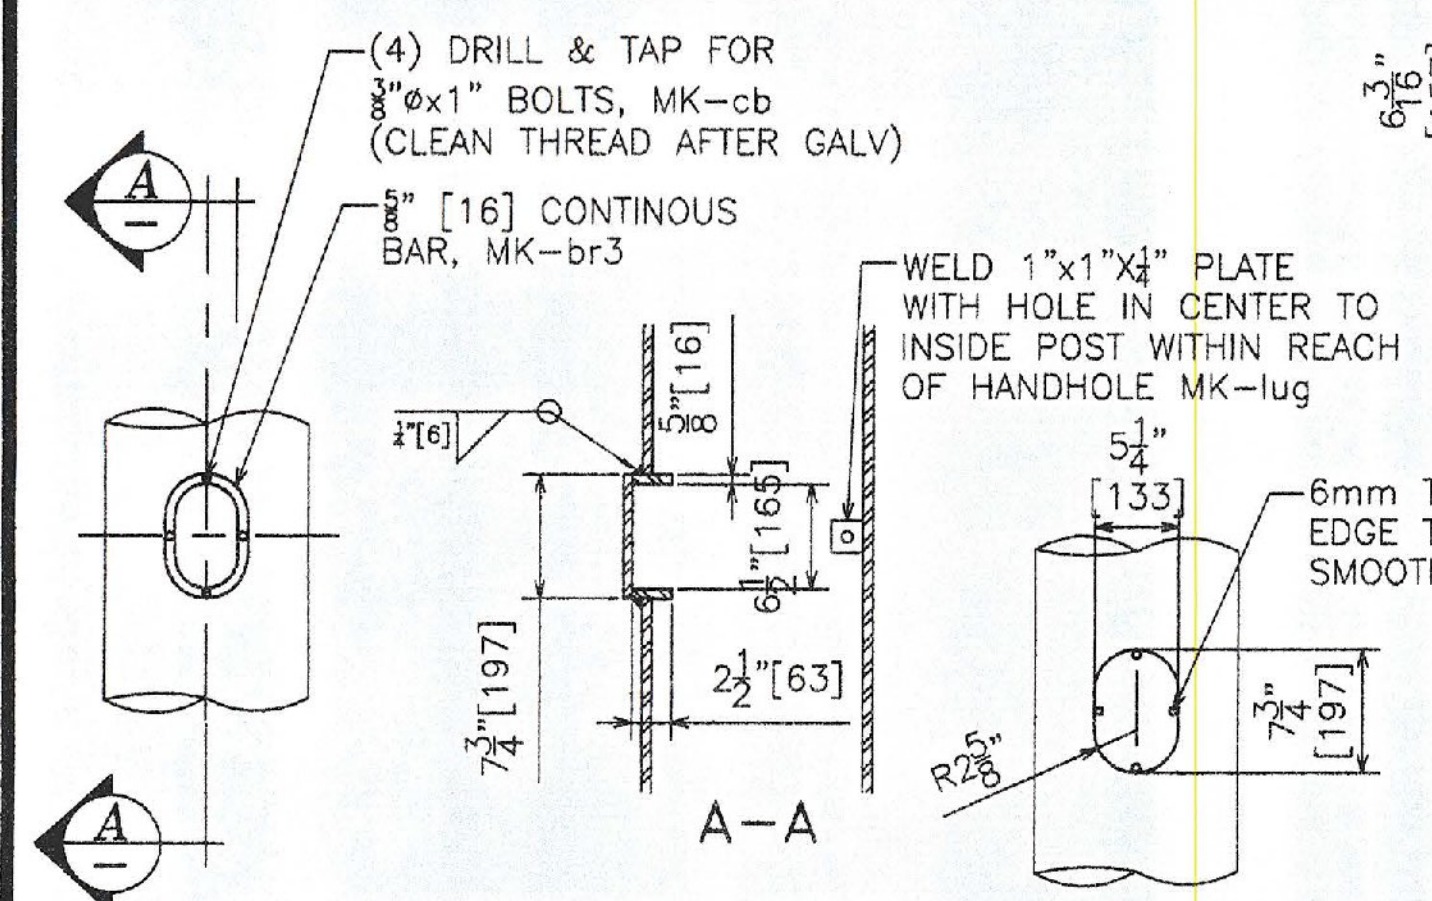

POST HANDHOLE DETAIL

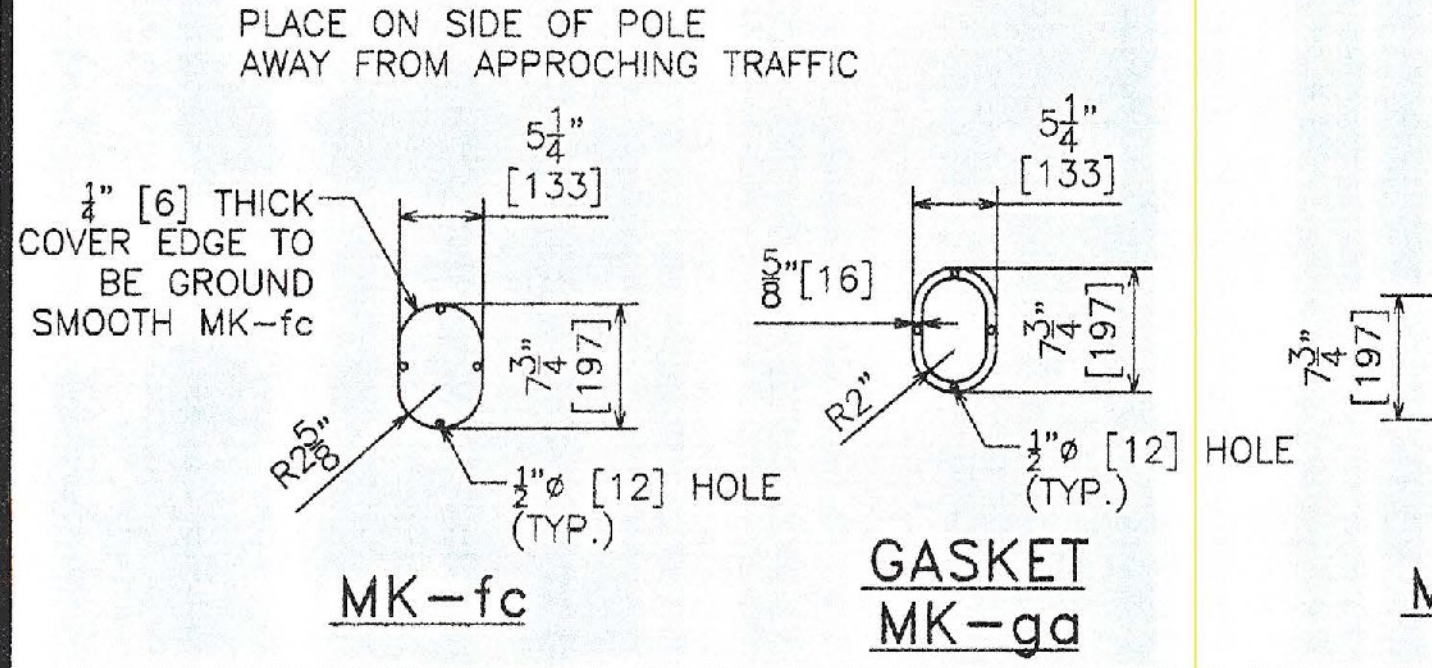

GASKET MK-ga

MK-br3

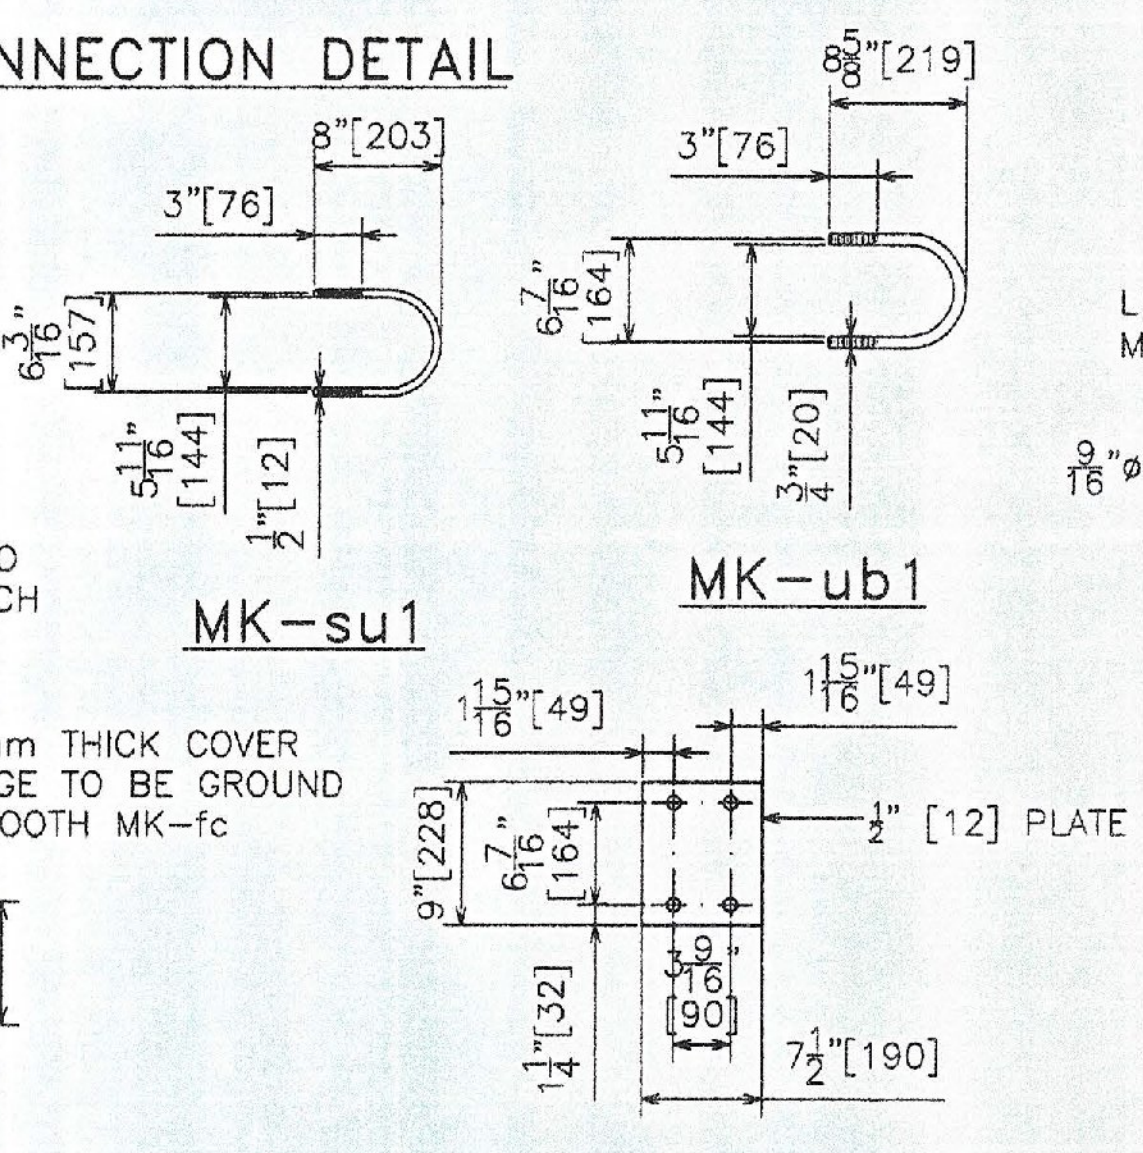


PLATE MK-co1



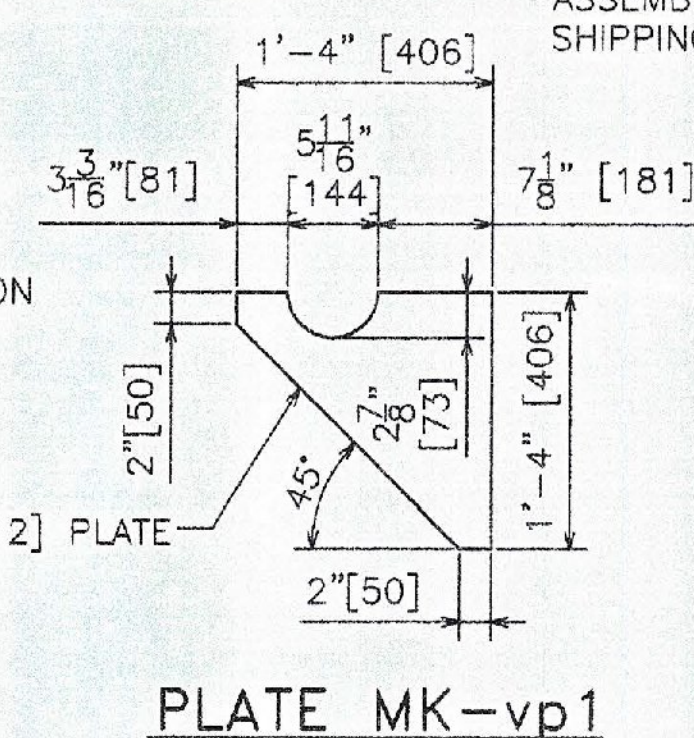


PLATE MK-vp1

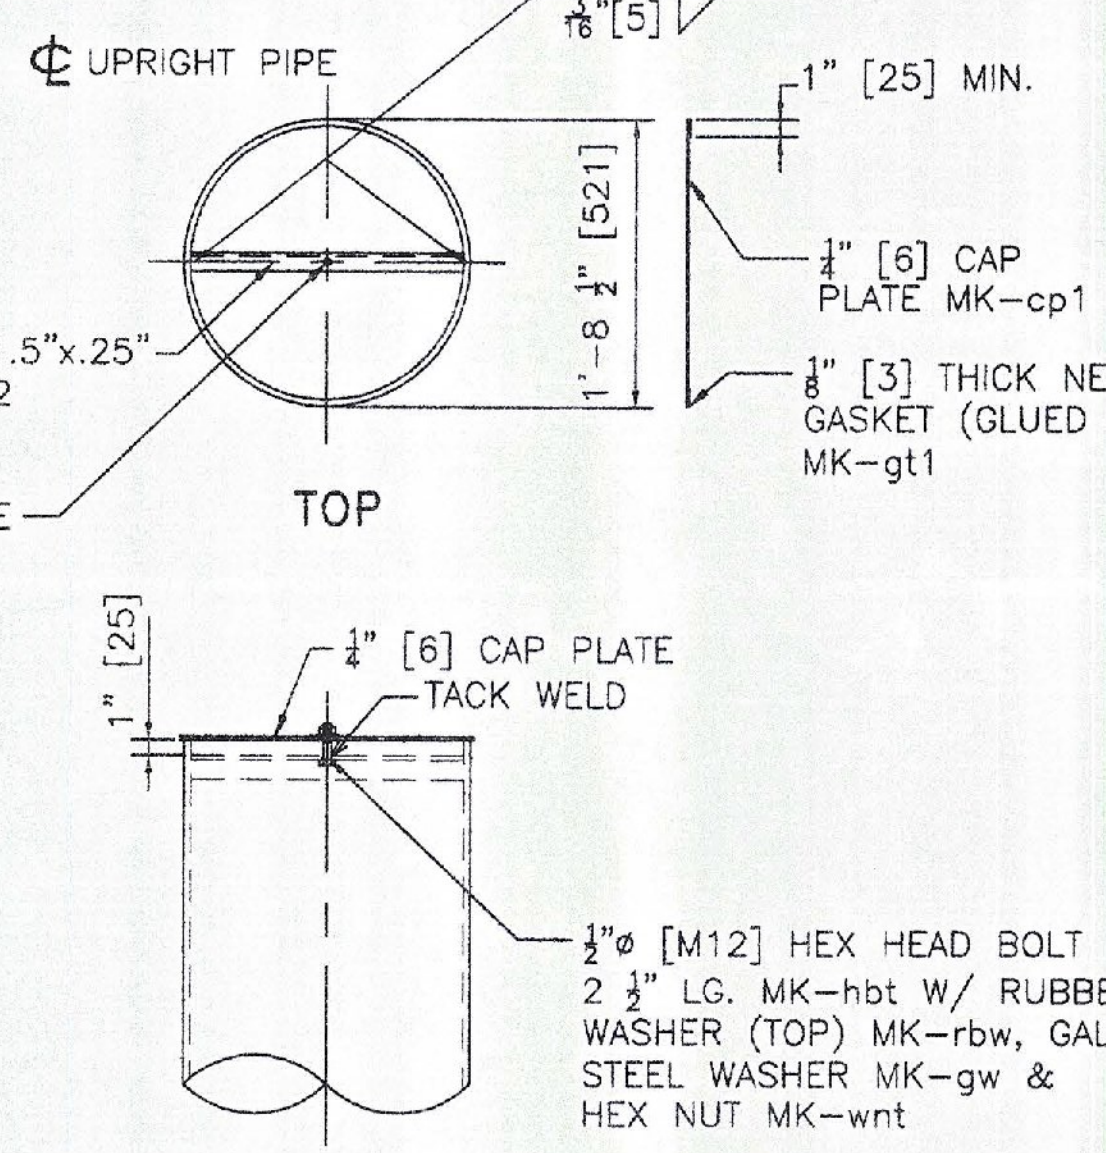


UPRIGHT CAP DETAIL

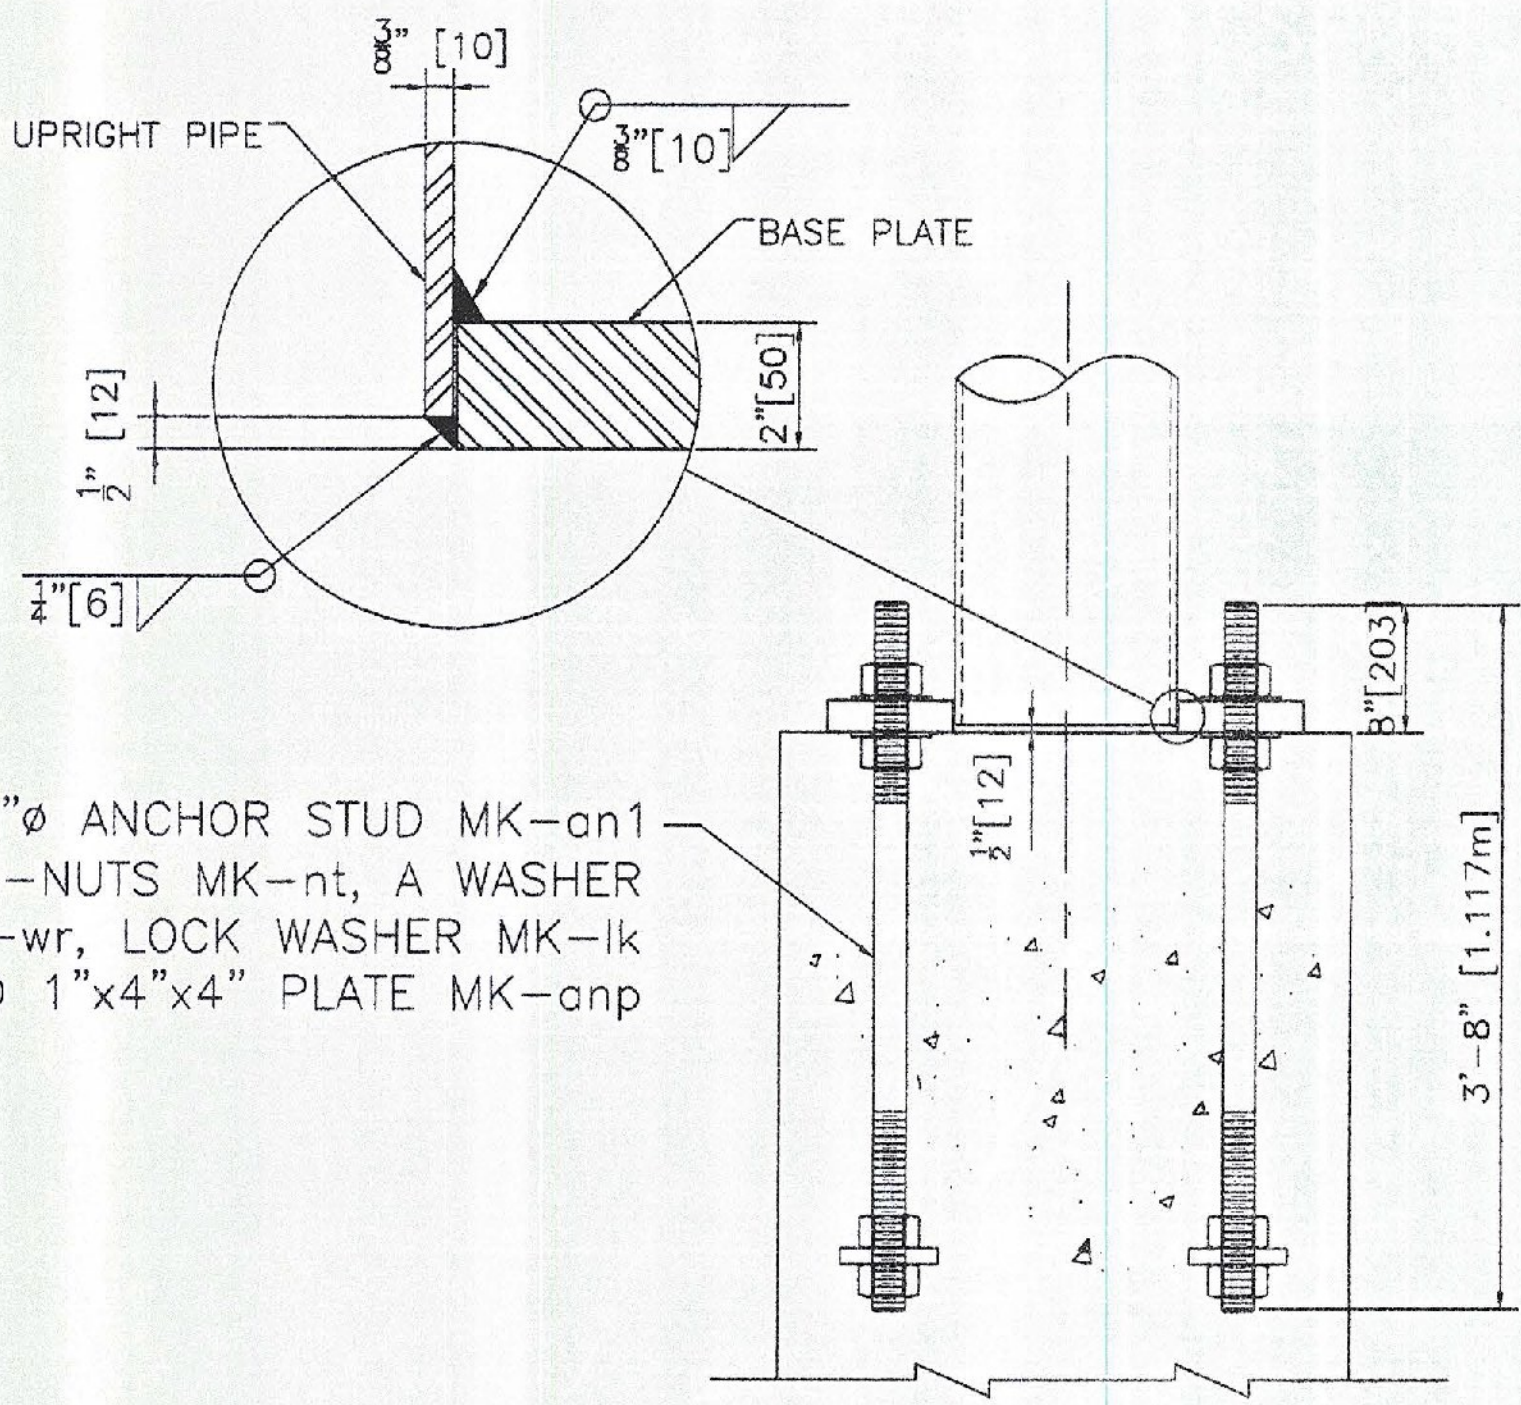


ANCHORAGE ASSEMBLY

(8) 2"Ø ANCHOR STUD MK-on1 W/4-NUTS MK-nt, A WASHER MK-wr, LOCK WASHER MK-ik AND 1"x4"x4" PLATE MK-anp

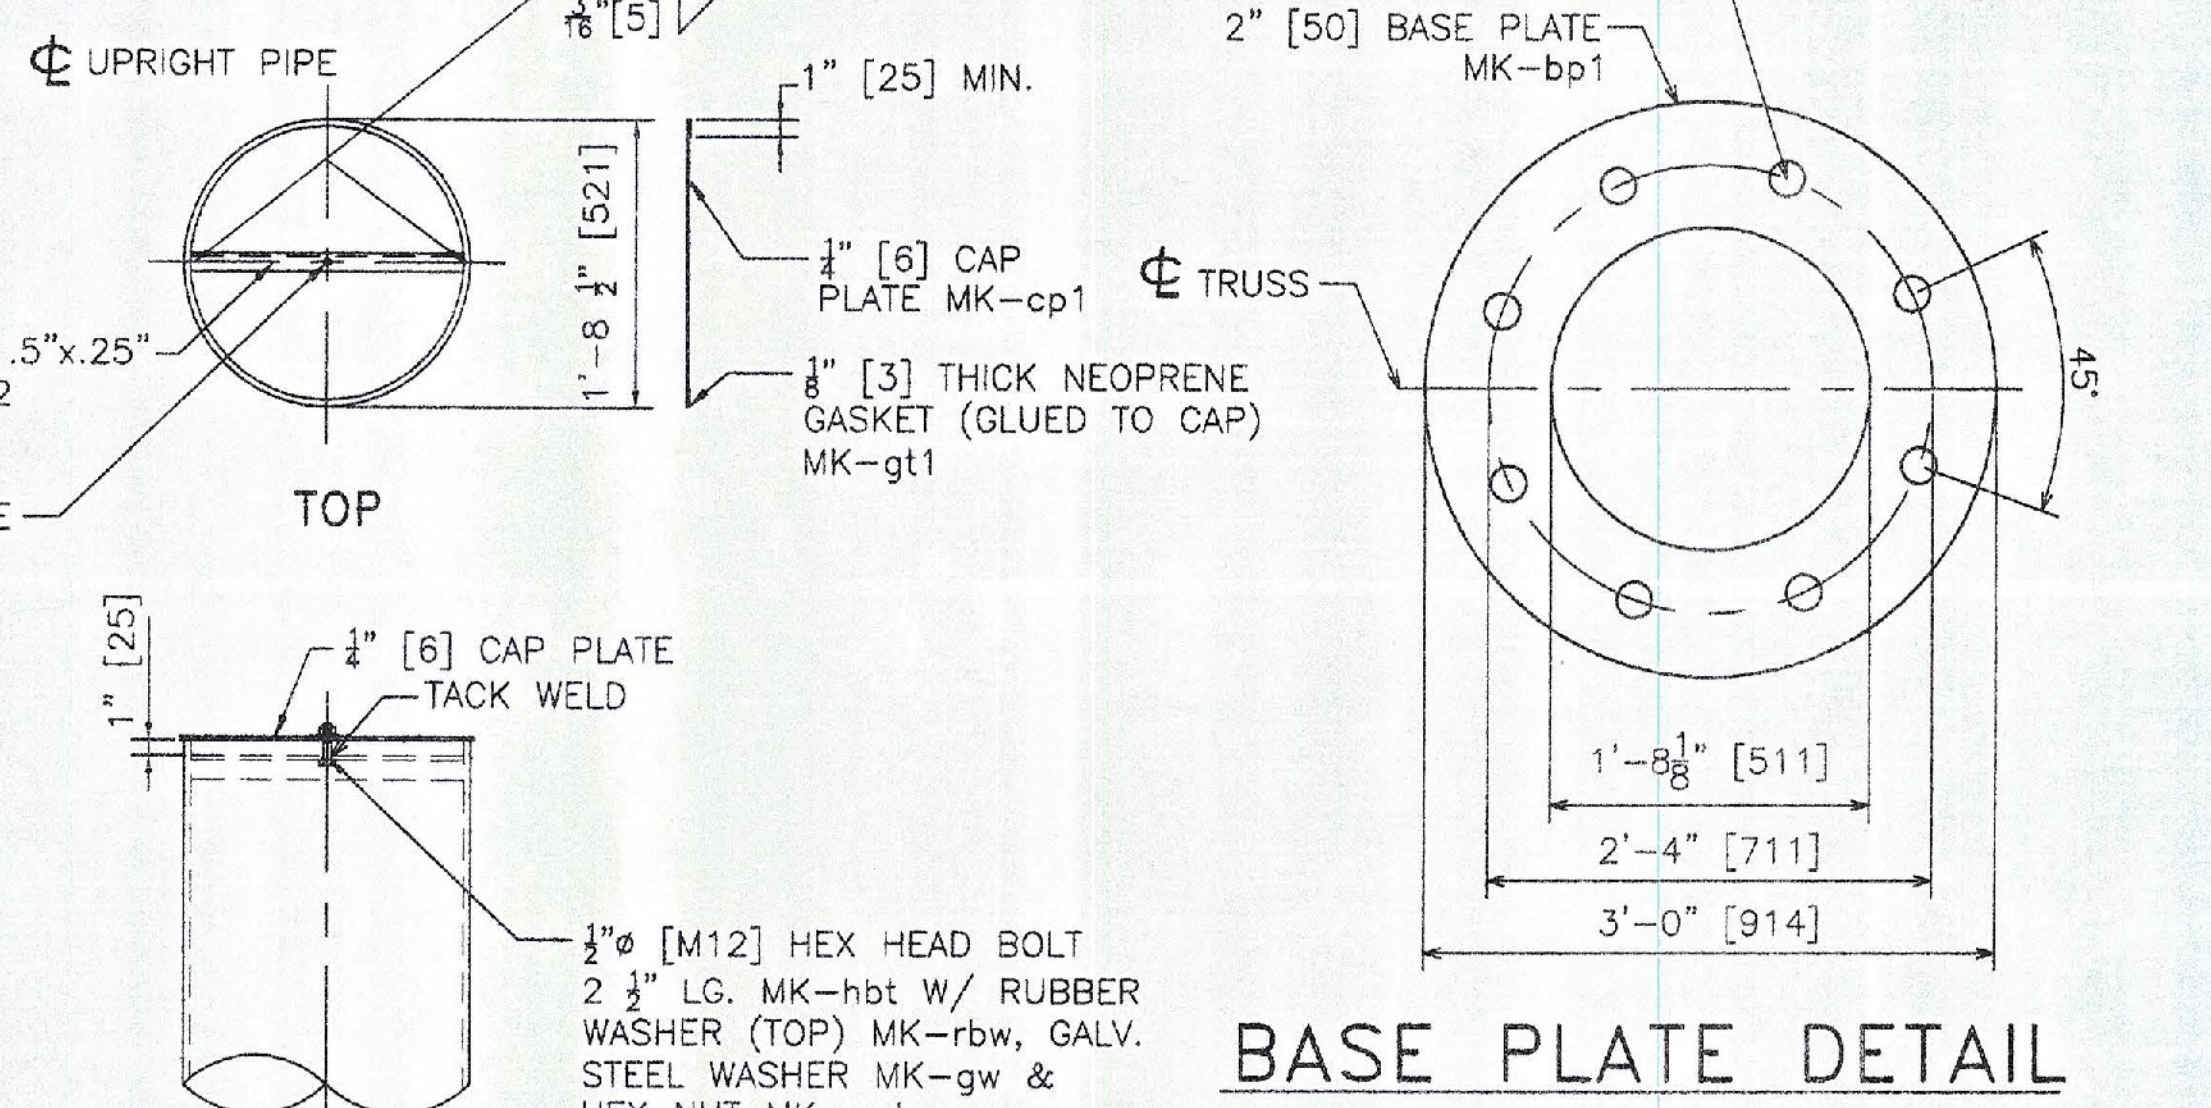

BASE PLATE DETAIL


NOTE: BASE PLATE SHALL BE STAMPED WITH THE VERTICAL POLE DIAMETER (VD.), HEIGHT (VHT.), YIELD STRENGTH (VYS.), GAUGE (VGE.), AND SAME FOR HORIZONTAL MEMBER (HD.), (HYS.), AND (HGE.).

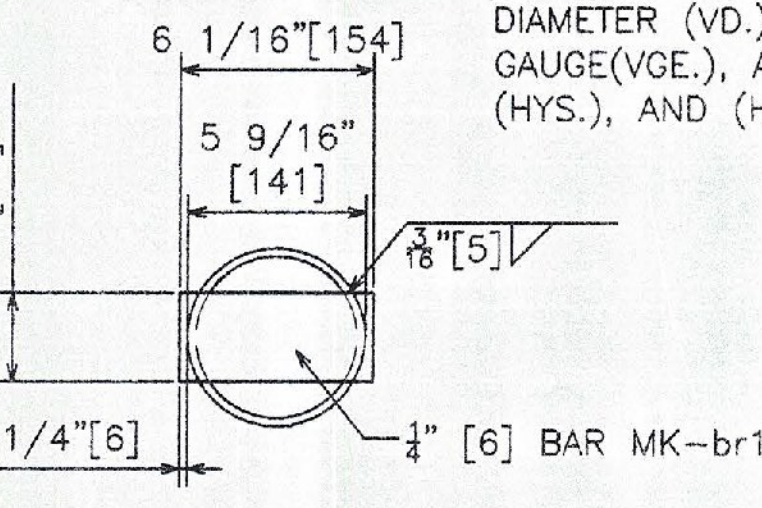

PLUG DETAIL (EACH END OF TRUSS CHORD)

REVISIONS		
No.	Remarks	Date
0	Initial submittal	

- NOTE:**
- STRUCTURE DESIGNED IN ACCORDANCE WITH LATEST EDITION AASHTO STANDARD SPECIFICATIONS FOR STRUCTURAL SUPPORTS FOR HIGHWAY SIGNS, LUMINARIES AND TRAFFIC SIGNALS.
  - ALL HOLES FOR HIGH STRENGTH FASTENERS SHALL BE DRILLED OR SUB-PUNCHED FULL SIZE. SLOTTED HOLES AND/OR VENT OR ACCESS HOLES MAY BE CUT WITH MECHANICALLY GUIDED PLASMA OR MECHANICALLY GUIDED FLAME TORCH.
  - GRIND SHARP CORNERS OF ALL PLATES TO A 1/8" MIN. RADIUS PRIOR TO GALVANIZING.
  - ALL WELDING SHALL BE PERFORMED BY QUALIFIED WELDERS IN ACCORDANCE WITH AWS D1.1.
  - ALL STEEL PLATES FOR STRUCTURAL COMPONENTS SHALL BE ASTM A709 GR. 50.
  - STEEL PLATES AND SHAPES FOR NON-STRUCTURAL COMPONENTS SHALL BE ASTM A709 GR. 36.
  - STEEL PIPES FOR STRUCTURAL MEMBERS SHALL HAVE MINIMUM YIELD OF 42 ksi AND SHALL CONFORM TO ONE OF THE FOLLOWING GRADES: ASTM A500 GR. B, OR API 5LX42.
  - UNLESS OTHERWISE NOTED, ALL BOLTS FOR STRUCTURAL CONNECTIONS SHALL BE M164 TYPE 1 (A325).
  - GALVANIZED U-BOLTS FOR CONNECTION OF SIGN HANGER BEAMS TO TRUSS SHALL BE ASTM F-1554 GR. 36.
  - ALL STRUCTURAL STEEL SHALL BE HOT-DIPPED GALVANIZED AFTER FABRICATION IN ACCORDANCE WITH AASHTO M111 (ASTM A123).
  - ALL HARDWARE, UNLESS OTHERWISE NOTED, SHALL BE HOT-DIPPED GALVANIZED PER AASHTO M232 (ASTM A153).
  - ANCHOR HARDWARE SHALL BE STAINLESS STEEL AND MEET REQUIREMENTS OF VAOT STANDARD SPECIFICATION 714.09.
  - CONCRETE AND REBAR SHOWN IN FOOTING DESIGN TO BE FURNISHED BY OTHERS.
  - FOUNDATION DESIGN BASED ON USE OF 3000 psi MINIMUM CONCRETE.
  - SPACE BETWEEN THE TOP OF CONCRETE AND THE BOTTOM OF STEEL BASE PLATE SHALL BE FILLED WITH TYPE IV MORTAR AFTER LEVELING.
  - BOLTS INSTALLED IN STRUCTURAL CONNECTIONS SHALL BE PROVIDED AND TENSIONED PER APPLICABLE PROVISIONS OF VAOT STANDARD SPECIFICATIONS SECTION 506.
  - SEAL WELD ALL CONNECTIONS WHEN POSSIBLE PRIOR TO GALVANIZING.

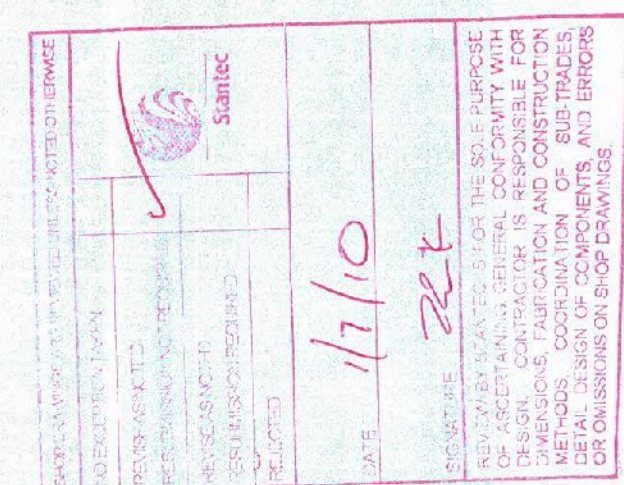

**HIGHWAY SAFETY CORP.**  
GLASTONBURY, CT

OVERHEAD SIGN STRUCTURE NB 8+992.0	DRAWN	MHM
WWII VETERANS MEMORIAL HIGHWAY	CHECKED	
COUNTY OF BENNINGTON	DATE	10/1/09
VT ROUTE 279, PRINCIPAL ARTERIAL	SCALE	N.T.S.
BENNINGTON AC NH 019-1(51)	REVISED	
	REVNO	1724a
GENERAL CONTRACTOR	SIZE	D
	REVISION	0
SUB CONTRACTOR	SHEET NO.	3 of 5
F.R. LAFAYETTE		

*Handwritten signature: R. J. Kelly*

ALL DIMENSIONS SHOWN [ ] ARE IN MILLIMETERS UNLESS OTHERWISE NOTED.