


DIMENSIONS SHOWN [] ARE IN MILLIMETER UNLESS OTHERWISE NOTED.

REVISIONS		
No.	Remarks	Date
0	Initial submittal	

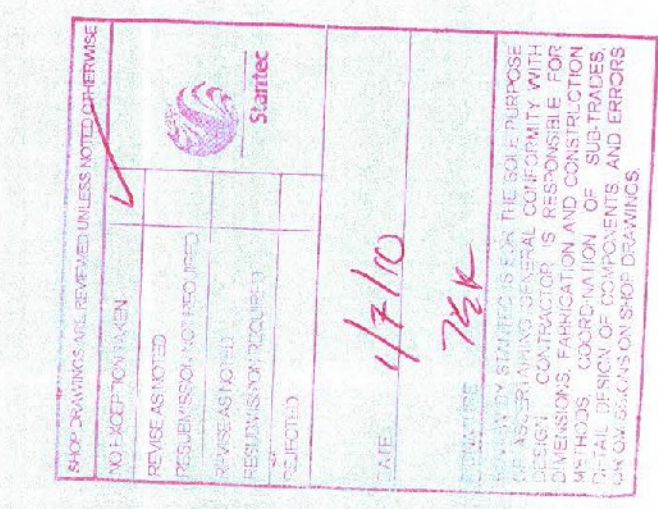

HIGHWAY SAFETY CORP.
GLASTONBURY, CT

OVERHEAD SIGN STRUCTURE NB 9+260.0
WWII VETERANS MEMORIAL HIGHWAY
COUNTY OF BENNINGTON
VT ROUTE 279, PRINCIPAL ARTERIAL
BENNINGTON AC NH 019-1(51)

GENERAL CONTRACTOR: F.R. LAFAYETTE

DATE: 10/1/09
SCALE: N.T.S.
SHEET NO.: 2 of 5