



FRAMING PLAN SPAN 1

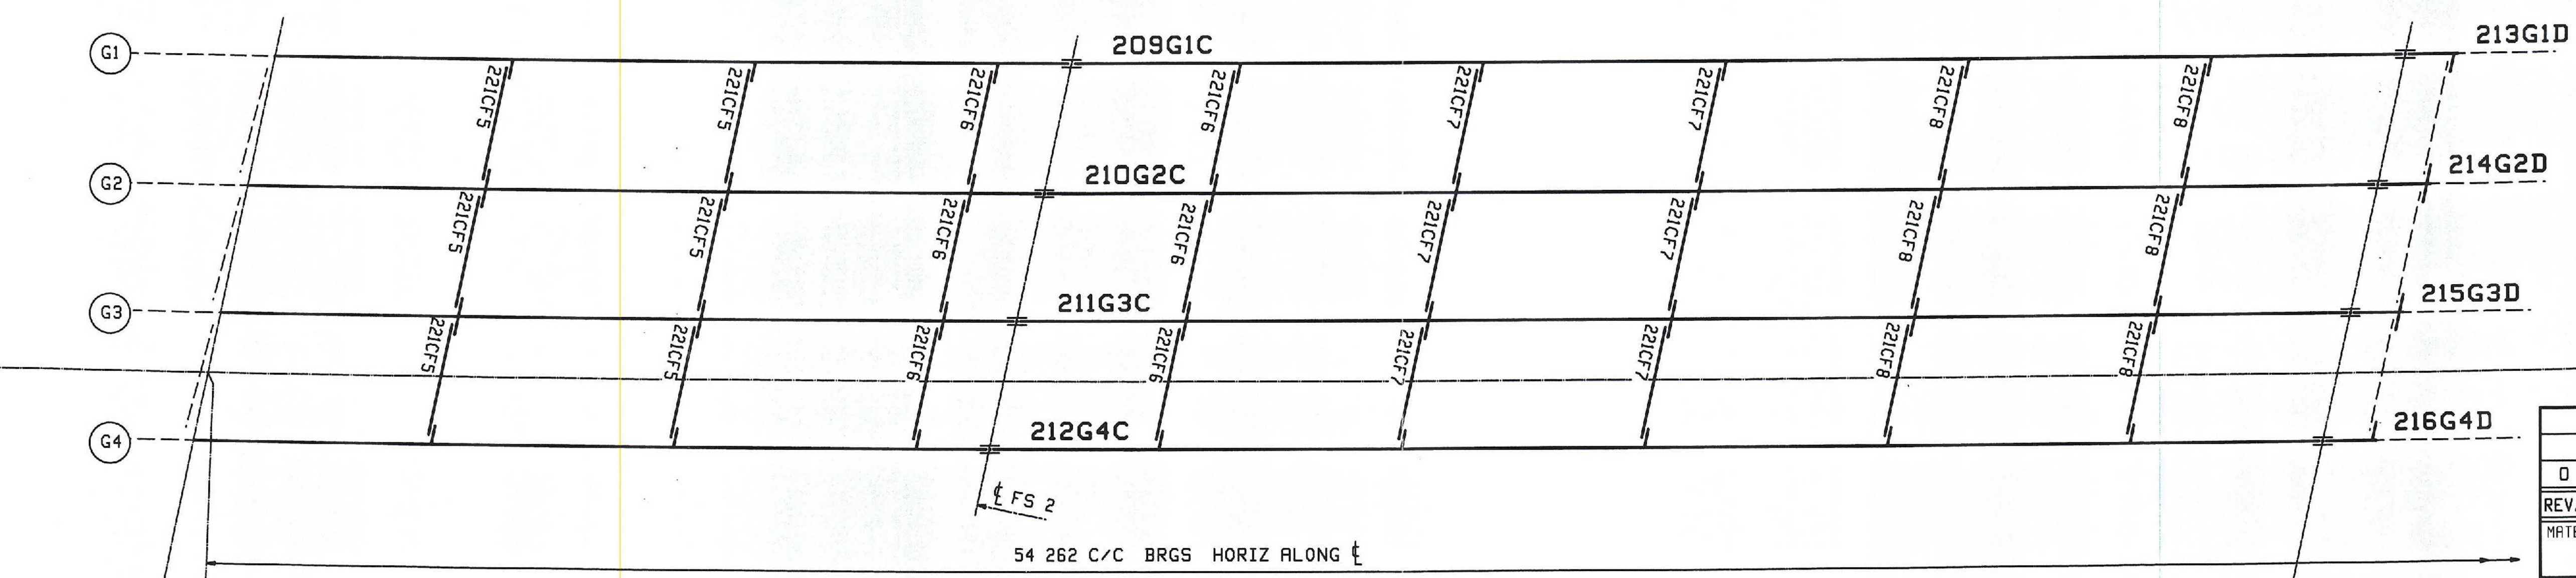

FRAMING PLAN SPAN 2

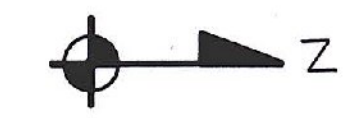

TVGA CONSULTANTS

NO EXCEPTIONS TAKEN
 FURNISH AS CORRECTED
 REVISE AND RESUBMIT
 REJECTED
 ENGINEER has reviewed Shop Drawings and Samples and other data which Contractor is required to submit, only for performance with the information given in the Contract Documents and compliance with the design concept of the completed Project as a functioning whole as indicated in the Contract Documents. Such review is not intended to insure, methods, techniques, sequences or procedures of construction or to safety precautions and programs incident thereto. Such review does not extend to any LEED certification or accreditation. Contractor is responsible for dimensions to be confirmed and controlled at the job site for information that pertains to the fabrication processes or to techniques of construction, and for coordination of the work of all trades.
 BY: *JM*
 DATE: 11-05-09

WORK THIS DRAWING WITH DRAWING E202

REV.	DATE	REMARKS	DMN	CHK	APVL	SHOP
0						SEP 04 2009
MATERIAL:		SURFACE PREP. & PAINT:	HOLES:		SHOP BOLTS:	
			AS NOTED		AS NOTED	
DESCRIPTION: FRAMING PLAN						
CASCO BAY STEEL STRUCTURES, INC.						
75 SPRING HILL ROAD			SACO, MAINE 04072			
PHONE (207) 282-7360			FRX. (207) 282-1179			
STRUCTURE: RAMP D				DRAWN:	DATE:	
VT RTE 279 OVER WALLOOMSAC RIVER				TS	07/20	
BRIDGE NO. B15N				CHKD:	DATE:	
BENNINGTON COUNTY				DO	08/22	
LOCATION: BENNINGTON, VERMONT			JOB NO.	DWG NO.		
PROJ NO. AC NH 019-1(51)			408-2	E201		
CUSTOMER: KUBRICKY CONSTRUCTION			REV. <input checked="" type="checkbox"/>			

NOTE:
FOR GENERAL NOTES SEE DRAWING GNI.