


PLAN VIEW GIRDER @ BOTT OF WEB

LINE	WT	WL1	WL2	H1	H2	H3	H4	WBI	WB2	WCF1	WCF2	WCF3	WCF4	WCF5
1	60 085	32 597	27 488	-172	-289	-326	-245	45 216	14 869	9336	10 253	13 008	12 619	14 869
2	60 082	32 594	27 488	-172	-288	-326	-244	45 212	14 870	9336	10 252	13 006	12 618	14 870
3	60 079	32 591	27 488	-172	-288	-325	-244	45 209	14 870	9336	10 252	13 003	12 618	14 870
4	60 076	32 588	27 488	-172	-287	-324	-243	45 207	14 869	9336	10 252	13 000	12 619	14 869

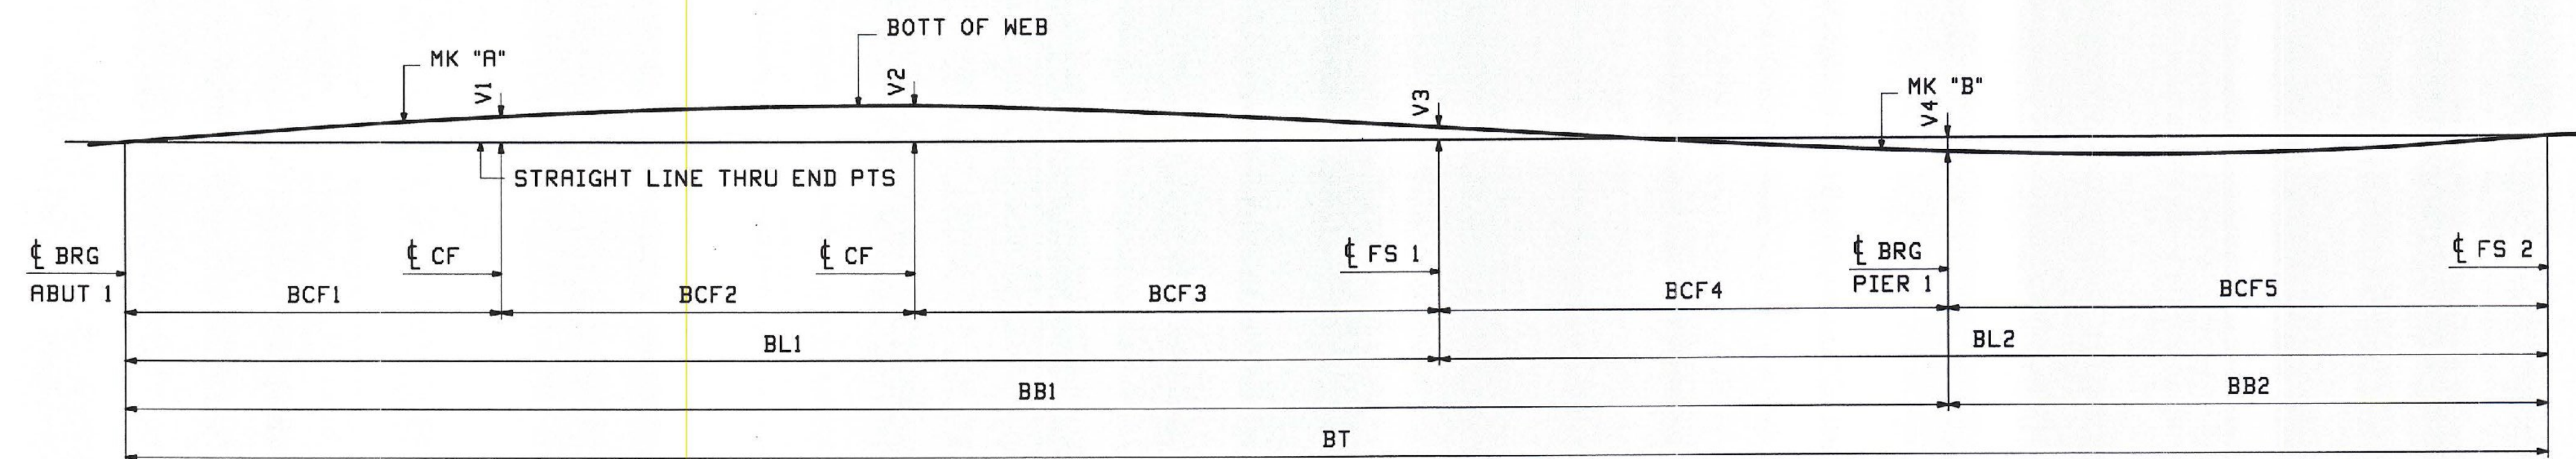

DEVELOPED SECTION A-A
DIMENSIONS GIVEN ALONG WEB

LINE	BT	BL1	BL2	V1	V2	V3	V4	BB1	BB2	BCF1	BCF2	BCF3	BCF4	BCF5	"A"	"B"
1	60 090	32 599	27 491	89	127	46	-49	45 218	14 872	9338	10 253	13 008	12 619	14 872	201G1A	205G1B
2	60 086	32 596	27 490	92	132	46	-53	45 215	14 871	9337	10 254	13 005	12 619	14 871	202G2A	206G2B
3	60 084	32 593	27 491	92	131	46	-51	45 212	14 872	9338	10 253	13 002	12 619	14 872	203G3A	207G3B
4	60 081	32 591	27 490	92	131	47	-49	45 210	14 871	9338	10 253	13 000	12 619	14 871	204G4A	208G4B

NOTES
FOR GENERAL NOTES SEE DWG GN1
ALL DIMENSIONS GIVEN AT BOTT OF WEB

TVGA CONSULTANTS

NO EXCEPTIONS TAKEN
 FURNISH AS CORRECTED
 REVISE AND RESUBMIT
 ENGINEER has reviewed Shop Drawings and Samples and other data which Contractor is required to submit, only for conformance with the information given in the Contract Documents and compliance with the design concept of the completed Project as a functioning whole as indicated in the Contract Documents. Such reviews do not extend to means, methods, techniques, sequences or procedures of construction or to safety precautions and programs incident thereto. Such reviews do not extend to any LEED certification or accreditation. Contractor is responsible for dimensions to be confirmed and corrected at the job site, for information that pertains solely to the fabrication processes or to techniques of construction, and for coordination of the work of all trades.

BY: Jim
DATE: 11-05-09

REV.	DATE	REMARKS	DWN	CHK	APVL	SHOP
0						SEP 04 2009
MATERIAL:		SURFACE PREP. & PAINT:		HOLES:		SHOP BOLTS:
				AS NOTED		AS NOTED
DESCRIPTION: SHOP ASSEMBLY DIAGRAM						
CASCO BAY STEEL STRUCTURES, INC. 75 SPRING HILL ROAD SRCO, MAINE 04072 PHONE (207) 282-7360 FAX. (207) 282-1179						
STRUCTURE: RAMP D VT RTE 279 OVER WALLOOMSAC RIVER BRIDGE NO. B15N BENNINGTON COUNTY				DRAWN: TS	DATE: 07/21	
				CHKD: DO	DATE: 08/22	
LOCATION: BENNINGTON, VERMONT			JOB NO.		DWG NO.	
PROJ NO. AC NH 019-1(51)			408-2		S1	
CUSTOMER: KUBRICKY CONSTRUCTION					REV. Δ	