


PLAN VIEW GIRDER @ BOTT OF WEB

LINE	WT	WL1	WL2	WL3	H1	H2	H3	H4	H5	WB1	WB2	WB3	WCF1	WCF2	WCF3	WCF4	WCF5	WCF6
1	79 847	27 485	24 890	27 472	-309	-524	-580	-524	-314	12 615	54 356	12 876	12 615	14 870	12 298	12 592	14 596	12 876
2	79 842	27 485	24 884	27 473	-308	-523	-579	-523	-313	12 615	54 351	12 876	12 615	14 870	12 298	12 586	14 597	12 876
3	79 837	27 485	24 880	27 472	-308	-522	-578	-522	-313	12 615	54 346	12 876	12 615	14 870	12 298	12 582	14 596	12 876
4	79 832	27 485	24 875	27 472	-307	-521	-577	-521	-312	12 615	54 342	12 875	12 615	14 870	12 298	12 577	14 597	12 875

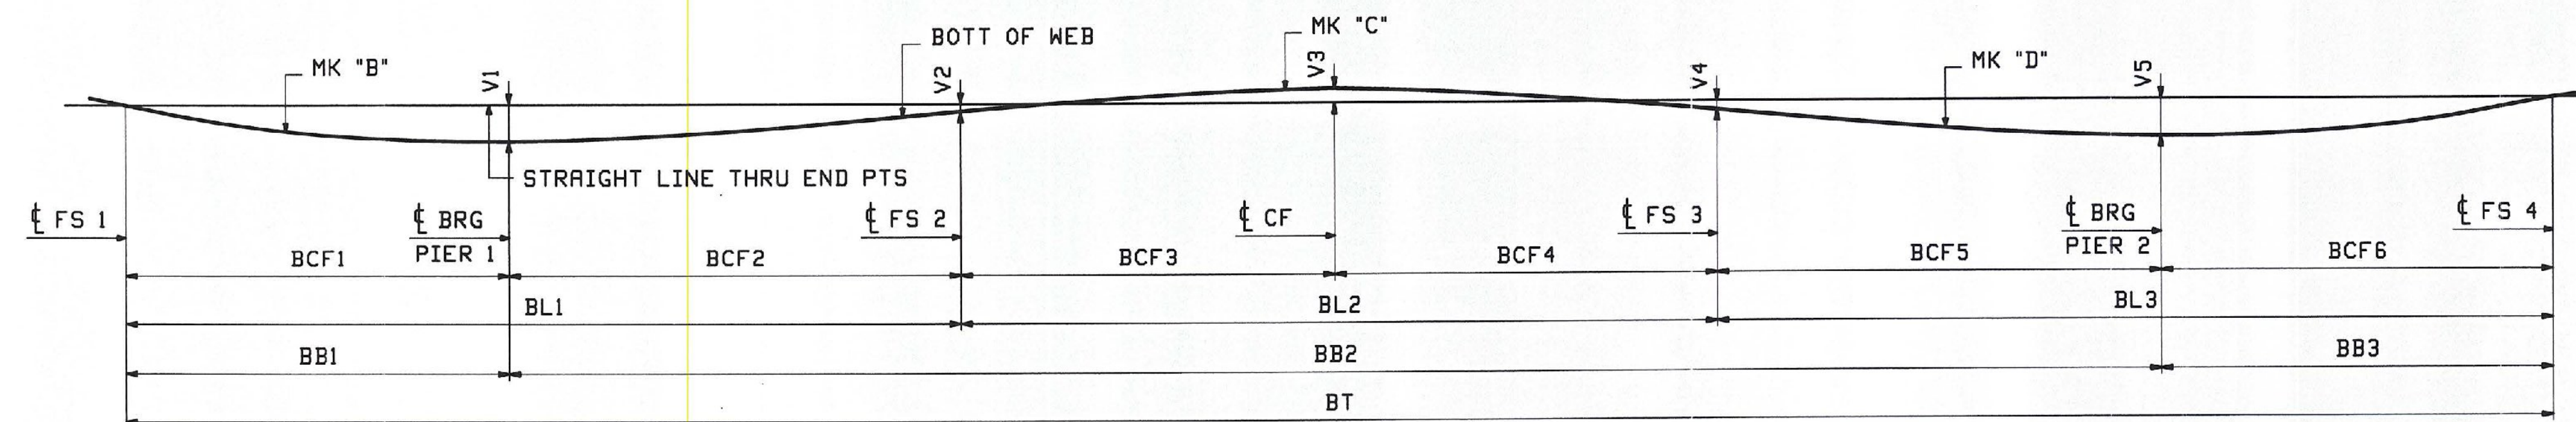

DEVELOPED SECTION A-A  
DIMENSIONS GIVEN ALONG  $\bar{C}$  WEB

LINE	BT	BL1	BL2	BL3	V1	V2	V3	V4	V5	BB1	BB2	BB3	BCF1	BCF2	BCF3	BCF4	BCF5	BCF6	"B"	"C"	"D"
1	79 858	27 490	24 890	27 478	-81	-16	33	-19	-83	12 619	54 360	12 879	12 619	14 871	12 299	12 591	14 599	12 879	205G1B	209G1C	213G1D
2	79 853	27 491	24 884	27 478	-84	-14	38	-17	-85	12 619	54 355	12 879	12 619	14 872	12 298	12 586	14 599	12 879	206G2B	210G2C	214G2D
3	79 848	27 490	24 880	27 478	-83	-16	34	-18	-85	12 619	54 350	12 879	12 619	14 871	12 298	12 582	14 599	12 879	207G3B	211G3C	215G3D
4	79 844	27 490	24 876	27 478	-83	-18	30	-21	-85	12 619	54 345	12 880	12 619	14 871	12 298	12 578	14 598	12 880	208G4B	212G4C	216G4D

NOTES  
FOR GENERAL NOTES SEE DWG GNI  
ALL DIMENSIONS GIVEN AT BOTT OF WEB

REV.	DATE	REMARKS	DWN	CHK	APVL	SHOP
0						SEP 04 2009
MATERIAL:		SURFACE PREP. & PAINT:		HOLES:		SHOP BOLTS:
				AS NOTED		AS NOTED
DESCRIPTION: SHOP ASSEMBLY DIAGRAM						
CASCO BAY STEEL STRUCTURES, INC.						
75 SPRING HILL ROAD			SACO, MAINE 04072			
PHONE (207) 282-7360			FAX. (207) 282-1179			
STRUCTURE: RAMP D			DRAWN:	DATE:		
VT RTE 279 OVER WALLOOMSAC RIVER			TS	07/21		
BRIDGE NO. B15N			CHKD:	DATE:		
BENNINGTON COUNTY			DO	08/22		
LOCATION: BENNINGTON, VERMONT			JOB NO.	DWG NO.		
PROJ NO. AC NH 019-1(51)			408-2	SA2		
CUSTOMER: KUBRICKY CONSTRUCTION			REV.	▲		

**TVGA CONSULTANTS**  
 NO EXCEPTIONS TAKEN  
 FURNISH AS CORRECTED  
 REVISE AND RESUBMIT  
 REJECTED  
 ENGINEER has reviewed Shop Drawings and Samples and  
 other data which Contractor is required to submit, only for  
 conformance with the information given in the Contract  
 Documents. Such reviews do not extend to means,  
 methods, techniques, sequences or procedures of  
 construction or to safety precautions and programs incident  
 thereto. Such reviews do not extend to any LEED certification  
 or accreditation. Contractor is responsible for determining to  
 be confirmed and consistent with the information that  
 pertains specifically to the fabrication processes or to techniques of  
 construction and the coordination of the work of all trades.  
 BY: *JSM*  
 DATE: 11-03-09