


PLAN VIEW GIRDER @ BOTT OF WEB

LINE	WT	WL1	WL2	H1	H2	H3	H4	WB1	WB2	WCF1	WCF2	WCF3	WCF4	WCF5
1	60 170	27 475	32 695	-242	-327	-290	-173	14 596	45 574	14 596	12 879	12 989	10 336	9370
2	60 164	27 476	32 688	-242	-327	-290	-173	14 596	45 568	14 596	12 880	12 982	10 337	9369
3	60 159	27 476	32 683	-241	-326	-289	-173	14 596	45 563	14 596	12 880	12 977	10 336	9370
4	60 153	27 475	32 678	-241	-325	-289	-172	14 596	45 557	14 596	12 879	12 972	10 336	9370

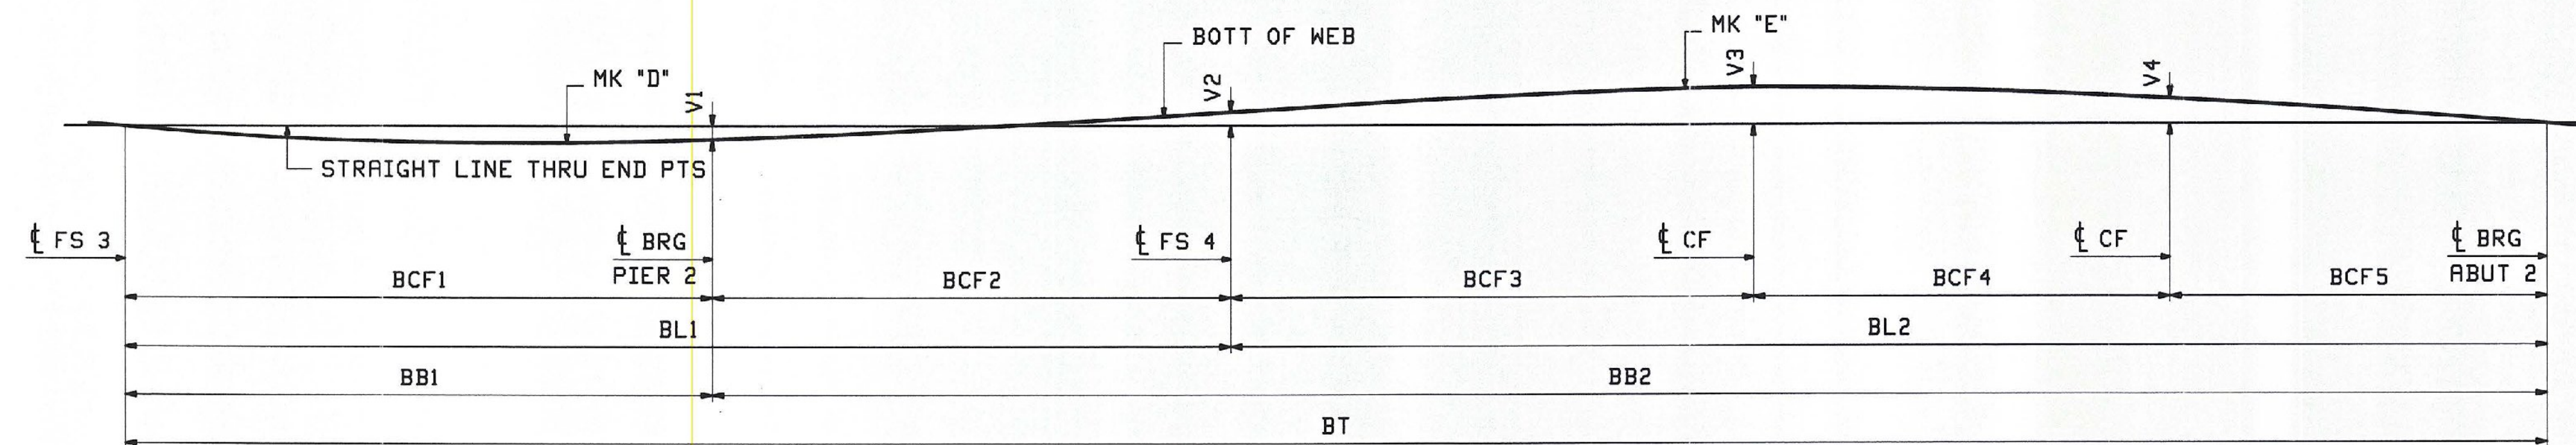

DEVELOPED SECTION A-A
DIMENSIONS GIVEN ALONG CL WEB

LINE	BT	BL1	BL2	V1	V2	V3	V4	BB1	BB2	BCF1	BCF2	BCF3	BCF4	BCF5	"D"	"E"
1	60 175	27 478	32 697	-48	48	131	91	14 599	45 576	14 599	12 879	12 988	10 337	9372	213G1D	217G1E
2	60 169	27 478	32 691	-52	49	136	96	14 599	45 570	14 599	12 879	12 983	10 337	9371	214G2D	218G2E
3	60 164	27 478	32 686	-50	50	135	95	14 598	45 566	14 598	12 880	12 977	10 337	9372	215G3D	219G3E
4	60 157	27 478	32 679	-49	51	135	95	14 598	45 559	14 598	12 880	12 971	10 338	9370	216G4D	220G4E

NOTES
FOR GENERAL NOTES SEE DWG GNI
ALL DIMENSIONS GIVEN AT BOTT OF WEB

TVGA CONSULTANTS

NO EXCEPTIONS TAKEN REJECTED
 FURNISH AS CORRECTED
 REVISE AND RESUBMIT
 ENGINEER has reviewed Shop Drawings and Samples and other data which Contractor is required to submit, only for conformance with the information given in the Contract Documents and compatibility with the design concept of the completed Project as a functioning whole as indicated in the Contract Documents. Such reviews do not extend to means, methods, techniques, sequences or procedures of construction or to safety procedures and programs incident thereto. Such reviews do not extend to any LEED certification or accreditation. Contractor is responsible for dimensions to be confirmed and controlled at the job site, for information that pertains solely to the fabrication processes or to techniques of construction, and for coordination of the work of all trades.

BY: JM
DATE: 11-05-09

REV.	DATE	REMARKS	DWN	CHK	APVL	SHOP
0						
MATERIAL:		SURFACE PREP. & PAINT:		HOLES:		SHOP BOLTS:
				AS NOTED		AS NOTED
DESCRIPTION: SHOP ASSEMBLY DIAGRAM						
CASCO BAY STEEL STRUCTURES, INC. 75 SPRING HILL ROAD SARCO, MAINE 04072 PHONE (207) 282-7360 FAX. (207) 282-1179						
STRUCTURE: RAMP D VT RTE 279 OVER WALLOOMSAC RIVER BRIDGE NO. B15N BENNINGTON COUNTY				DRAWN: TS	DATE: 07/21	
LOCATION: BENNINGTON, VERMONT				CHKD: DO	DATE: 08/22	
PROJ NO. AC NH 019-1(51)				JOB NO.	DWG NO. SA3	
CUSTOMER: KUBRICKY CONSTRUCTION				408-2	REV. <u>△</u>	