


BILL OF MATERIAL FOR BRIDGE B15N (EAST & WEST)					
Mark #	Qty.	Description	Size/Shape	Length/Qty per Unit	Material
122		W150x37.1 POST W/BASEPLATE 620 OAL			
122		POST UPRIGHT	W150 x 37	595	A709M Gr. 345
122		POST BASE PLATE	254 x 25	356	A709M Gr. 345
122		BEARING PAD	254 x 3	356	NEOPRENE
B9	2	TS 203 x 102 x 8 TOP RAIL		7.188m	A500 Gr. B
	2	TS 102 x 102 x 6 BOTTOM RAIL		7.188m	A500 Gr. B
B10	26	TS 203 x 102 x 8 TOP RAIL		7.220m	A500 Gr. B
	26	TS 102 x 102 x 6 BOTTOM RAIL		7.220m	A500 Gr. B
B11	2	TS 203 x 102 x 8 TOP RAIL		6.045m	A500 Gr. B
	2	TS 102 x 102 x 6 BOTTOM RAIL		6.045m	A500 Gr. B
B12	2	TS 203 x 102 x 8 TOP RAIL		5.982m	A500 Gr. B
	2	TS 102 x 102 x 6 BOTTOM RAIL		5.982m	A500 Gr. B
B13	4	TS 203 x 102 x 8 TOP RAIL		4.785m	A500 Gr. B
	4	TS 102 x 102 x 6 BOTTOM RAIL		4.785m	A500 Gr. B
B14	4	TS 203 x 102 x 8 TOP RAIL		7.198m	A500 Gr. B
	4	TS 102 x 102 x 6 BOTTOM RAIL		7.198m	A500 Gr. B
B15	2	TS 203 x 102 x 8 TOP RAIL		4.807m	A500 Gr. B
	2	TS 102 x 102 x 6 BOTTOM RAIL		4.807m	A500 Gr. B
B16	2	TS 203 x 102 x 8 TOP RAIL		3.664m	A500 Gr. B
	2	TS 102 x 102 x 6 BOTTOM RAIL		3.664m	A500 Gr. B
	42	TS 178 x 76 x 10 SPLICE TUBE		510	A500 Gr. B
	42	TS 76 x 76 x 8 SPLICE TUBE		510	A500 Gr. B
	488	M24 ANCHOR STUD		305	A449
	488	M24 WASHER			F436M
	1464	M24 HEX NUTS			A563 DH
	488	M20 ROUND HEAD BOLT		152	M164M
	488	M20 HEX NUT			A563 DH
	488	M20 WASHER			F436M
	336	M16 SPLICE BOLT		44	A32M
	336	M16 PLAIN HARDENED WASHER			F436M
	168	M16 NUT WELDED TO SPLICE TUBE			A563M
	32	DN 20 SCH. 40 PIPE SPACER		13	A53 Gr. B
	122	SPACER PLATE	238 x 10	330	A709M GR. 36

NOTE:
1. DIMENSIONS ARE IN MM UNLESS NOTED OTHERWISE.

LIMITS OF SNOW FENCE

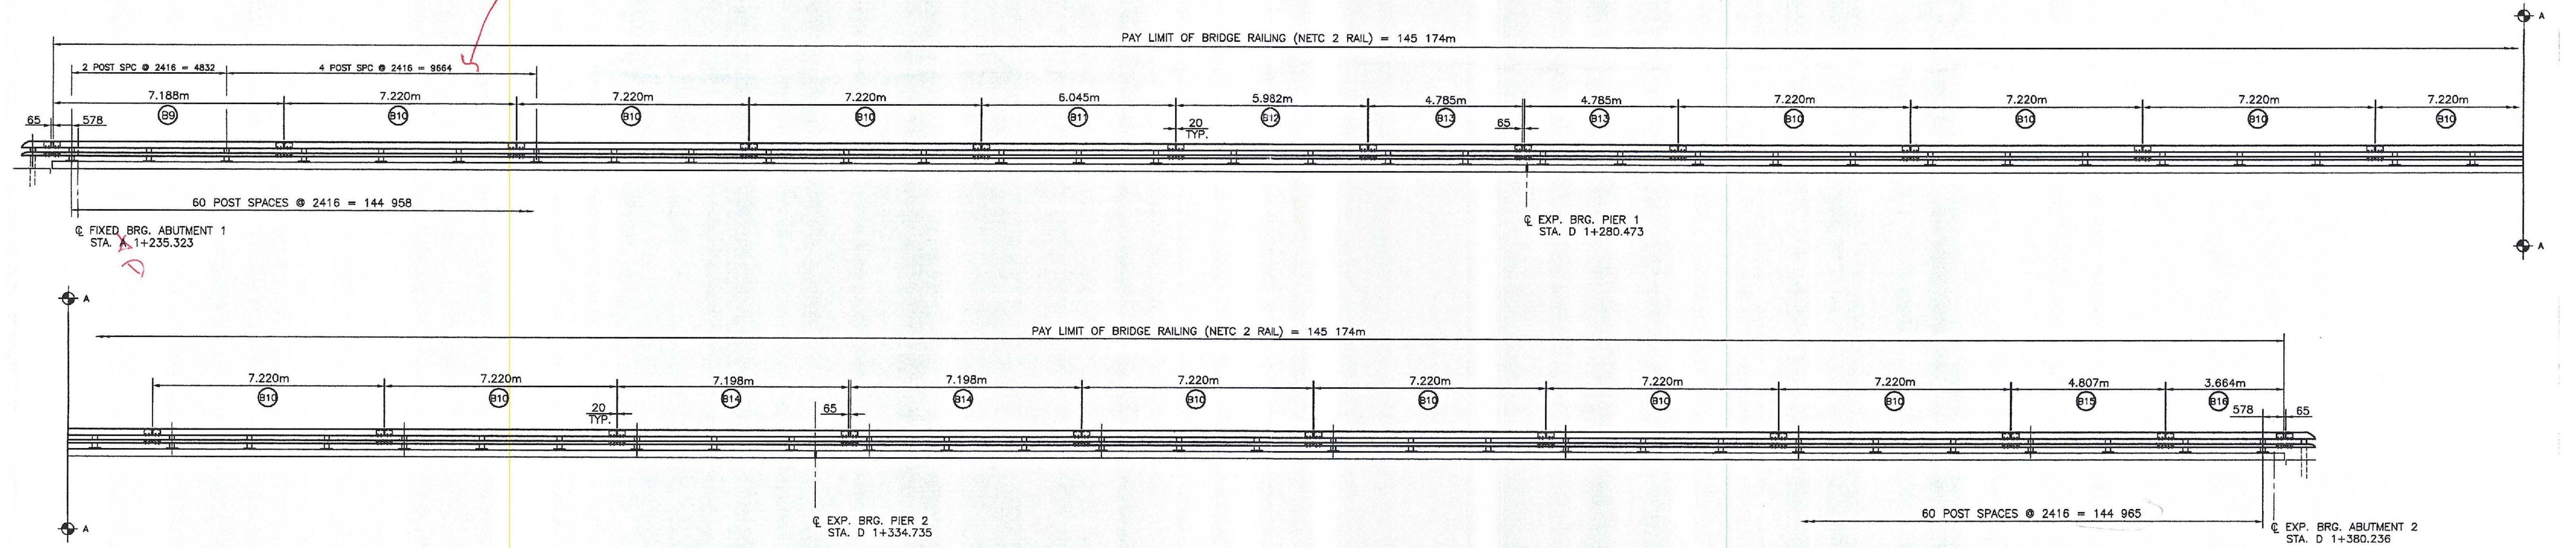

WEST RAIL ELEVATION
LOOKING WEST FROM Q OF ROAD
EAST SIDE SIMILAR
BRIDGE NO. B15N

TVGA CONSULTANTS

NO EXCEPTIONS TAKEN REJECTED
 FURNISH AS CORRECTED
 REVISE AND RESUBMIT
 ENGINEER has reviewed Shop Drawings and Samples and other data which Contractor is required to submit, site for conformance with the information given in the Contract Documents and compliance with the design concept of the completed Project as a functioning whole as indicated in the Contract Documents. Such reviews do not extend to means, methods, techniques, sequences or procedures of construction or to safety precautions and programs, included thereto. Such reviews do not extend to any LEED certification or accreditation. Contractor is responsible for dimensions to be confirmed and controlled at the job site for information that pertains solely to the fabrication processes or to techniques construction; and for coordination of the work of all trades.

REVISIONS		
No.	Remarks	Date

HIGHWAY SAFETY CORP GLASTONBURY, CT 860-633-9445	
ITEM 525.33 BRIDGE RAILING - NETC 2 RAIL TOWN OF BENNINGTON COUNTY OF BENNINGTON PROJECT AC NH 019-1(51) BRIDGE B15N VT ROUTE 279 OVER ROARING BRANCH	
GENERAL CONTRACTOR F.R. LAFAYETTE, INC.	CERTIFIED FABRICATOR ASC JOB NO. 1730 SHEET NO. 2 of 4
DRAWN: RWL CHECKED: PAR DATE: 11/16/2009 SCALE: NONE SIZE: D	BY: <i>JS</i> DATE: 5-11-10