
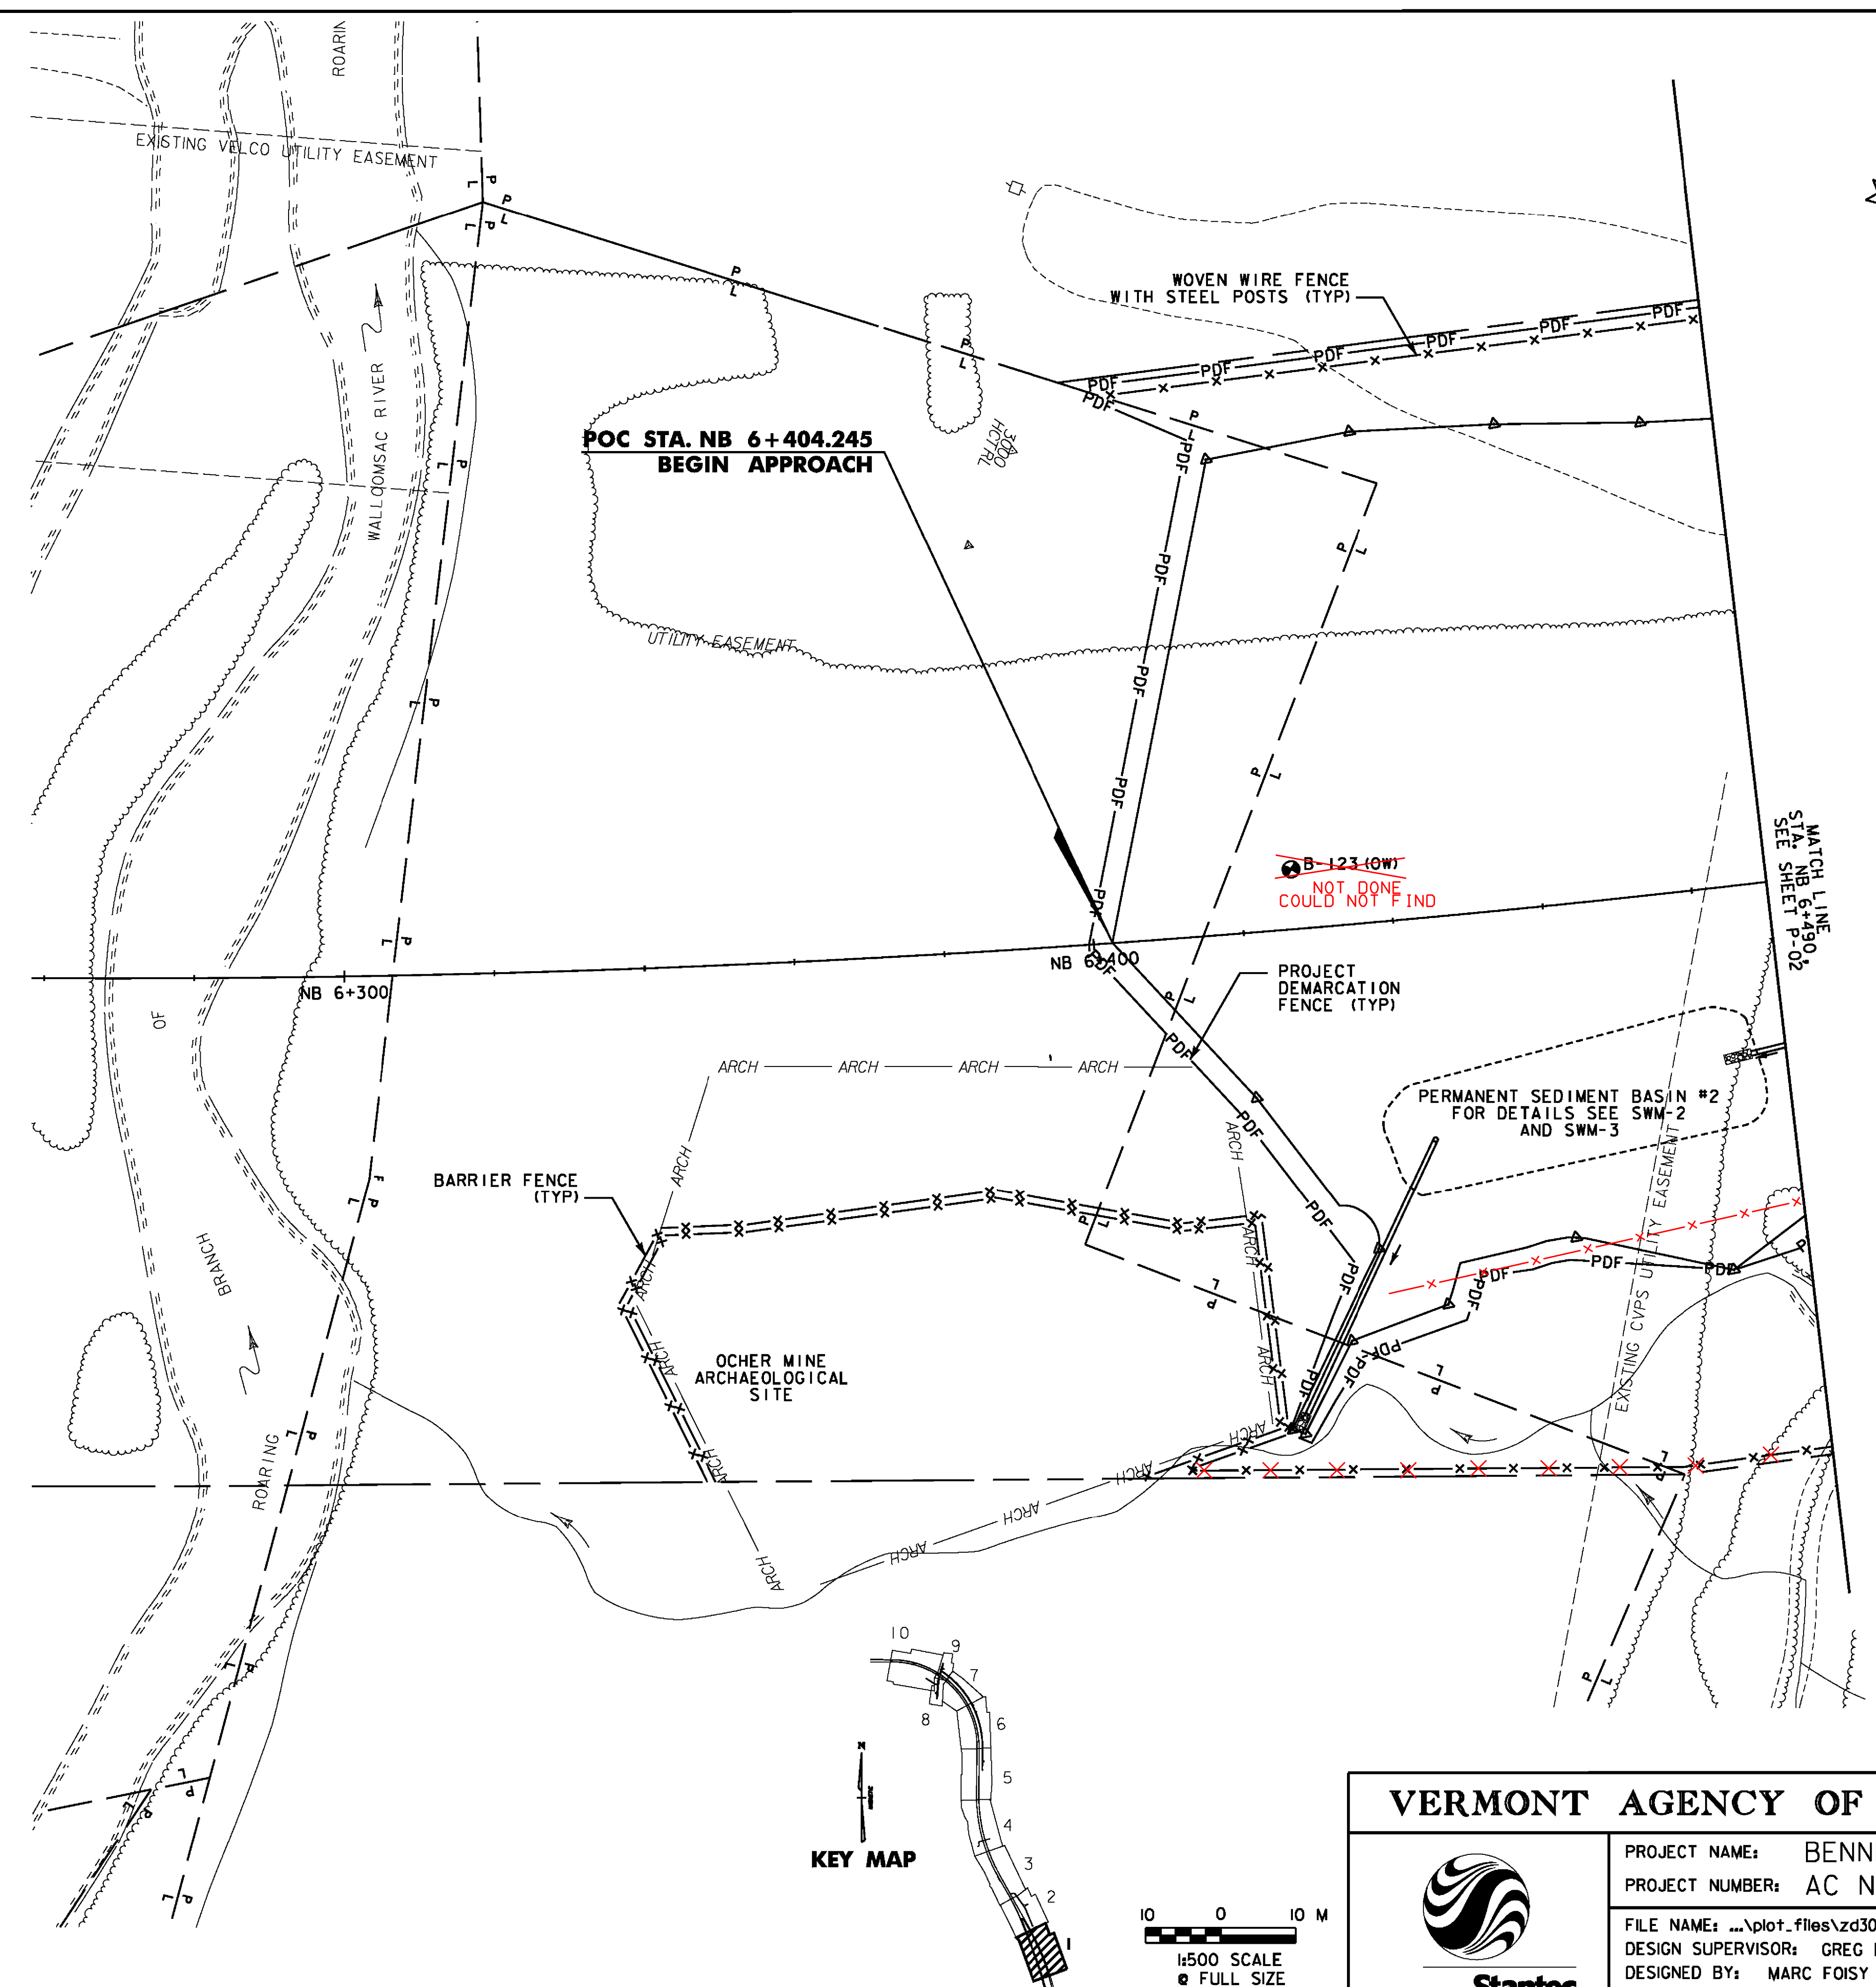


WOVEN WIRE FENCE WITH STEEL POSTS
STA. NB 6+404.245, 74.2m LT. - STA. NB 6+490.000, 77.1m LT.
STA. NB 6+401.855, 71.8m RT. - STA. NB 6+490.000, 75.7m RT.
434 50m 497 42m


PROJECT DEMARCATION FENCE
STA. NB 6+404.245, 74.2m LT. - STA. NB 6+399.368, C.
STA. NB 6+399.368 C. - STA. NB 6+420.731, 67.0m RT.
STA. NB 6+420.731, 67.0m RT. - STA. NB 6+490.000, 48.2m RT.
STA. NB 6+406.539, 72.8m LT. - STA. NB 6+490.000, 75.6m LT.

BARRIER FENCE
STA. NB 6+340.791, 34.7m RT. - STA. NB 6+345.598, 68.7m RT.
STA. NB 6+340.791, 34.7m RT. - STA. NB 6+419.385, 37.5m RT.
STA. NB 6+401.855, 71.8m RT. - STA. NB 6+419.385, 37.5m RT.

~~SPECIAL PROVISION (DECOMMISSION OBSERVATION WELL)~~
~~STA. NB 6+427.000, 8.0 m LT (B-123)~~
NOT DONE
COULD NOT FIND

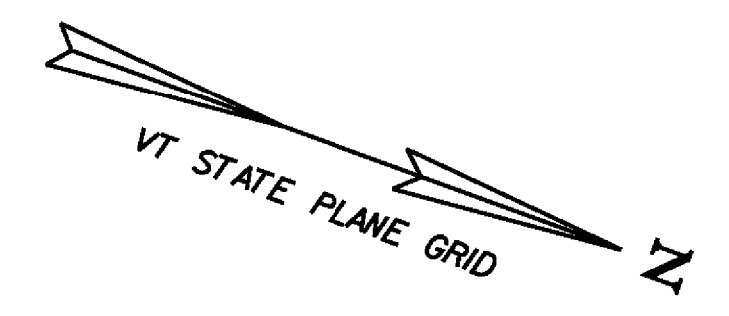

LEGEND	
PDF — PDF —	PROJECT DEMARCATION FENCE
X—X—X—	BARRIER FENCE
x—x—x—	CHAIN-LINK FENCE
x—x—x—	RIGHT OF WAY FENCE
WETLAND BOUNDARY	
ARCH — ARCH	ARCHAEOLOGICAL SITE
WATER BOUNDARY	
P — L —	PROPERTY LINE

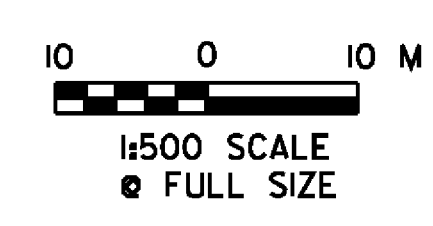

VERMONT AGENCY OF TRANSPORTATION

PROJECT NAME:	BENNINGTON
PROJECT NUMBER:	AC NH 019-1(52)
FILE NAME:	...plot.files\zd307c2p0lptf
DESIGN SUPERVISOR:	GREG EDWARDS
DESIGNED BY:	MARC FOISY
GENERAL PLAN	P-01

PLOT DATE:	5/16/2011
DRAWN BY:	STANTEC
CHECKED BY:	GARY SANTY
SHEET	71 OF 267

V:\953\active\95310002\transportation\drawing\contract\2\plot_files\zd307c2p0lptf