

MANUFACTURED TERMINAL SECTION, FLARED
STA. NB 7+000.000, 8.7m LT.
STA. NB 7+003.249, 8.7m RT.

Metric


A diagram showing a line representing the VT State Plane Grid, which is slightly tilted from a vertical line. An arrow points upwards along this line, and the text "VT STATE PLANE GRID" is written next to it. To the right of the grid line, there is a vertical line with an arrow pointing upwards, labeled "N" for North.

GATE FOR CHAIN-LINK FENCE, 1.8m
STA. VR 1+146.442, 2.5m LT. TO 2.5m RT.


008 STEEL BEAM GUARDRAIL, GALVANIZED
STA. NB 7+000.000, 8.7m LT. - STA. NB 7+090.000, 8.7m LT.
STA. NB 7+003.249, 8.7m RT. - STA. NB 7+090.000, 8.7m RT.

CHAIN-LINK FENCE, 1.8m
STA. VR 1+146.442, 2.5m LT. TO 5.0m LT.
STA. VR 1+146.442, 2.5m RT. TO 5.0m RT.

~~CEDAR LOG RAIL~~ NOT USED
STA. VR 1+120.000, 2.0m LT. - STA. VR 1+145.820, 2.0m RT.
STEEL BEAM GUARDRAIL

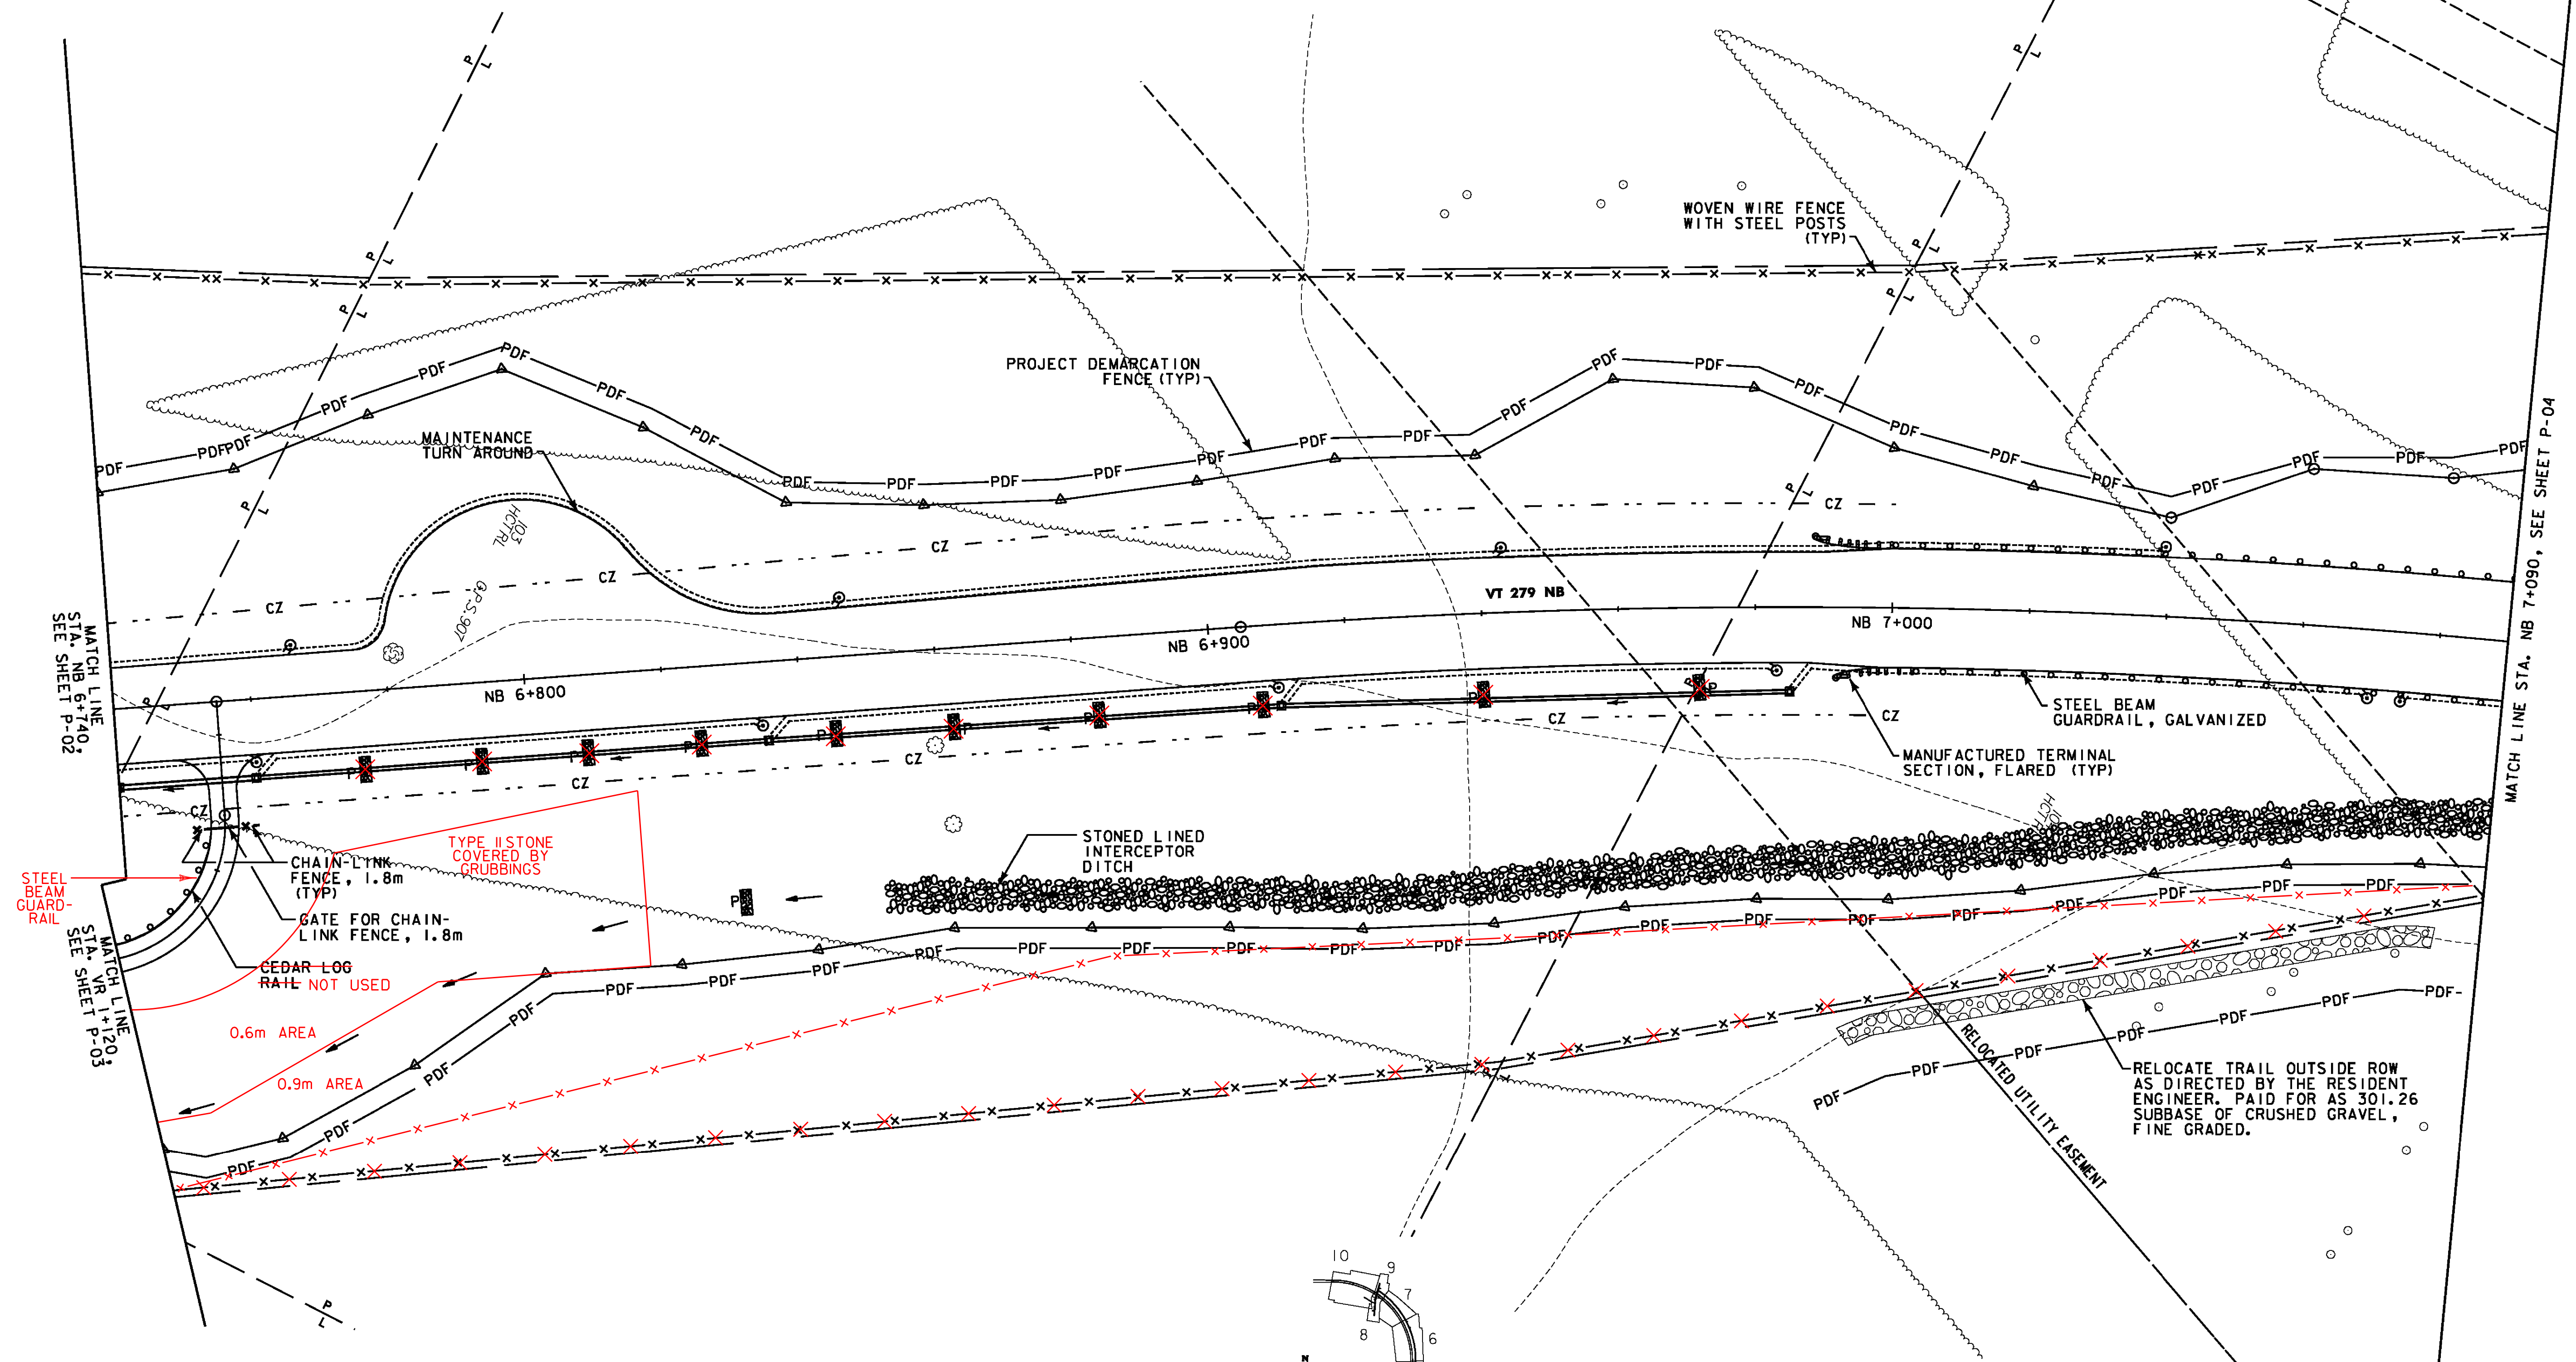

KEY MAP

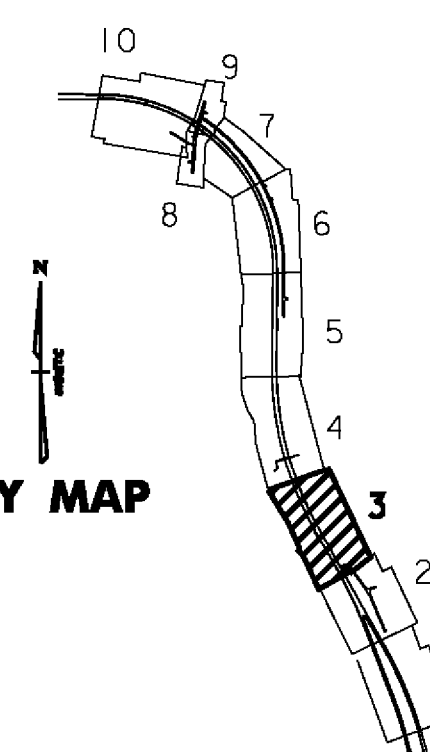

10 0 10 M
1:500 SCALE
9 FULL SIZE

VERMONT AGENCY OF TRANSPORTATION



PROJECT NAME:	BENNINGTON
PROJECT NUMBER:	AC NH 019-1(52)

FILE NAME: ...\\plot_files\\zd307c2p03.ptf
DESIGN SUPERVISOR: GREG EDWARDS
DESIGNED BY: MARC FOISY
GENERAL PLAN P-03

PLOT DATE: 5/16/2011
DRAWN BY: STANTEC
CHECKED BY: GARY SANTY
SHEET 73 OF 267

\\1953\active\195310002\transportation\drawing\contract_2\plot_files\zd307c2p03.ptf