

WOVEN WIRE FENCE WITH STEEL POSTS
STA. NB 7+780.000, 54.0m LT. - STA. NB 8+090.000, 54.0m LT.

CONSTRUCT DRIVE
STA. QR 1+433.342, RT (7.2m GRAVEL)
STA. QR 1+480.047, RT (7.2m GRAVEL)

PROJECT DEMARCATION FENCE
STA. NB 7+780.000, 52.4m LT. - STA. NB 8+090.000, 46.2m LT.
STA. NB 8+046.000, 17.0m LT. - STA. NB 8+090.000, 46.0m LT.
STA. NB 8+046.000, 17.0m LT. - STA. NB 8+090.000, 28.0m LT.
STA. QR 1+190.000, 16.0m RT. - STA. QR 1+427.000, 12.0m RT.
STA. QR 1+442.000, 12.8m RT. - STA. QR 1+475.000, 11.8m RT.
STA. QR 1+487.000, 12.6m RT. - STA. QR 1+510.000, 12.7m RT.



MANUFACTURED TERMINAL SECTION, FLARED
STA. NB 7+799.000, 8.7m LT. - STA. NB 7+799.000, 8.7m LT.
STEEL BEAM GUARDRAIL, GALVANIZED
STA. NB 7+780.000, 8.7m LT. - STA. NB 7+799.000, 8.7m LT.

REMOVAL OF EXISTING FENCE
STA. NB 7+940.000, 40.0m RT. - STA. NB 7+970.048, 54.0m LT.

GATE FOR CHAIN-LINK FENCE, 1.8m
STA. QR 1+420, 3.0m LT - 3.0m RT

CHAIN-LINK FENCE, 1.8 M
STA. QR 1+190.000, 7.4m LT. - STA. QR 1+510.000, 7.4m LT.
STA. QR 1+420.000, 3.0m LT. - 7.4m LT.
STA. QR 1+420.000, 3.0m RT. - 8.9m RT.

Metric

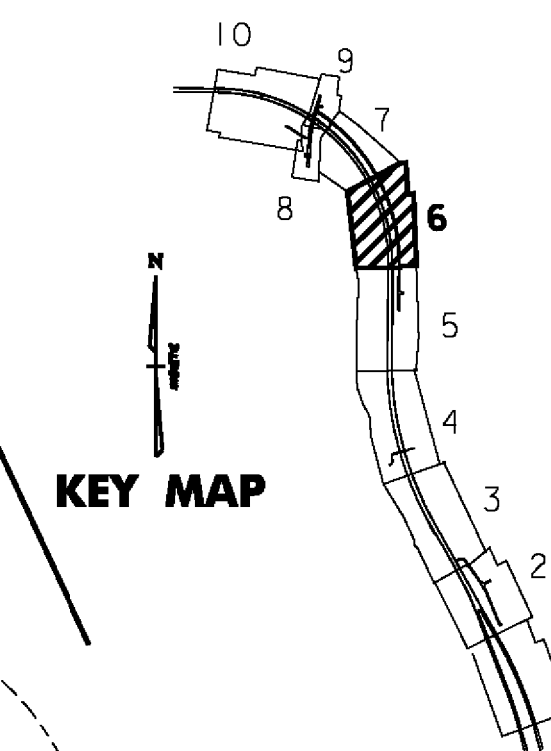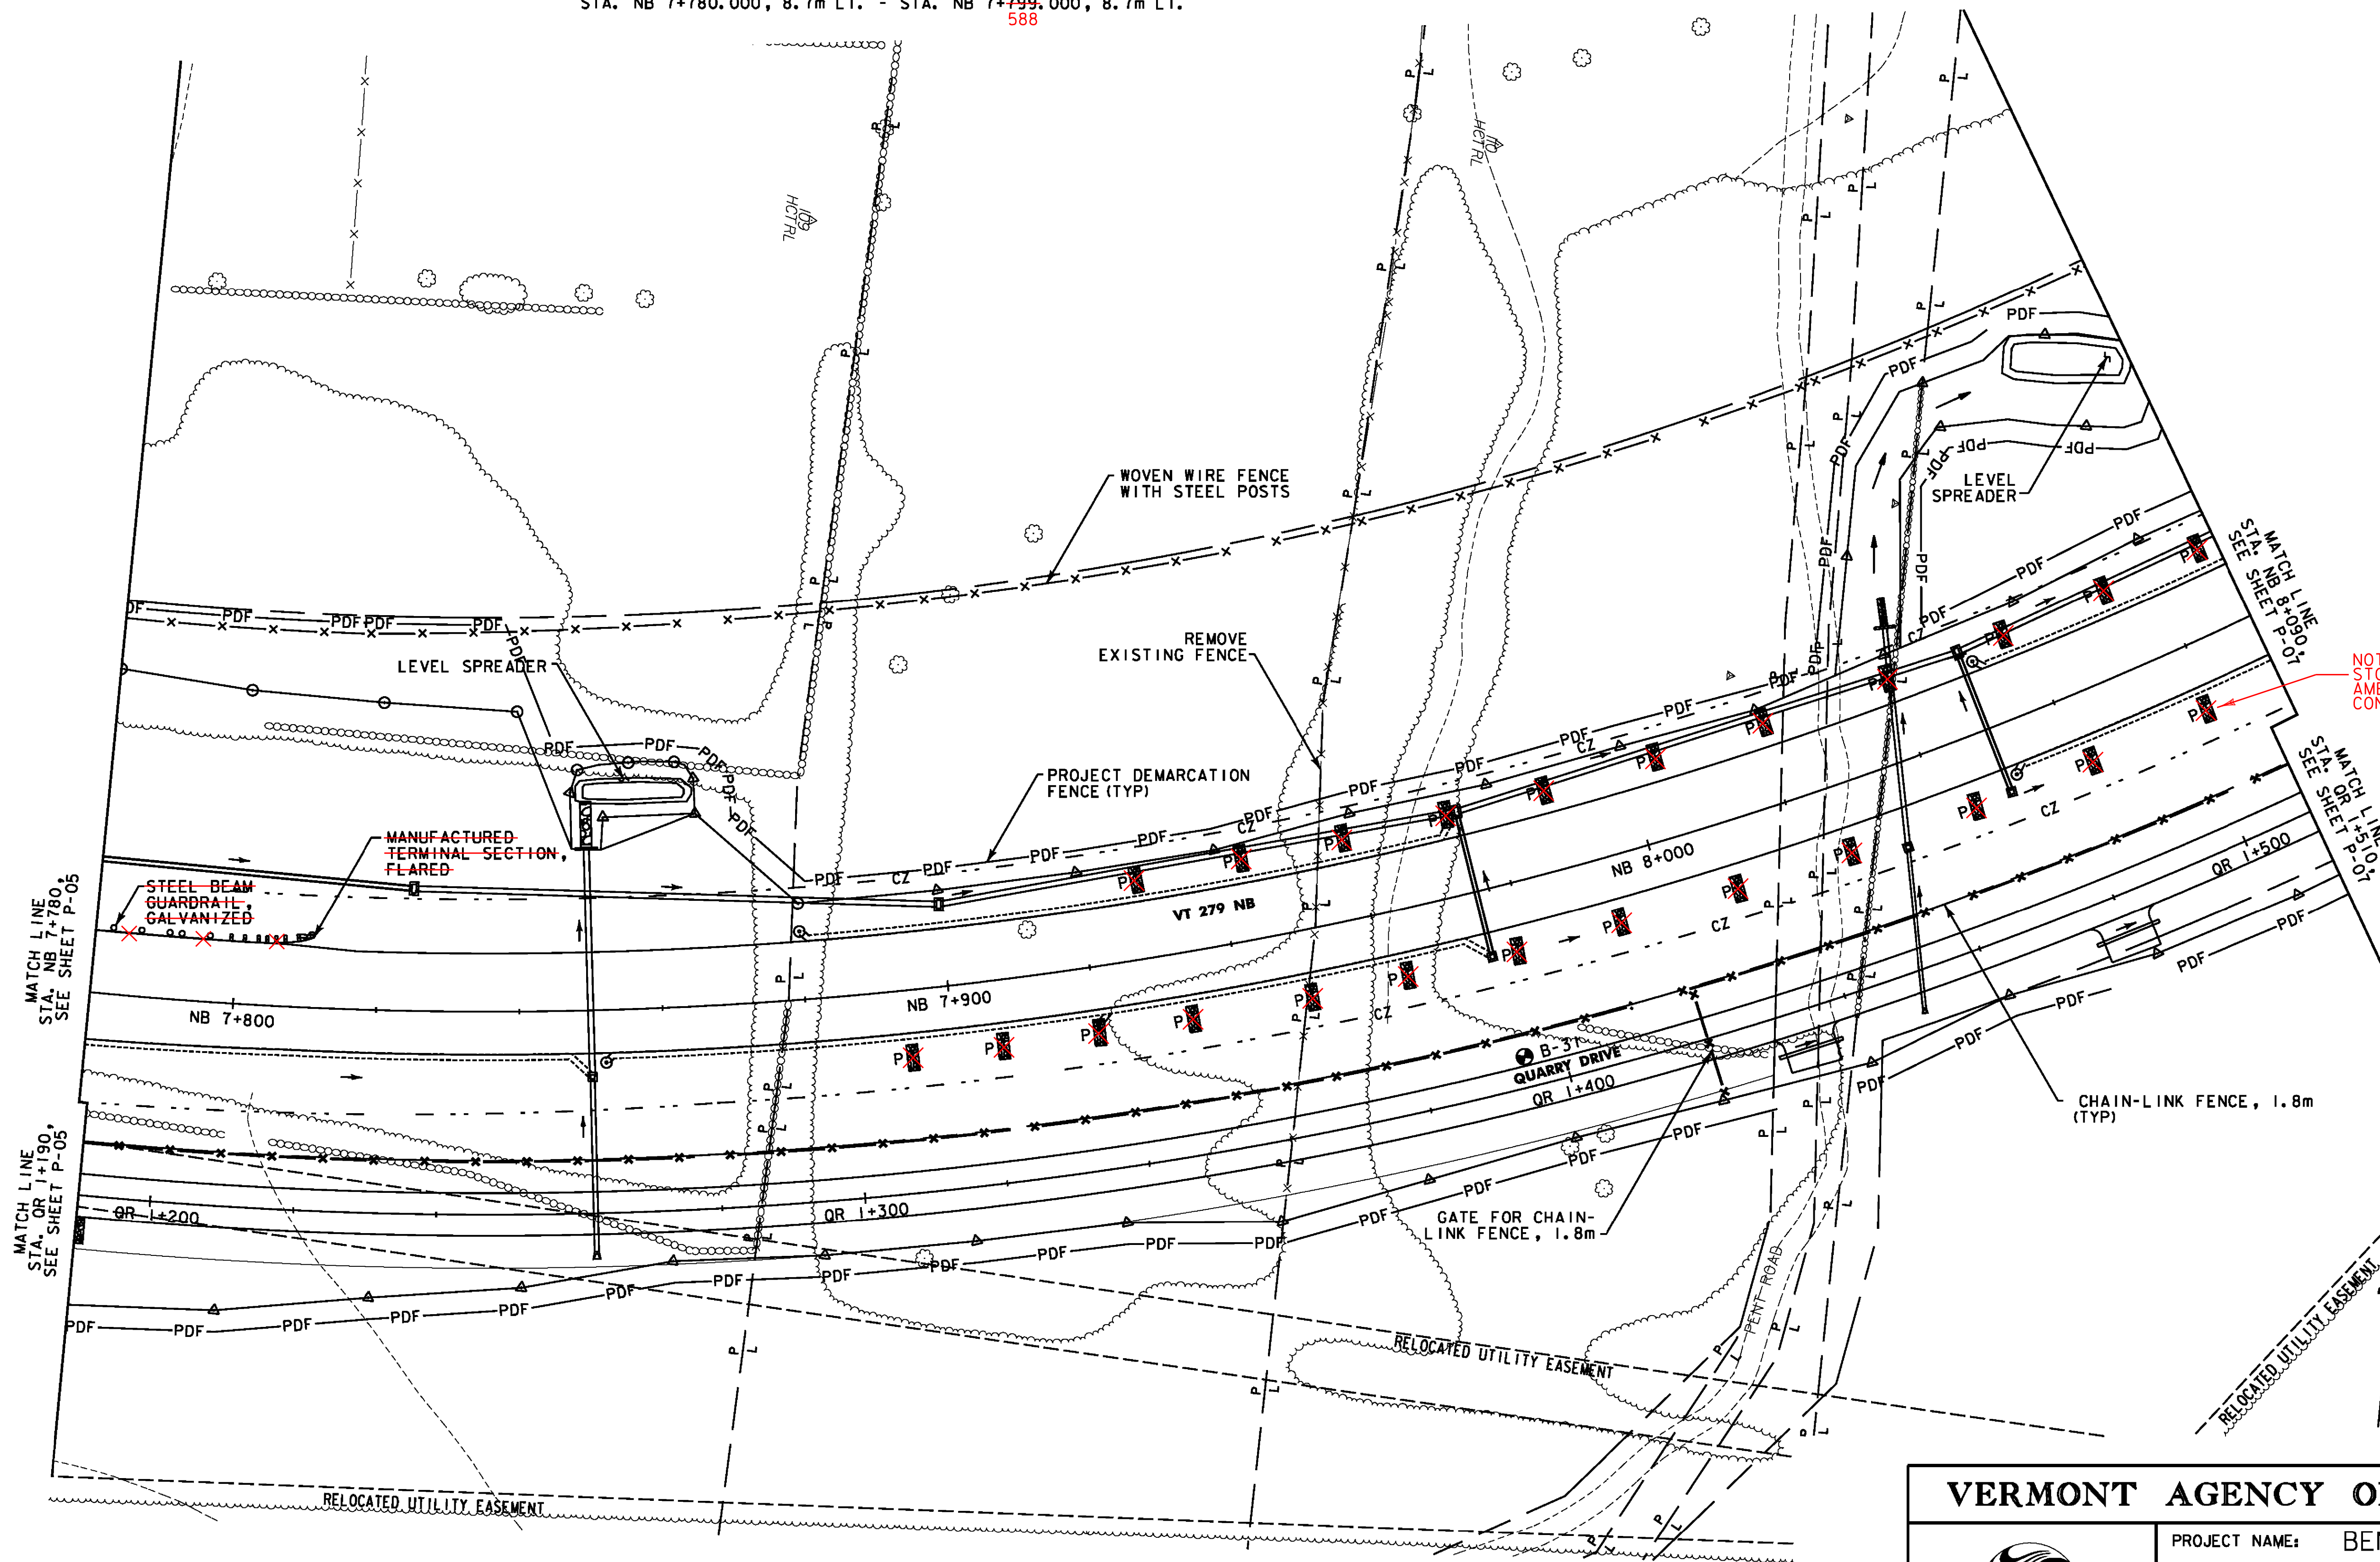

VERMONT AGENCY OF TRANSPORTATION



PROJECT NAME: BENNINGTON
PROJECT NUMBER: AC NH 019-1(52)

FILE NAME: ...\\plot-files\\zd307c2p06.prf
DESIGN SUPERVISOR: GREG EDWARDS
DESIGNED BY: MARC FOISY
GENERAL PLAN P-06

PLOT DATE: 5/16/2011
DRAWN BY: STANTEC
CHECKED BY: GARY SANTY
SHEET 76 OF 267

10 0 10 M
1:500 SCALE
= FULL SIZE