


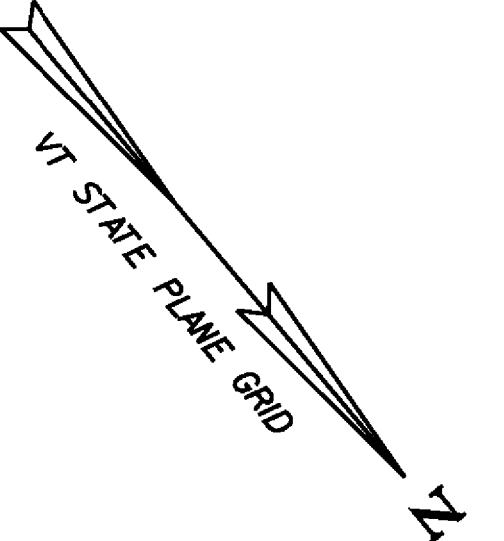

WOVEN WIRE FENCE WITH STEEL POSTS
STA. NB 8+090.000, 54.0m LT. - STA. NB 8+305.480, 53.4m LT.

PROJECT DEMARCATION FENCE
STA. NB 8+090.000, 19.0m LT. - STA. NB 8+247.000, 114.0m LT.
STA. QR 1+510.000, 12.7m RT. - STA. QR 1+745.000, 15.1m RT.

CHAIN-LINK FENCE, 1.8 M
STA. QR 1+510.000, 7.4m LT. - STA. QR 1+750.000, 7.4m LT.

BITUMINOUS CONCRETE CURB, TYPE A
STA. NB 8+201.015, 8.7m LT. - STA. NB 8+307.394, 8.7m LT.
~~220.000~~ ~~310~~



MANUFACTURED TERMINAL SECTION, FLARED
STA. NB 8+135.029, 6.6m RT.
STA. NB 8+197.169, 8.7m LT.
~~218.000~~

136 STEEL BEAM GUARDRAIL, GALVANIZED 320
STA. NB 8+135.029, 6.6m RT. - STA. NB 8+340.000, 6.6m RT.
STA. NB 8+197.169, 8.7m LT. - STA. NB 8+310.000, 8.7m LT.
~~218.000~~

SPECIAL PROVISION (DECOMMISSION WATER WELL)
STA. QR 1+730.295, RT.

DEMOLITION AND DISPOSAL OF BUILDING
STA. NB 8+301.599, RT.

NOT INSTALLED
STORMWATER
AMENDMENT UNDER
CONTRACT '51

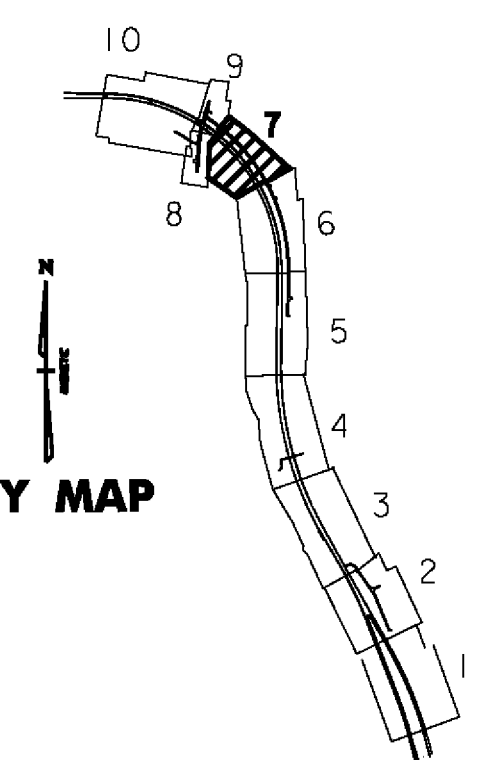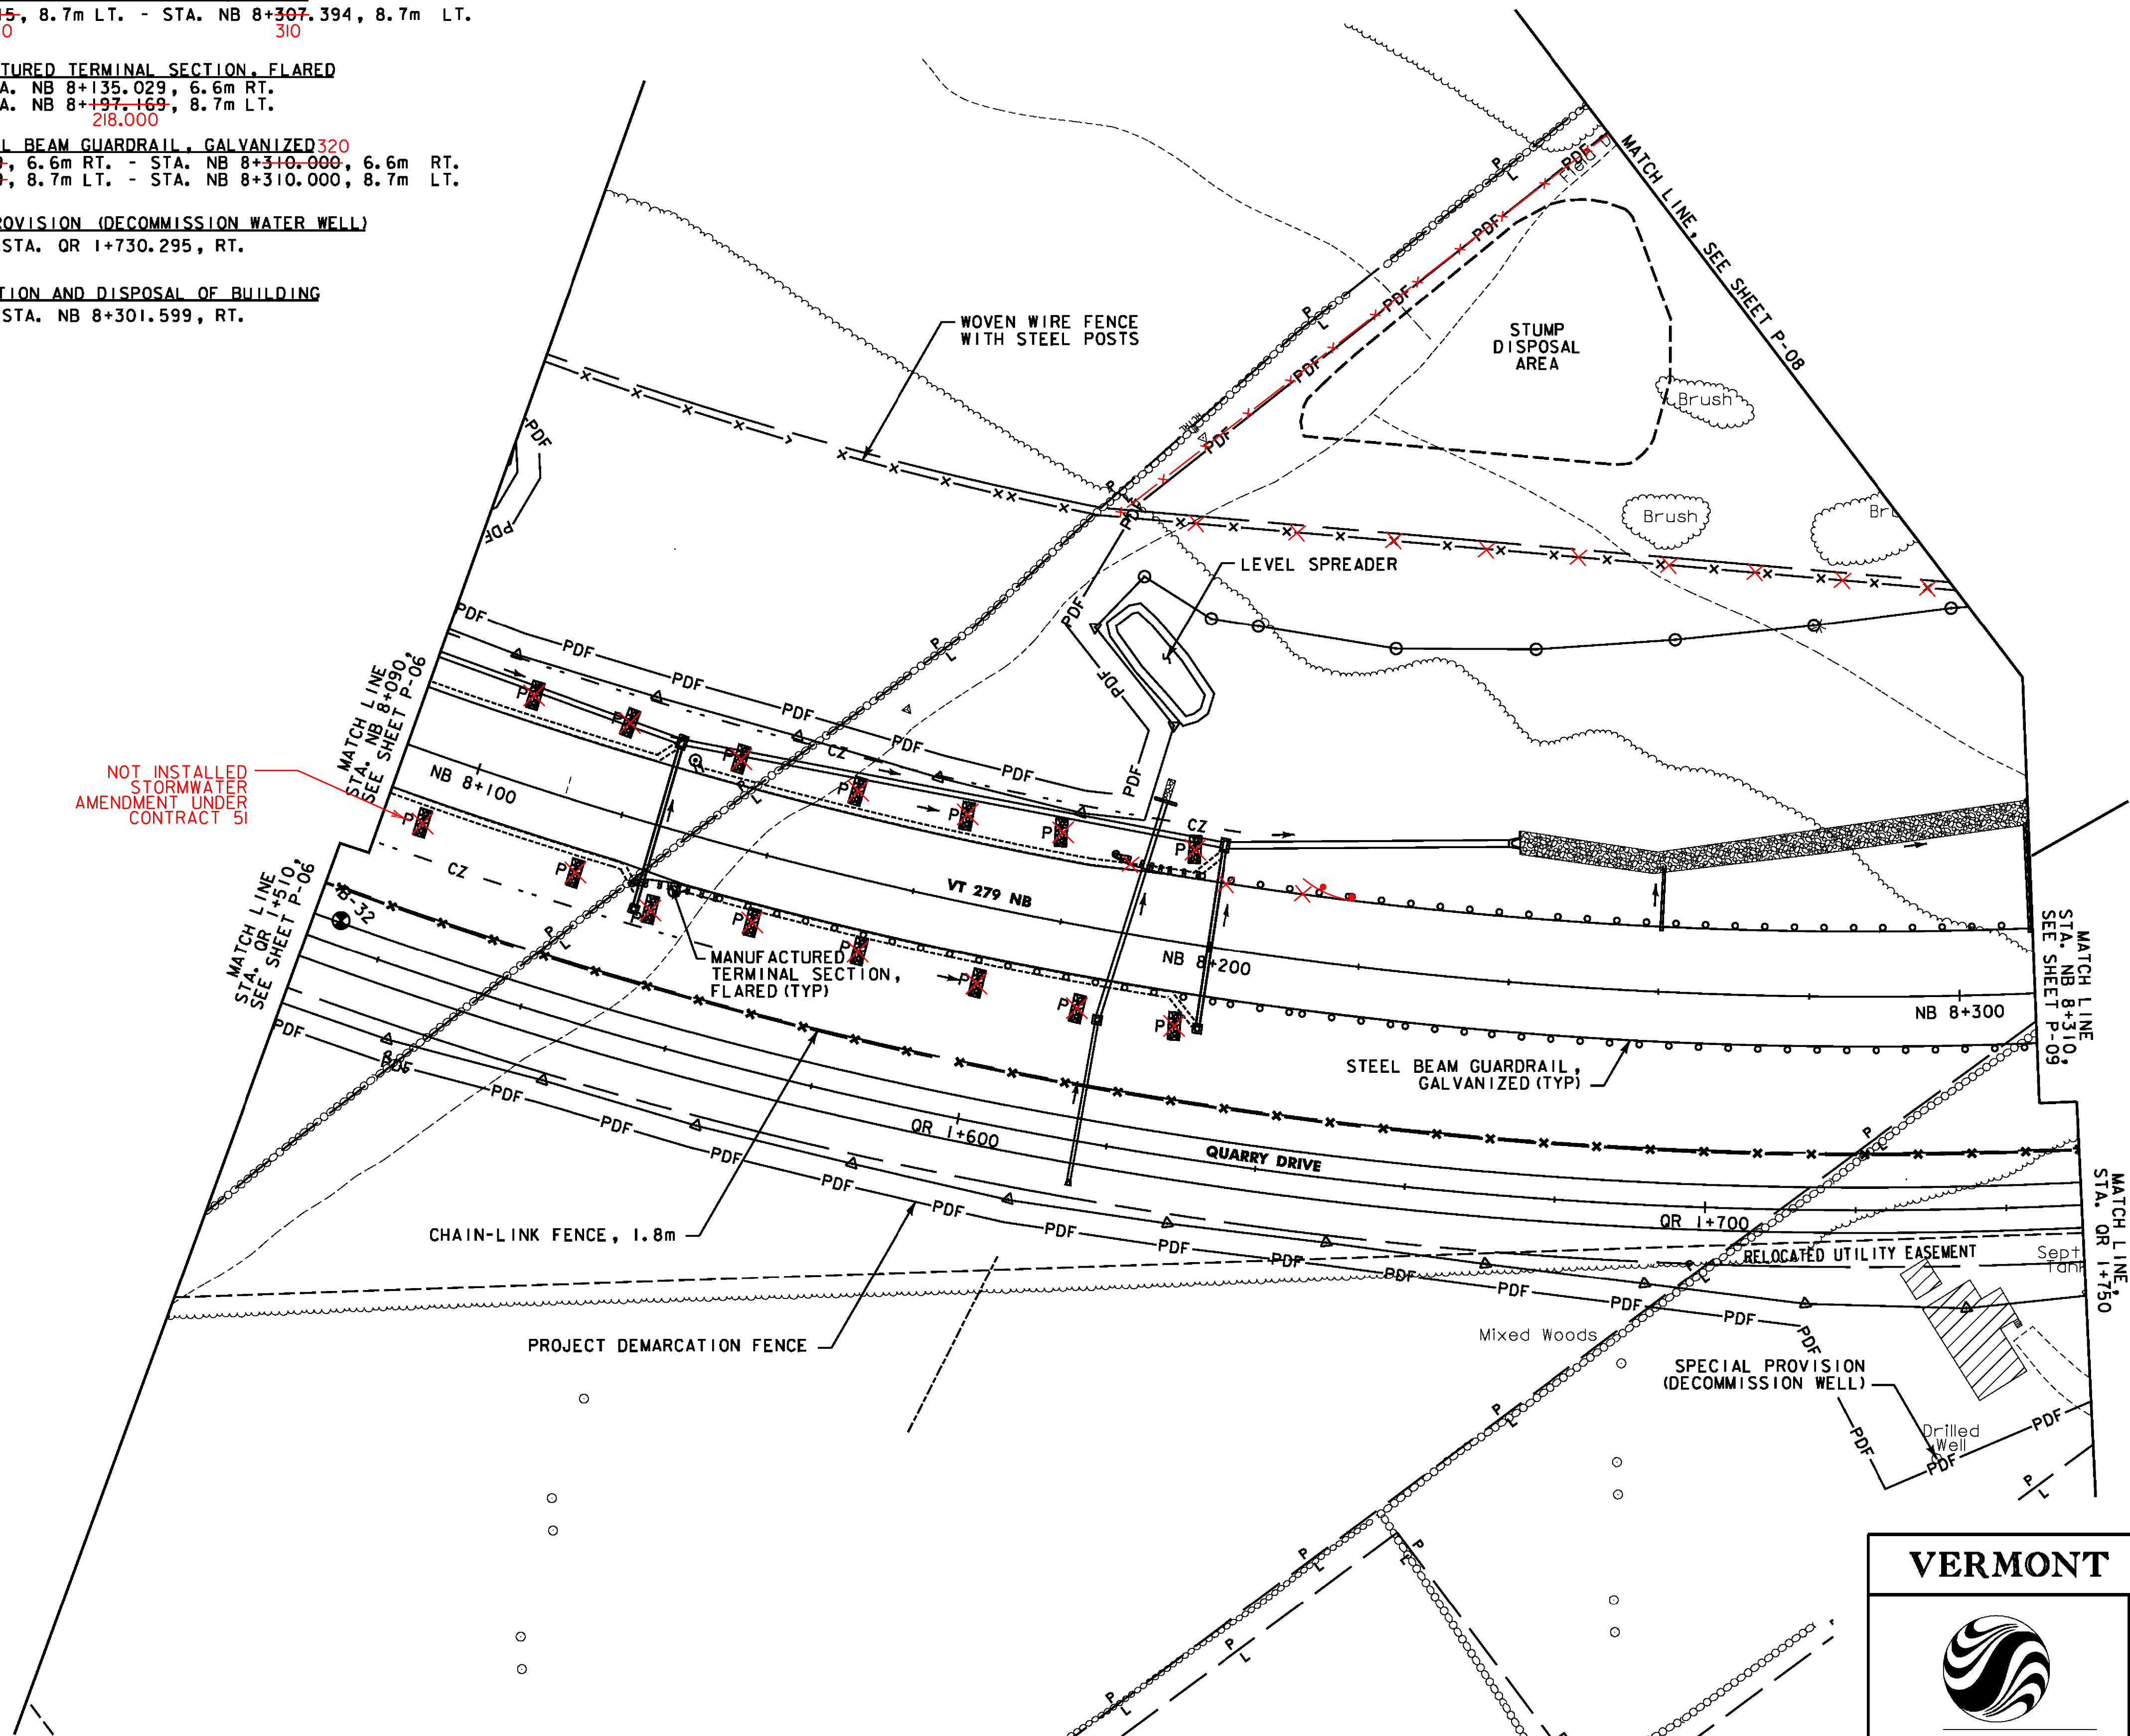

10 0 10 M
1:500 SCALE
● FULL SIZE

VERMONT AGENCY OF TRANSPORTATION



PROJECT NAME: BENNINGTON	PLLOT DATE: 5/16/2011
PROJECT NUMBER: AC NH 019-1(52)	DRAWN BY: STANTEC
FILE NAME: ...plot.files\zd307c2p07.ptf	CHECKED BY: GARY SANTY
DESIGN SUPERVISOR: GREG EDWARDS	SHEET 77 OF 267
DESIGNED BY: MARC FOISY	
GENERAL PLAN P-07	