


DRIVE GATE FOR WOVEN WIRE FENCE
STA. DR 1+012.033, 2.5m LT. - 2.5m RT.
WOVEN WIRE FENCE WITH STEEL POSTS
STA. DR 1+012.033, 2.5m LT. - 8.2m LT.
STA. DR 1+012.033, 2.5m RT. - 8.5m RT.

CONSTRUCT DRIVE
STA. CH 1+261.410, LT. (8.4 m GRAVEL)
STA. DR 1+004.466 - STA. DR 1+050.000 (3.6 m GRAVEL)
REMOVAL OF EXISTING FENCE
STA. CH 1+343.117, LT. - CH 1+348.737, LT.

PROJECT DEMARCATION FENCE
STA. CH 1+236.000, 6.0m RT. - STA. CH 1+238.000, 19.5m RT.
STA. CH 1+285.000, 14.3m LT. - STA. CH 1+310.000, 14.9m LT.
STA. CH 1+330.845, 11.9m LT. - STA. CH 1+342.670, 8.1m LT.
STA. DR 1+011.346, RT. - STA. DR 1+050.000, RT.
STA. DR 1+014.307, LT. - STA. DR 1+050.000, LT.


RELOCATE MAILBOX, SINGLE SUPPORT
STA. CH 1+269.000, LT.

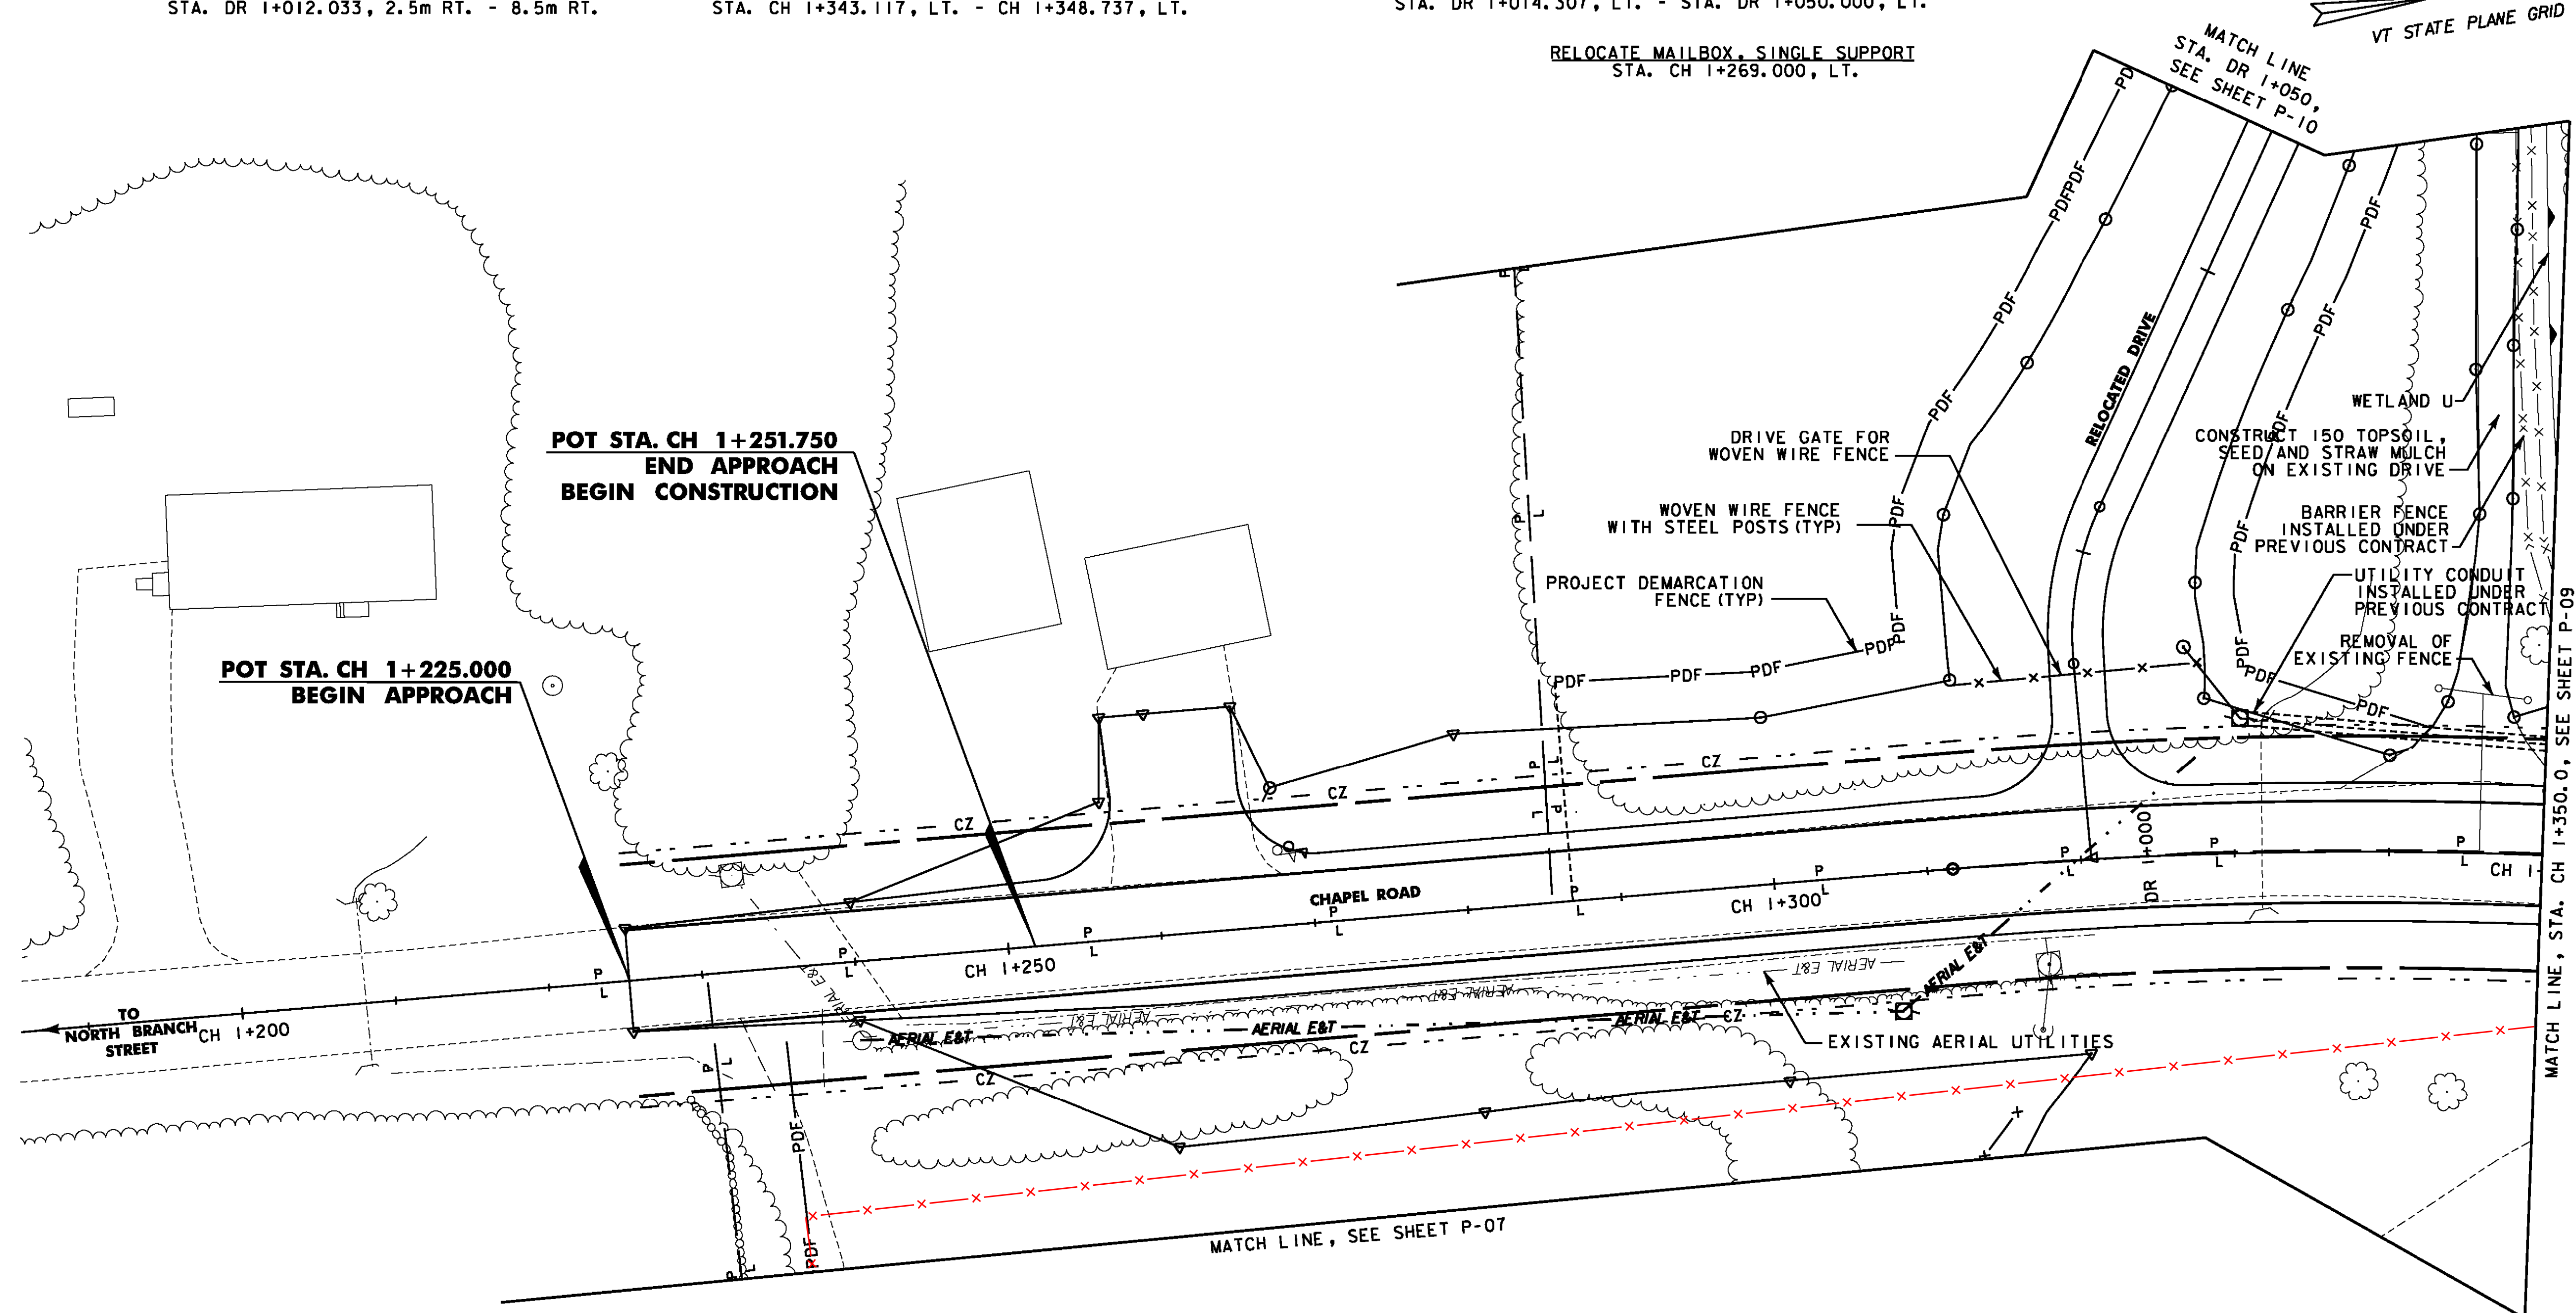

POT STA. CH 1+225.000
BEGIN APPROACH

POT STA. CH 1+251.750
END APPROACH
BEGIN CONSTRUCTION

MATCH LINE, SEE SHEET P-07

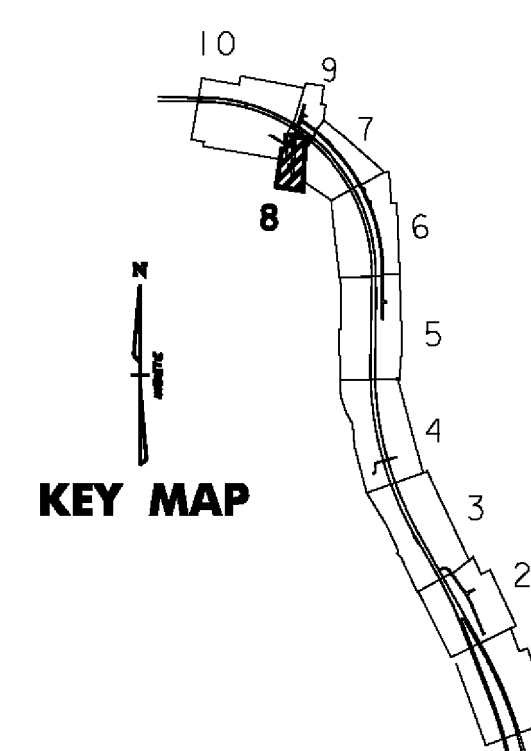

5 0 5
1:250 SCALE
● FULL SIZE

VERMONT AGENCY OF TRANSPORTATION



PROJECT NAME:	BENNINGTON
PROJECT NUMBER:	AC NH 019-1(52)
FILE NAME:	...\\plot-files\\zd307c2p08.prf
DESIGN SUPERVISOR:	GREG EDWARDS
DESIGNED BY:	MARC FOISY
GENERAL PLAN	P-08
PLOT DATE:	5/16/2011
DRAWN BY:	STANTEC
CHECKED BY:	GARY SANTY
SHEET	78 OF 267