

CONSTRUCT DRIVE
STA. CH 1+430.563, RT. (4.4 m GRAVEL)

BARRIER FENCE
STA. CH 1+420.000 - CH 1+470.000, LT.

PROJECT DEMARCATION FENCE
STA. QR 1+750.000, 12.9m RT. - STA. QR 1+782.687, 19.6m RT.

GATE FOR CHAIN-LINK FENCE, 1.8m
STA. QR 1+784.602, 3.6m LT. - STA. QR 1+786.567, 3.6m RT.

CHAIN-LINK FENCE, 1.8m
STA. QR 1+750.000, 7.4m LT. - STA. QR 1+786.551, 7.4m LT.
STA. QR 1+783.551, 7.4m LT. - STA. QR 1+784.602, 3.6m LT.
STA. QR 1+786.567, 3.6m RT. - STA. QR 1+787.498, 7.1m RT.

STONE FILL, TYPE II
STA. NB 8+369.000, LT. - STA. NB 8+390.000, LT. (FOR SLOPE STABILIZATION)
STA. NB 8+375.000, RT. - STA. NB 8+390.000, RT. (FOR SLOPE STABILIZATION)


GRUBBING MATERIAL
STA. NB 8+369.000, LT. - STA. NB 8+390.000, LT. (FOR SLOPE STABILIZATION)
STA. NB 8+375.000, RT. - STA. NB 8+390.000, RT. (FOR SLOPE STABILIZATION)

STEEL BEAM GUARDRAIL, GALVANIZED
STA. NB 8+310.000, 8.7m LT. - STA. NB 8+310.790, 8.7m LT.
STA. NB 8+310.000, 6.6m RT. - STA. NB 8+316.790, 6.6m RT.
STA. NB 8+377.340, 8.7m LT. - STA. NB 8+390.000, 8.7m LT.
STA. NB 8+383.110, 6.6m RT. - STA. NB 8+390.000, 6.6m RT.

SPECIAL PROVISION (REMOVE AND STOCKPILE STONE WALL)
STA. CH 1+435.7, RT. - STA. CH 1+459.9, RT.

BITUMINOUS CONCRETE CURB, TYPE A
STA. NB 8+380.736, 8.7m LT. - STA. NB 8+390.000, 8.7m LT.

SPECIAL PROVISION (DECOMMISSION OBSERVATION WELL)
STA. NB 8+390.000, 35.0m LT.

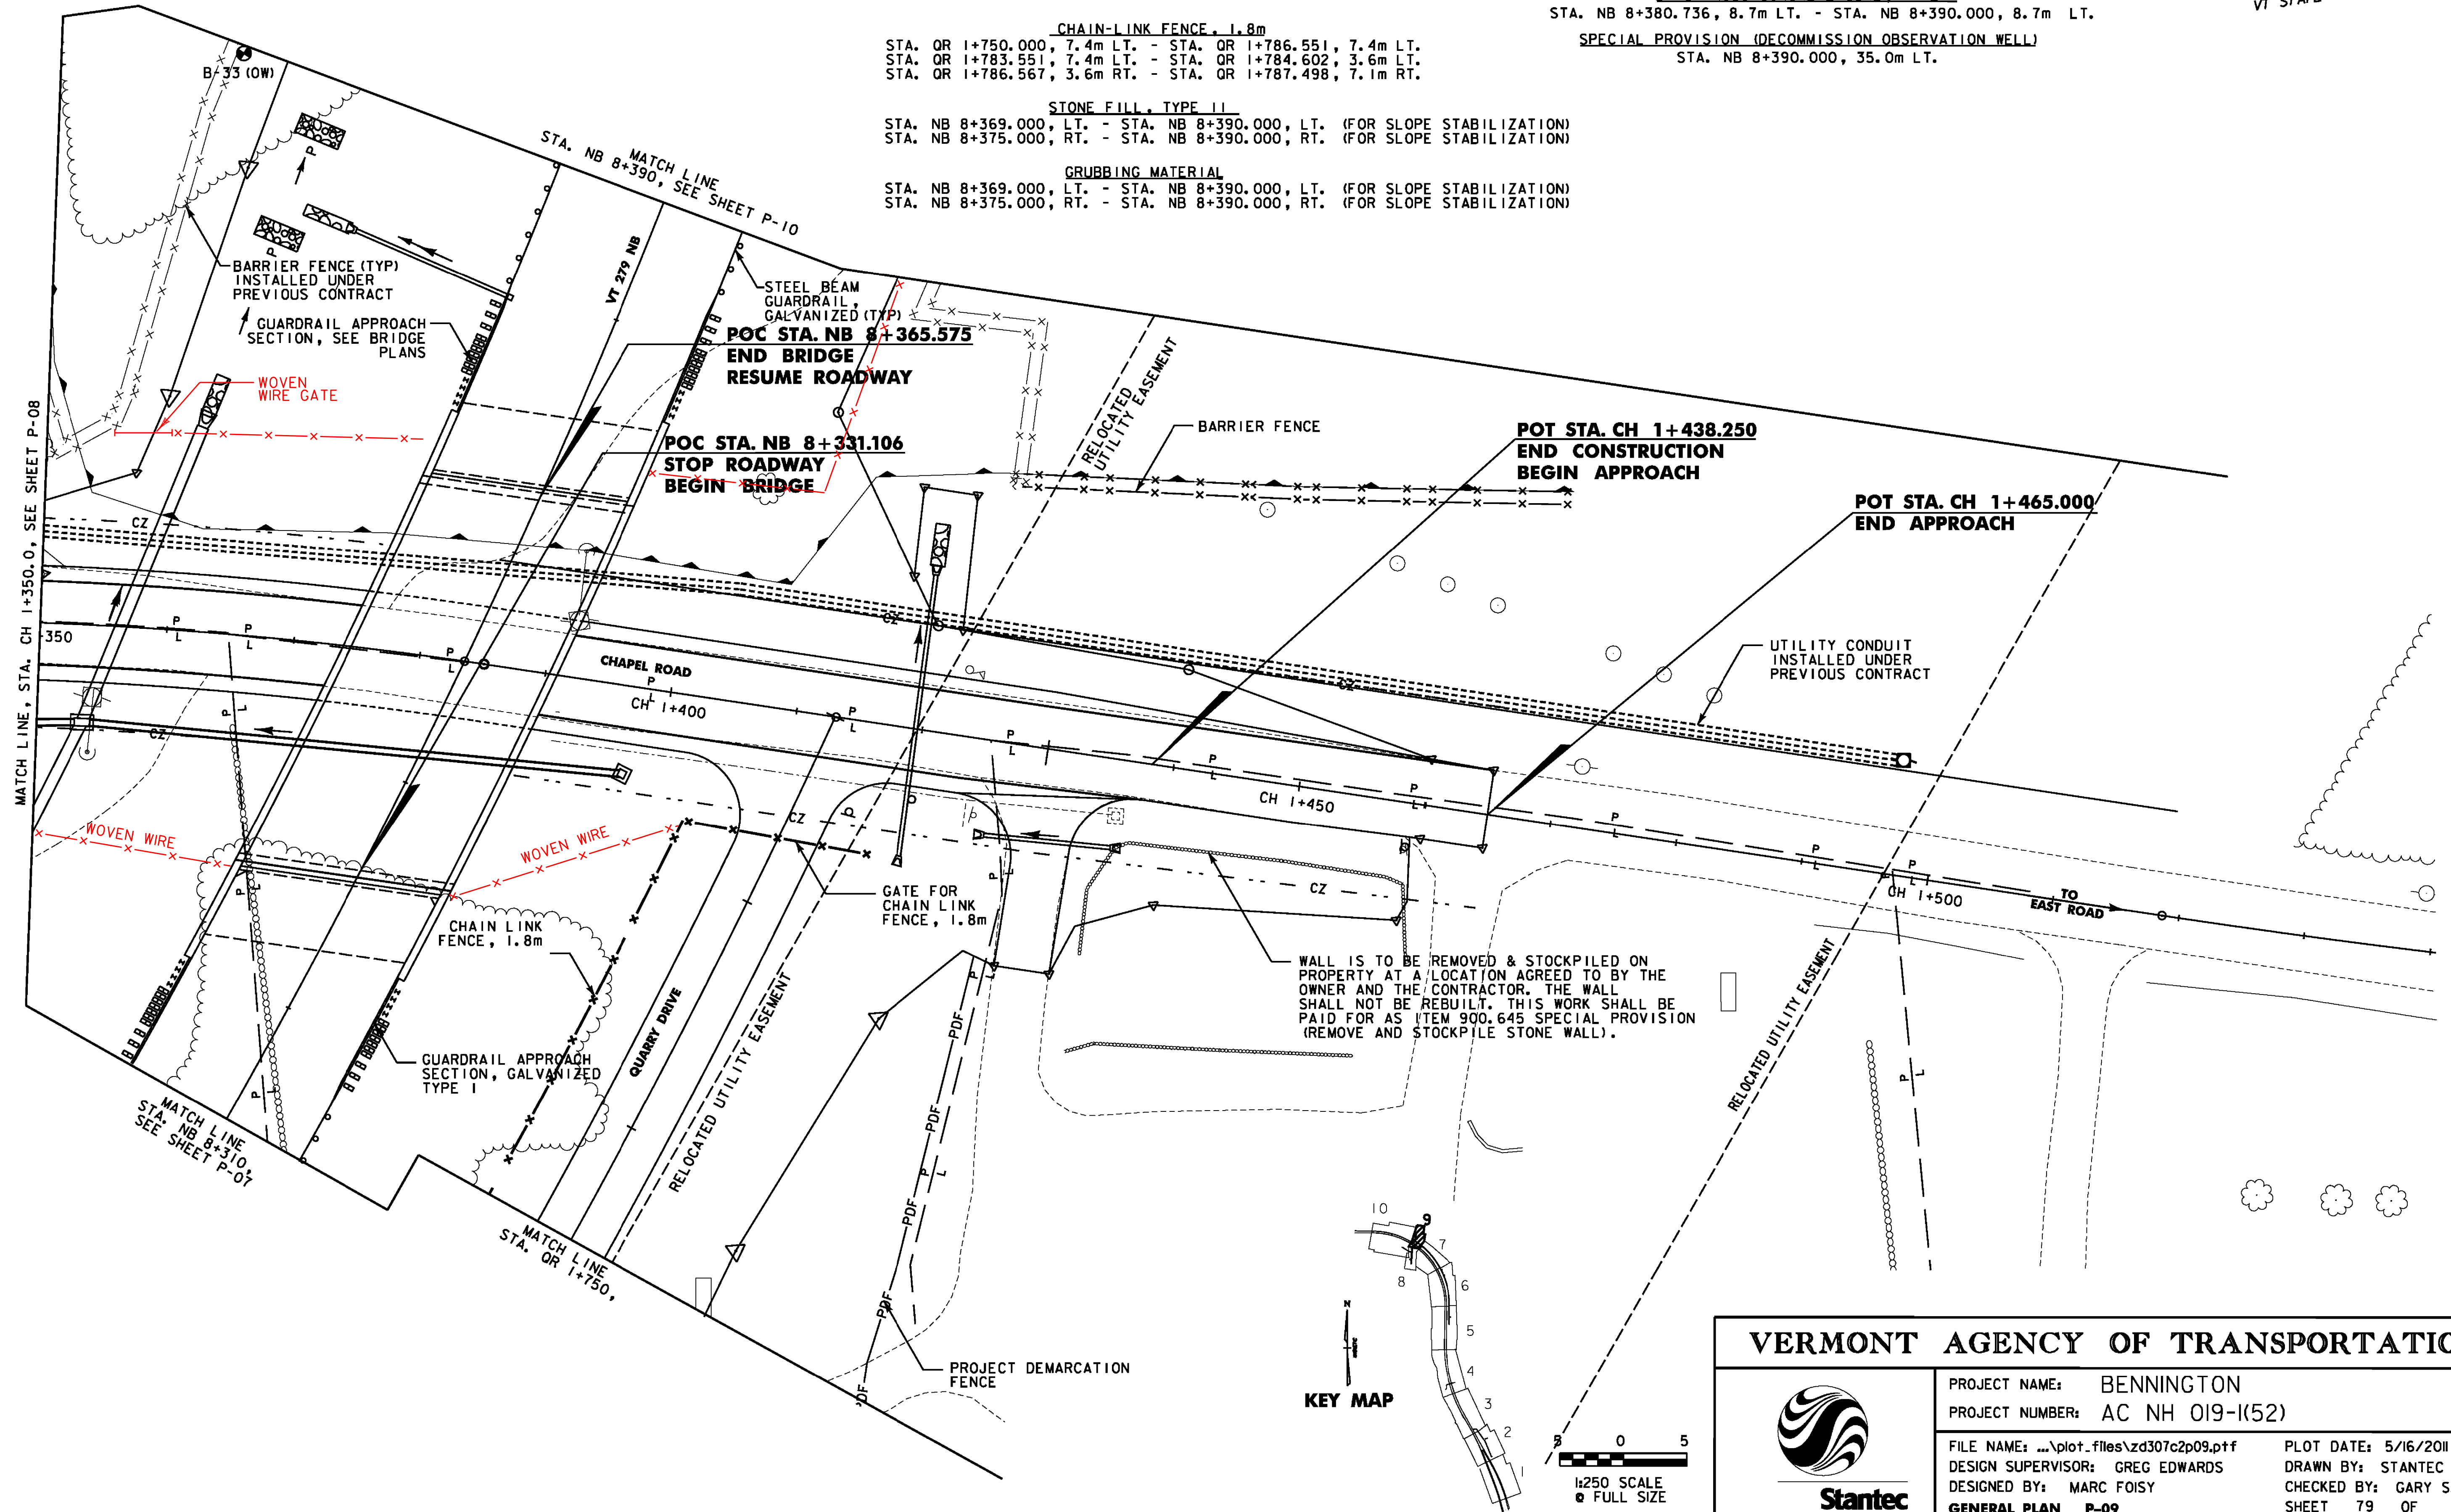

VERMONT AGENCY OF TRANSPORTATION



PROJECT NAME: BENNINGTON
PROJECT NUMBER: AC NH 019-1(52)

FILE NAME: \\plot-files\zd307c2p09.pff
DESIGN SUPERVISOR: GREG EDWARDS
DESIGNED BY: MARC FOISY
GENERAL PLAN P-09

PLOT DATE: 5/16/2011
DRAWN BY: STANTEC
CHECKED BY: GARY SANTY
SHEET 79 OF 267