




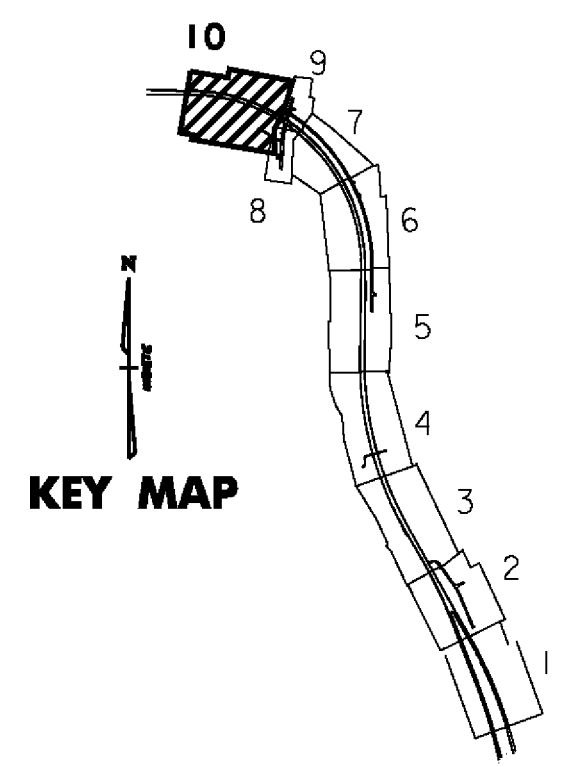

VERMONT AGENCY OF TRANSPORTATION

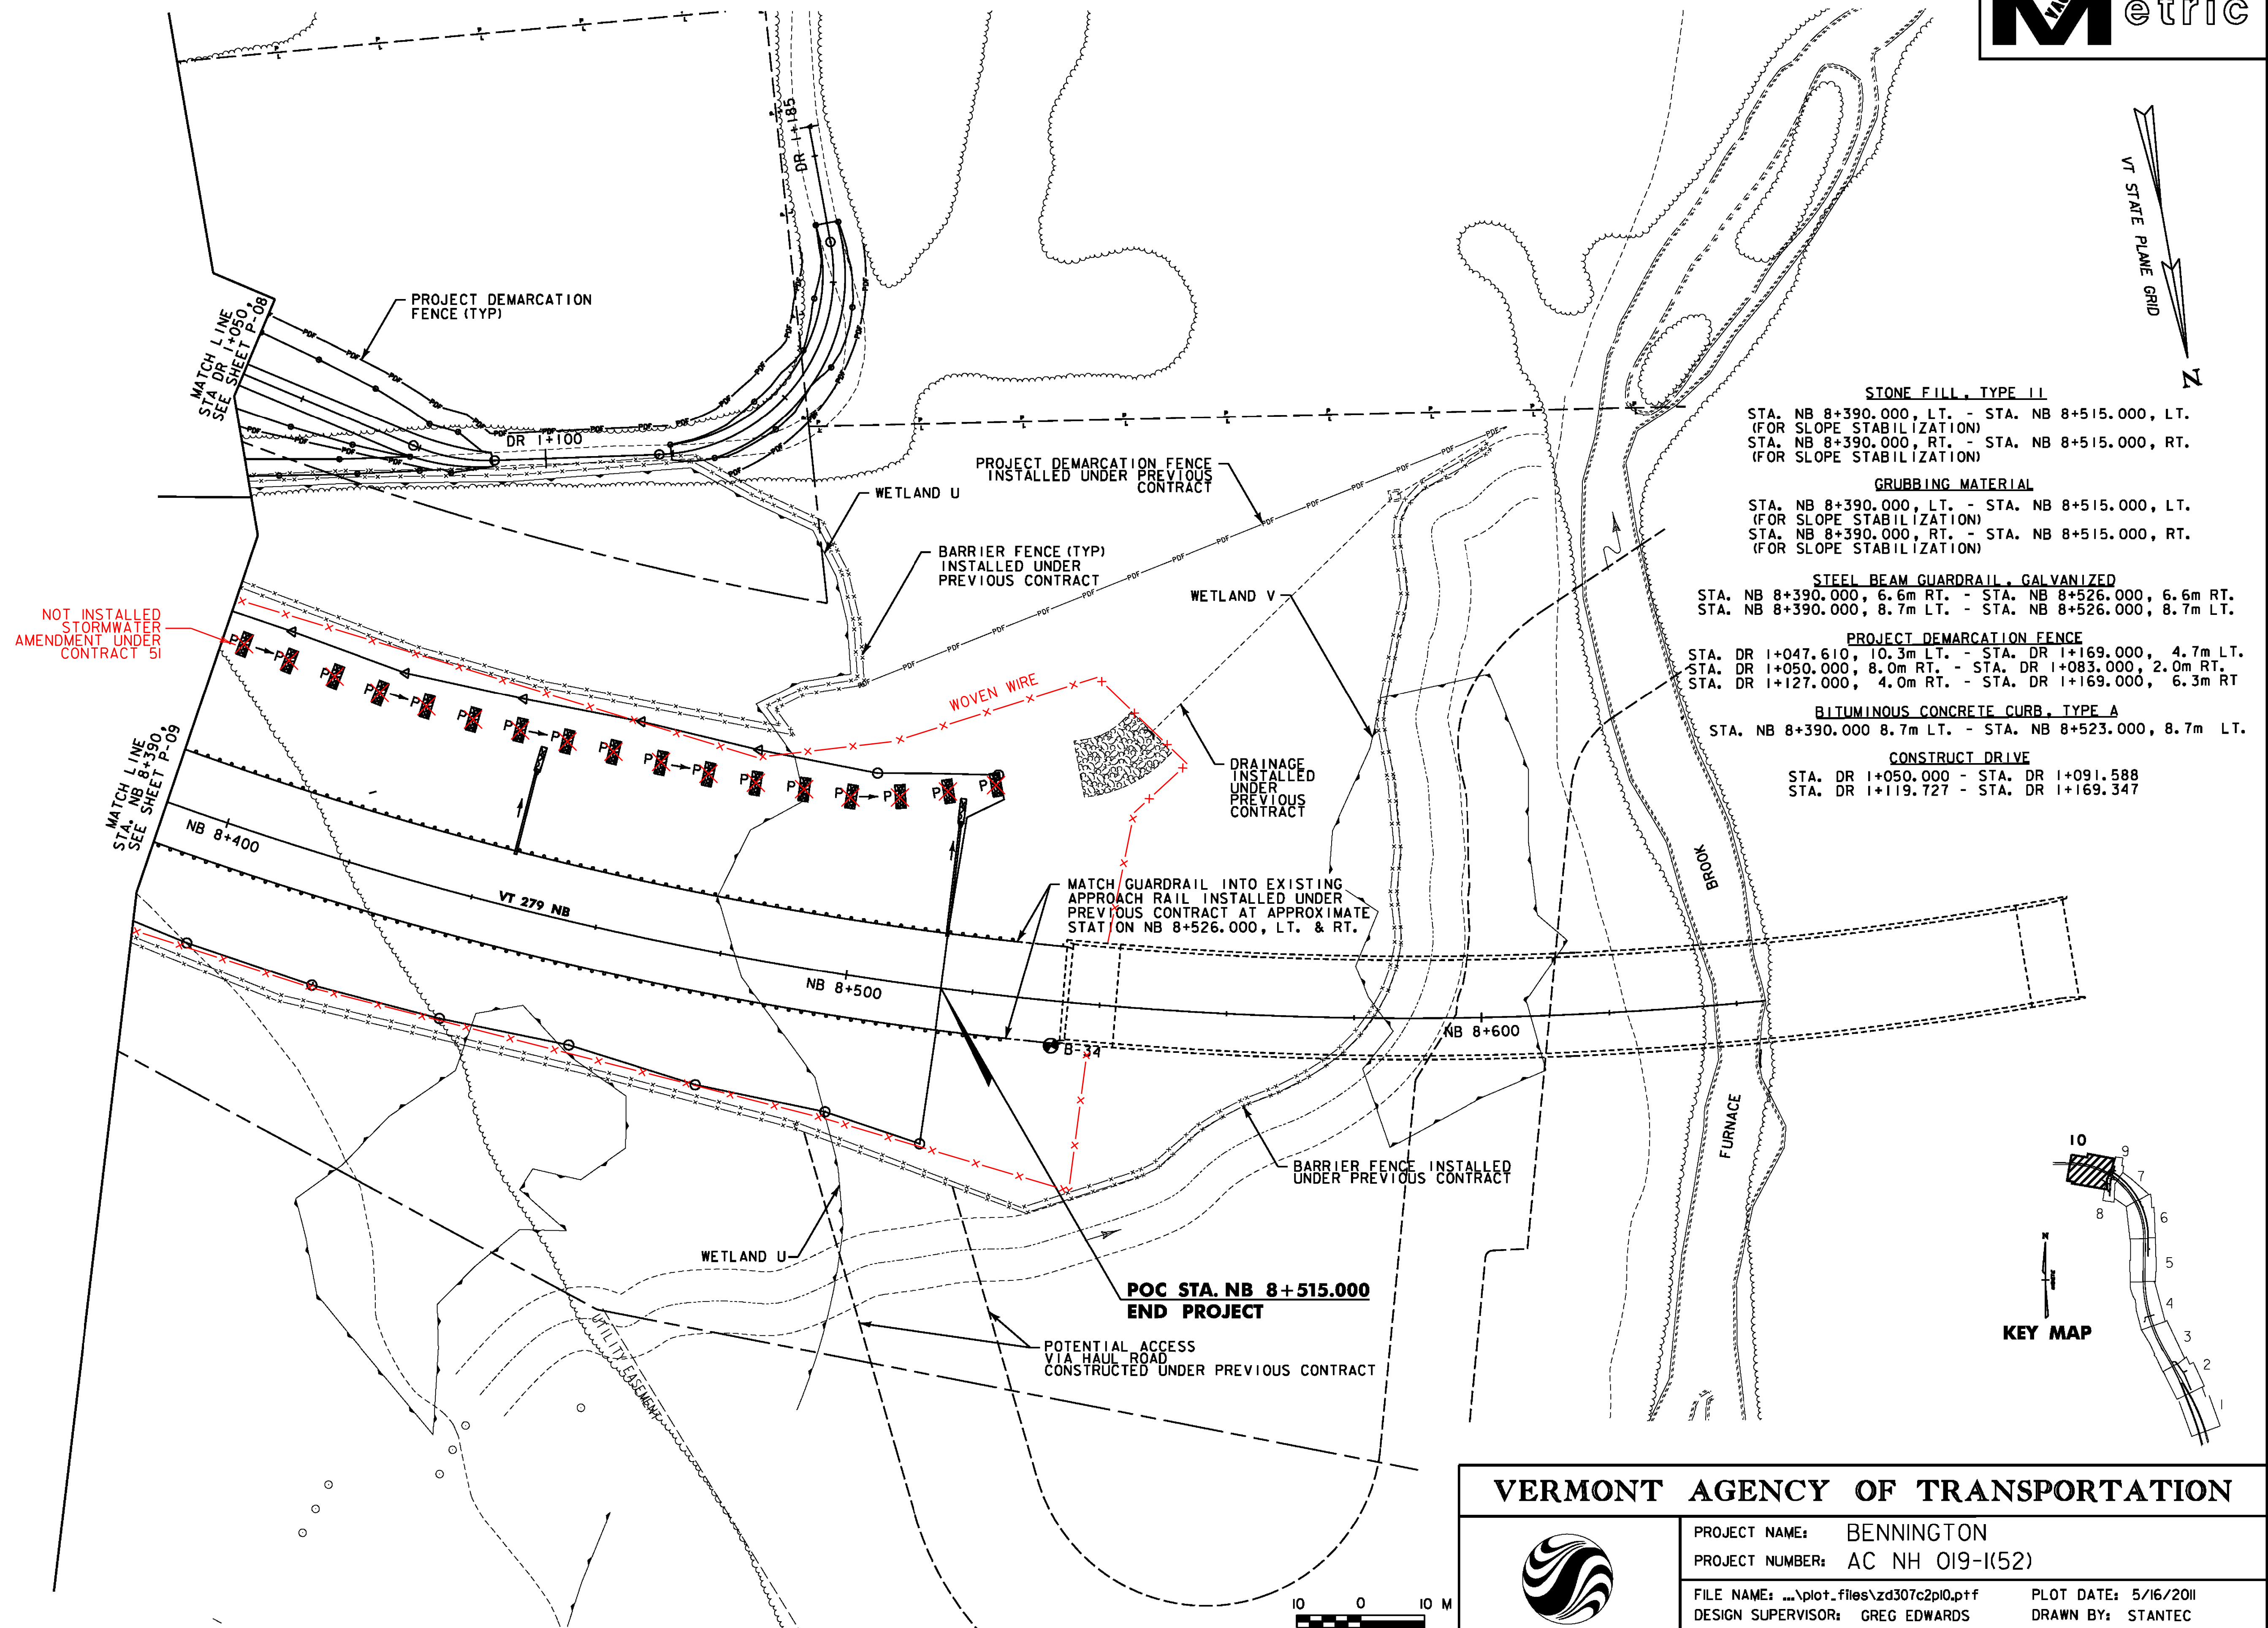

PROJECT NAME:	BENNINGTON
PROJECT NUMBER:	AC NH 019-1(52)
FILE NAME:	...plot.files\zd307c2p10.prf
DESIGN SUPERVISOR:	GREG EDWARDS
DESIGNED BY:	MARC FOISY
CHECKED BY:	GARY SANTY
GENERAL PLAN	P-10
PLOT DATE:	5/16/2011
DRAWN BY:	STANTEC
SHEET	80 OF 267

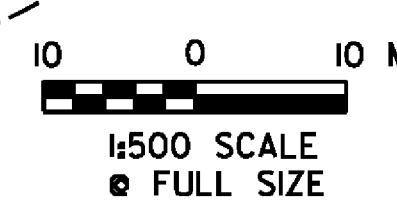

V:\953\active\95310002\transportation\drawing\contract\2\plot_files\zd307c2p10.prf