


LEGEND

	DECIDUOUS SHRUB GROUPING WITH PLANT TYPE AND (QUANTITY)		EXISTING DECIDUOUS TREE
	DECIDUOUS TREE GROUPING WITH PLANT TYPE AND (QUANTITY)		EXISTING EVERGREEN TREE
	EVERGREEN TREE GROUPING WITH PLANT TYPE AND (QUANTITY)		TOE OF SLOPE
			LIMIT OF CUT
			APPROXIMATE ULTIMATE TOE OF SLOPE
			APPROXIMATE ULTIMATE LIMIT OF CUT
			TREELINE
			R.O.W.

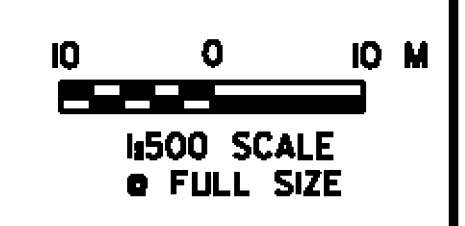

VERMONT AGENCY OF TRANSPORTATION

PROJECT NAME:	BENNINGTON - NORTH	PLANT DATE:	12/10/2007
PROJECT NUMBER:	BENNINGTON AC NH 019-1(52)	DESIGN SUPERVISOR:	J. BENSON
FILE NAME:	\\DGN\zd307c2p04.p1f	DESIGNED BY:	J. STEELE/C. BRODIE
LANDSCAPE PLAN:	L-05	CHECKED BY:	J. STEELE
			SHEET 144 OF

18/3463PC CONTRACT NO. 2306N303070204.d1f

NOTE: THIS SHEET TO BE USED FOR LANDSCAPING INFORMATION ONLY