



LEGEND

- AMC.O1 (9) DECIDUOUS SHRUB GROUPING WITH PLANT TYPE AND (QUANTITY)
- AR.O1 (3) DECIDUOUS TREE GROUPING WITH PLANT TYPE AND (QUANTITY)
- AC.O1 (4) EVERGREEN TREE GROUPING WITH PLANT TYPE AND (QUANTITY)
- EXISTING DECIDUOUS TREE
- EXISTING EVERGREEN TREE
- TOE OF SLOPE
- LIMIT OF CUT
- APPROXIMATE ULTIMATE TOE OF SLOPE
- APPROXIMATE ULTIMATE LIMIT OF CUT
- TREELINE
- R.O.W.

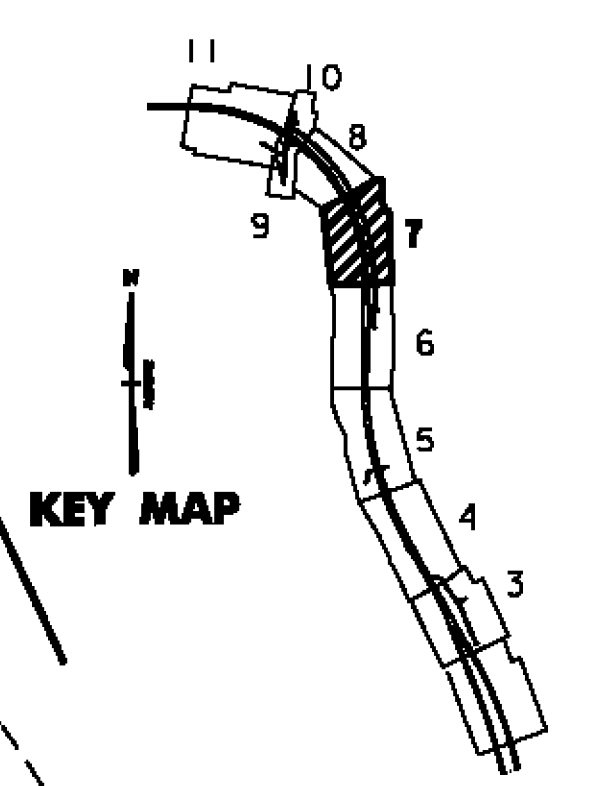

NOTE:
THIS SHEET TO BE USED FOR
LANDSCAPING INFORMATION ONLY

VERMONT AGENCY OF TRANSPORTATION	
	PROJECT NAME: BENNINGTON - NORTH
	PROJECT NUMBER: BENNINGTON AC NH 019-1(52)
FILE NAME: \DGN\zd307c2p06.pif	PLOT DATE: 12/10/2007
DESIGN SUPERVISOR: J. BENSON	DRAWN BY: E. SMALL
DESIGNED BY: J. STEELE/C. BRODIE	CHECKED BY: J. STEELE
LANDSCAPE PLAN L-07	SHEET 146 OF

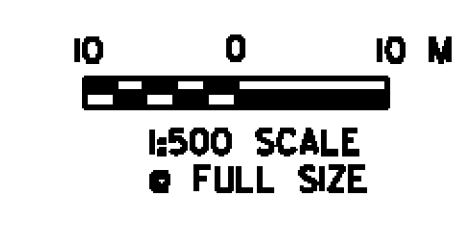

149463PC/CONTRACT NO. 2UD0Nvd307c2p06.dwt