



ABUTMENT 2 PLAN
SCALE 1:50

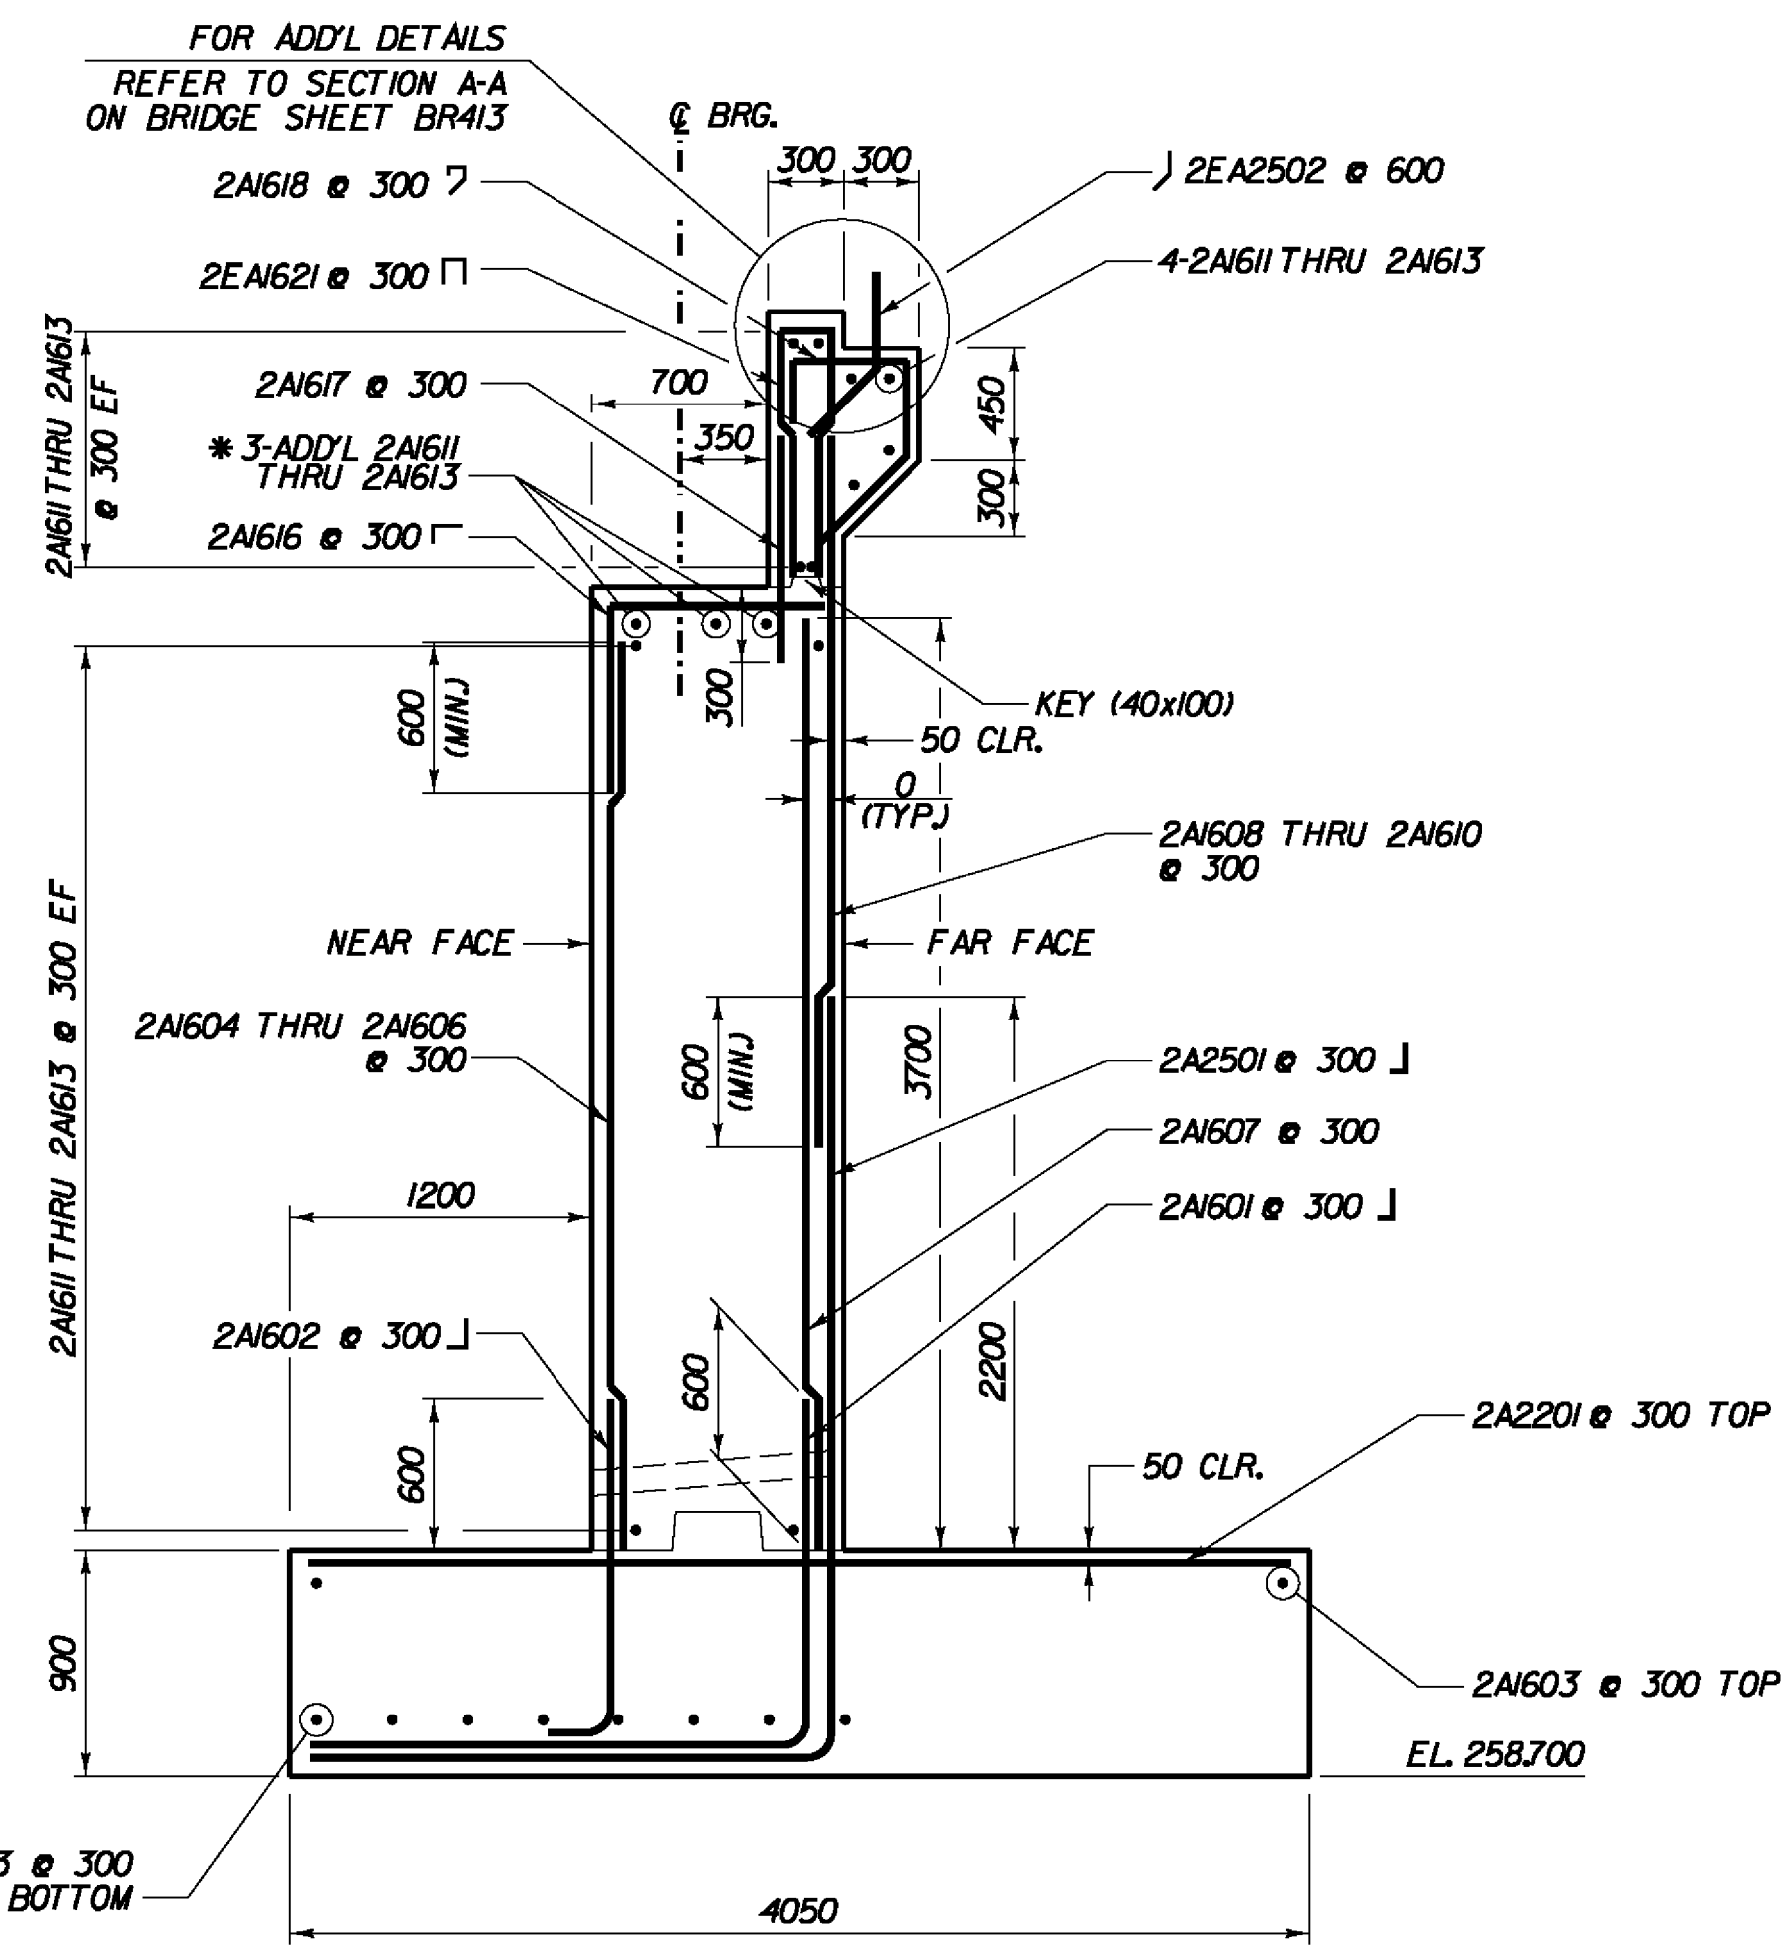

ABUTMENT 2 TYPICAL SECTION
SCALE 1:30

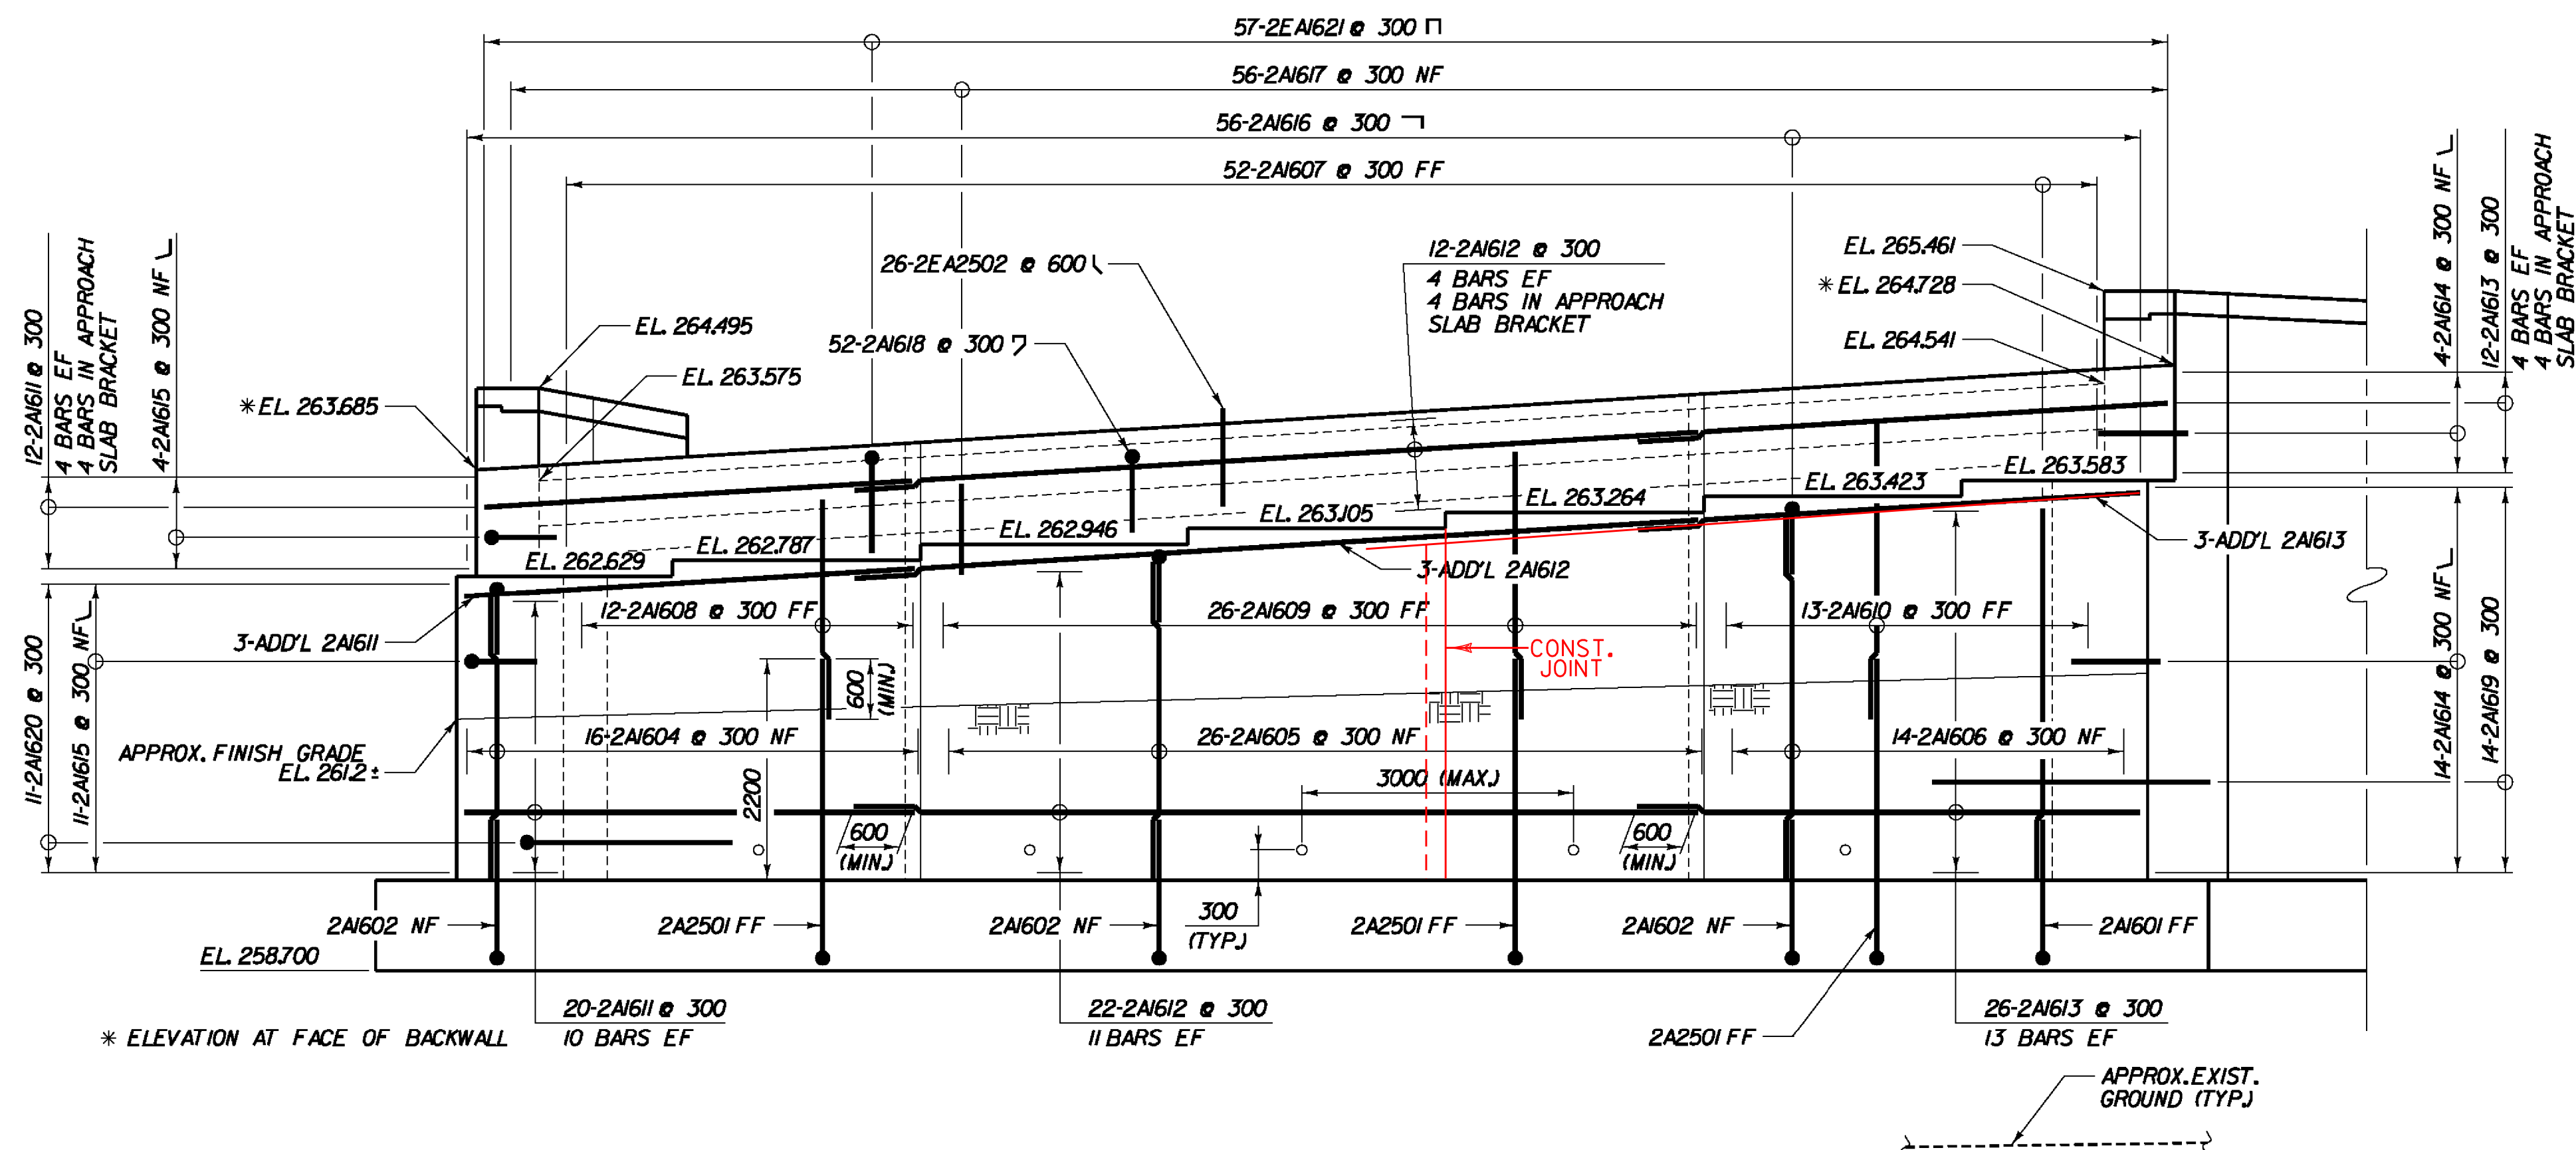

ABUTMENT 2 ELEVATION
SCALE 1:50

NOTE:

- NF - NEAR FACE
- FF - FAR FACE
- EF - EACH FACE
- ▲ - CUT TO FIT IN FIELD
- 75 CLR. UNLESS OTHERWISE SPECIFIED ON THE PLANS.

STATE OF VERMONT AGENCY OF TRANSPORTATION

| | | | |
|-------------|------------|------------|--|
| Town Of | BENNINGTON | Bridge No. | |
| Highway No. | | Log Sta. | |
| | | Surv. Sta. | |

VT ROUTE 279 OVER CHAPEL ROAD

ABUTMENT 2 DETAILS

| | | | |
|-------------|-----------|--------------------------|----------|
| Designed By | T. KNIGHT | Drawn By | J. SOTER |
| Checked By | G. BOGUE | Date | 05/06 |
| | | Bridge Design Supervisor | G. BOGUE |
| | | Date | 12/05 |

| | | | |
|---------|------------|-------------|-----------------|
| PROJECT | BENNINGTON | PROJECT NO. | AC NH 019-(K52) |
|---------|------------|-------------|-----------------|

| | | | |
|------------------|---------------------------|------------|------------|
| Dgn.: | ...desig\ch\CH-Abut 2.dgn | Plot Date: | 5/18/2011 |
| Bridge Sheet No. | BR427 | Sheet | 187 of 267 |



V:\1953\active\19531002\Transportation\Structural\Design\ch\CH-Abut 2.dgn