


**NOTE:**  
**ELEVATIONS SHOWN ARE FOR THE ULTIMATE FINISHED GRADE.**  
**THE TOP 50 PAVEMENT COURSE (TYPE IIIS) WILL NOT BE**  
**CONSTRUCTED AS PART OF THIS CONTRACT. THIS CONTRACT**  
**ONLY INCLUDES 100 OF TYPE IS AND 80 OF TYPE IIS**  
**SUPERPAVE BITUMINOUS CONCRETE PAVEMENT (ITEM 490.30).**  
**PLEASE REFER TO THE ROADWAY TYPICAL SECTIONS FOR DETAILS.**



**VERMONT AGENCY OF TRANSPORTATION**

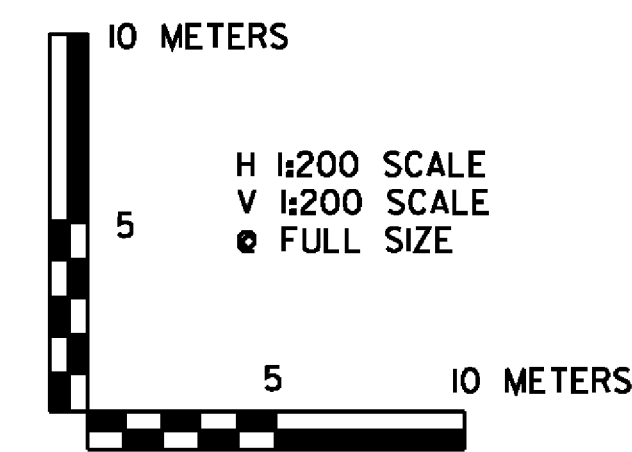

PROJECT NAME:	BENNINGTON
PROJECT NUMBER:	AC NH 019-1(52)
FILE NAME:	...plot_files\zd307c2xs_nb.prf
DESIGN SUPERVISOR:	GREG EDWARDS
DESIGNED BY:	MARC FOISY
FILE NAME:	...plot_files\zd307c2xs_nb.prf
PLOT DATE:	5/16/2010
DRAWN BY:	STANTEC
CHECKED BY:	GARY SANTY
<b>NB MAINLINE CROSS SECTIONS NBX-28</b>	
SHEET 221 OF 267	

V:\953\active\9530002\transportation\drawing\contract\2\10101\_files\zd307c2xs\_nb.prf