
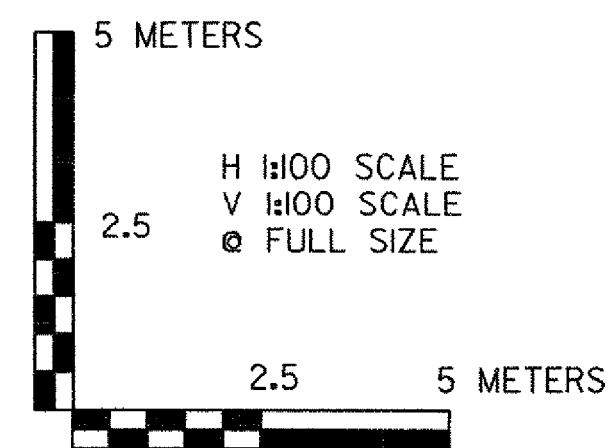
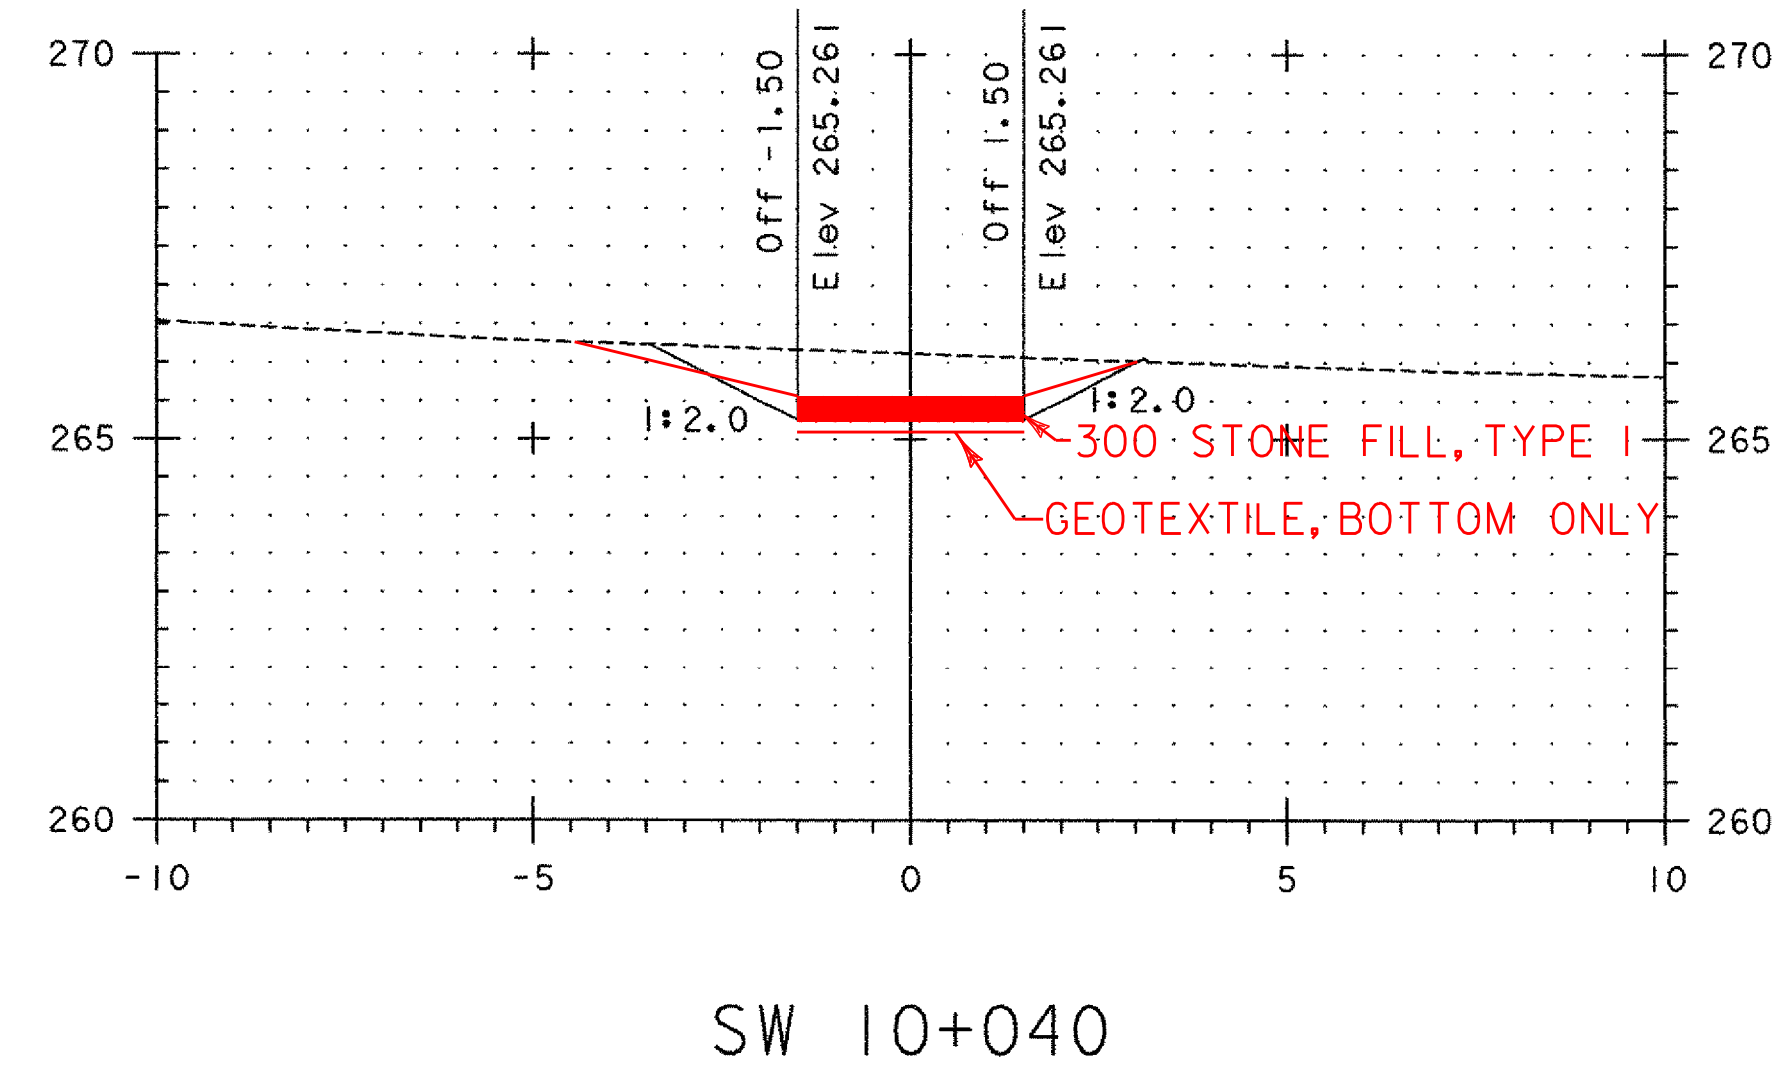
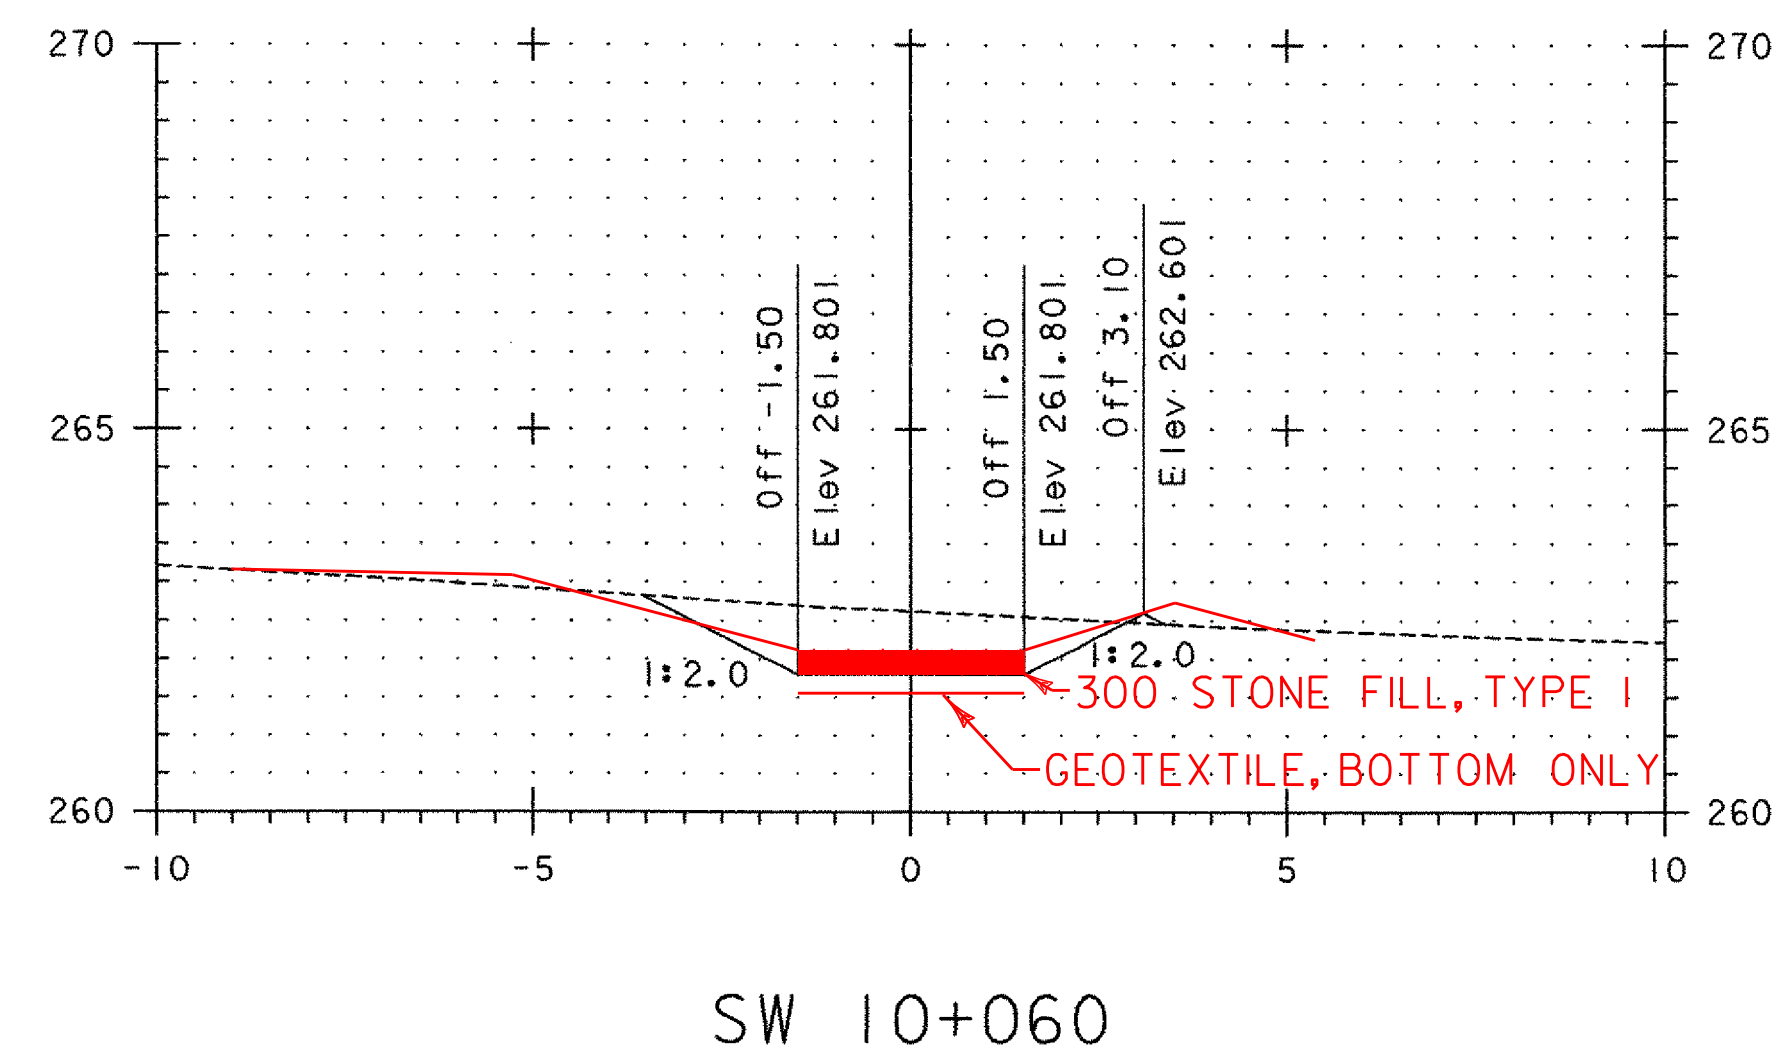


SW 1+000 TO SW 1+030  
IS NOT SWALE  
IT IS STONE OUTLET  
PROTECTION FOR CV439

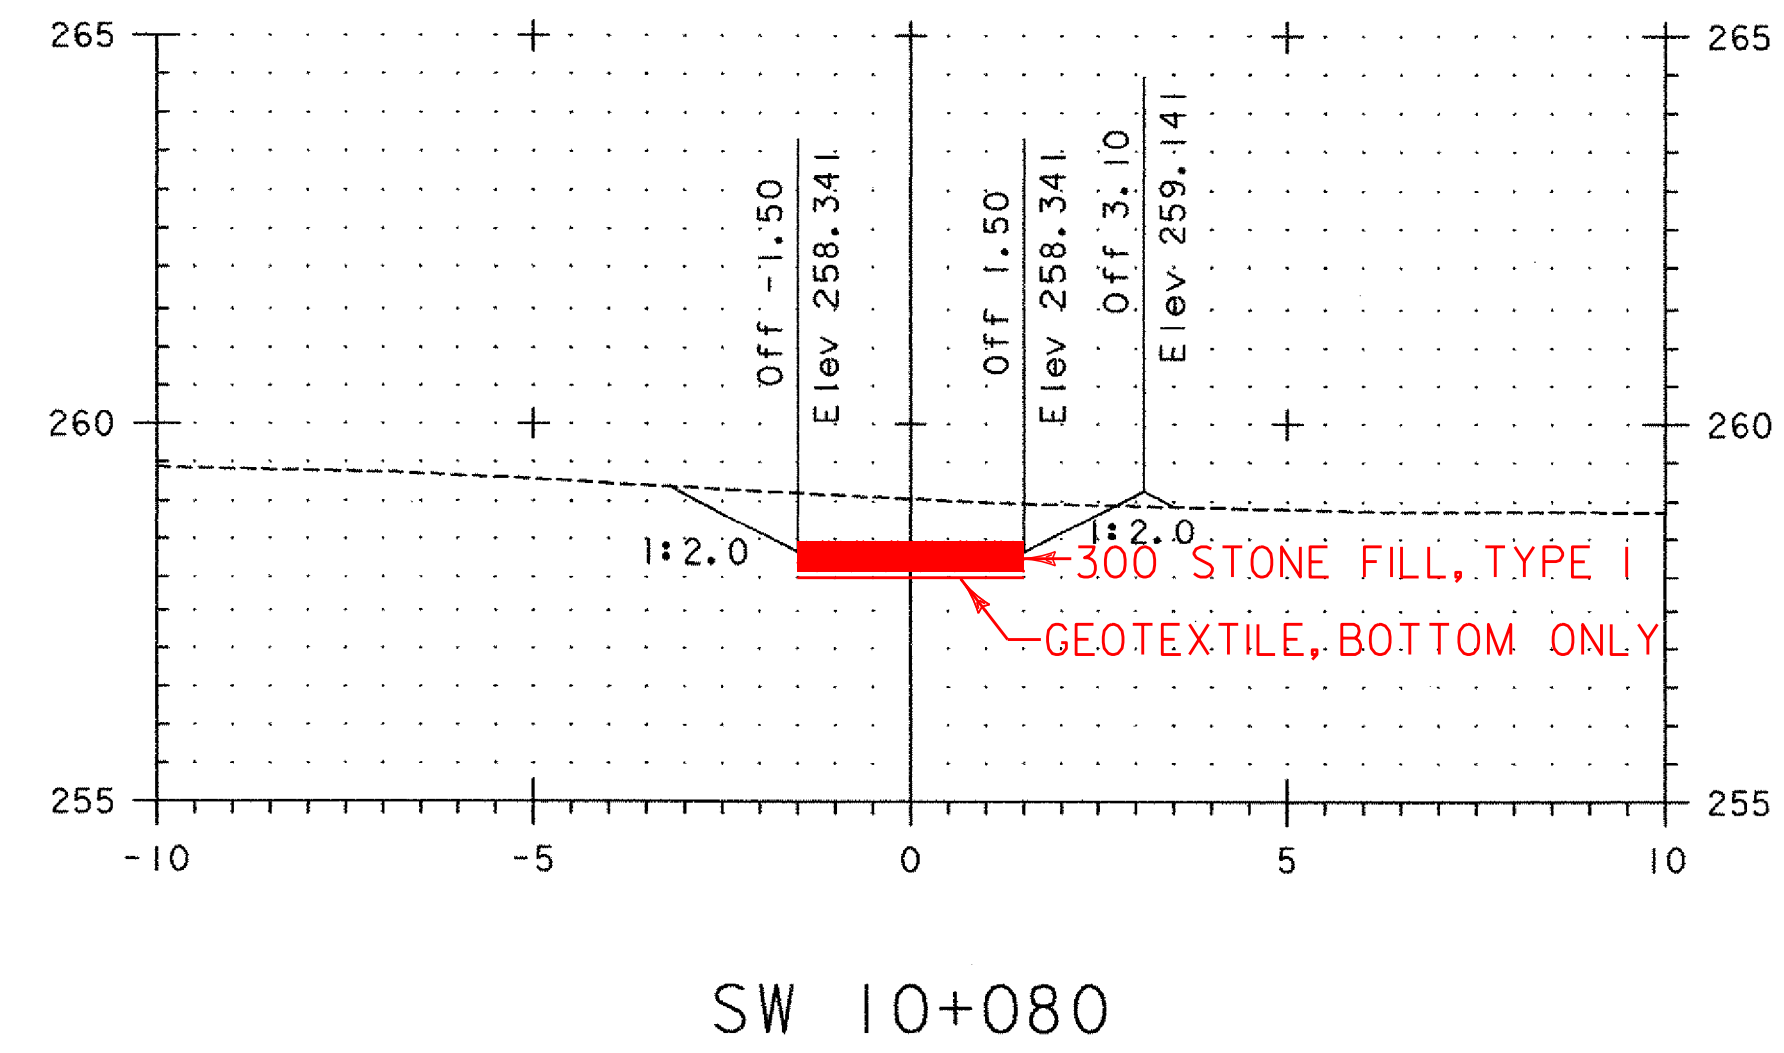

<b>VERMONT AGENCY OF TRANSPORTATION</b>	
	PROJECT NAME: BENNINGTON
	PROJECT NUMBER: AC NH 019-1(K52)
FILE NAME: ...vd307c2xs.prouty.ptf	PLOT DATE: 12/20/2007
DESIGN SUPERVISOR: GREG EDWARDS	DRAWN BY: STANTEC
DESIGNED BY: MARC FOISY	CHECKED BY: GARY SANTY
<b>PROUTY SWALE CROSS SECTIONS PSX-1</b>	SHEET 266 OF 267