

WOVEN WIRE FENCE WITH STEEL POSTS
 STA. NB 7+090.000, 59.8m LT. - STA. NB 7+125.000, 65.0m LT.
 STA. NB 7+090.000, 37.2m RT. - STA. NB 7+096.000, 40.1m RT.
 STA. NB 7+100.384, 45.4m RT. - STA. NB 7+440.000, 28.5m RT.
 STA. NB 7+130.000, 67.1m LT. - STA. NB 7+324.990, 81.0m LT.
 STA. NB 7+332.083, 80.4m LT. - STA. NB 7+440.000, 75.6m LT.

PROJECT DEMARCATION FENCE
 STA. NB 7+090.000, 37.4m LT. - STA. NB 7+127.655, 54.9m LT.
 STA. NB 7+090.000, 35.5m RT. - STA. NB 7+162.772, 44.6m RT.
 STA. NB 7+123.030, 65.7m LT. - STA. NB 7+312.430, 98.6m LT.
 STA. NB 7+162.012, 43.1m RT. - STA. NB 7+193.912, 24.9m RT.
 STA. NB 7+237.158, 17.3m RT. - STA. NB 7+290.466, 18.8m RT.
 STA. NB 7+331.800, 107.6m LT. - STA. NB 7+440.000, 65.4m LT.
 STA. NB 7+335.177, 18.3m RT. - STA. NB 7+440.000, 27.0m RT.

BARRIER FENCE
 STA. NB 7+170.342, 62.5m RT. - STA. NB 7+218.980, 71.6m RT.
 STA. NB 7+273.888, 44.9m RT. - STA. NB 7+349.317, 58.1m RT.

7+18 BITUMINOUS CONCRETE CURB, TYPE A
 STA. NB 7+120.284, RT. - STA. NB 7+440.000, RT.
 STA. NB 7+399.000, LT. - STA. NB 7+440.000, LT.






STEEL BEAM GUARDRAIL, GALVANIZED
 STA. NB 7+090.000, 8.7m LT. - STA. NB 7+309.981, 8.7m LT.
 STA. NB 7+090.000, 8.7m RT. - STA. NB 7+440.000, 8.7m RT.
 STA. NB 7+398.951, 8.7m LT. - STA. NB 7+440.000, 8.7m LT.

MANUFACTURED TERMINAL SECTION, FLARED
 STA. NB 7+309.981, 8.7m LT.
 STA. NB 7+398.951, 8.7m LT.

STONE FILL, TYPE II
 STA. NB 7+140.000, RT. - STA. NB 7+360.000, RT. (FOR SLOPE STABILIZATION)

GRUBBING MATERIAL
 STA. NB 7+140.000, RT. - STA. NB 7+360.000, RT. (FOR SLOPE STABILIZATION)

CHAIN-LINK FENCE, 1.8m
 STA. NB 7+096.467, 42.0m RT. - STA. NB 7+158.023, 13.6m RT.
 STA. NB 7+100.138, 45.4m RT. - STA. NB 7+161.972, 13.6m RT.
 STA. NB 7+125.785, 66.4m LT. - STA. NB 7+158.139, 28.6m LT.
 STA. NB 7+129.495, 67.2m LT. - STA. NB 7+161.868, 28.6m LT.

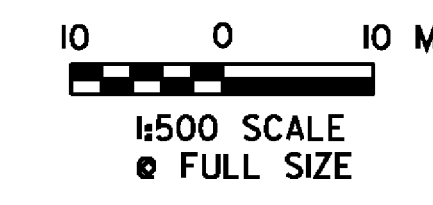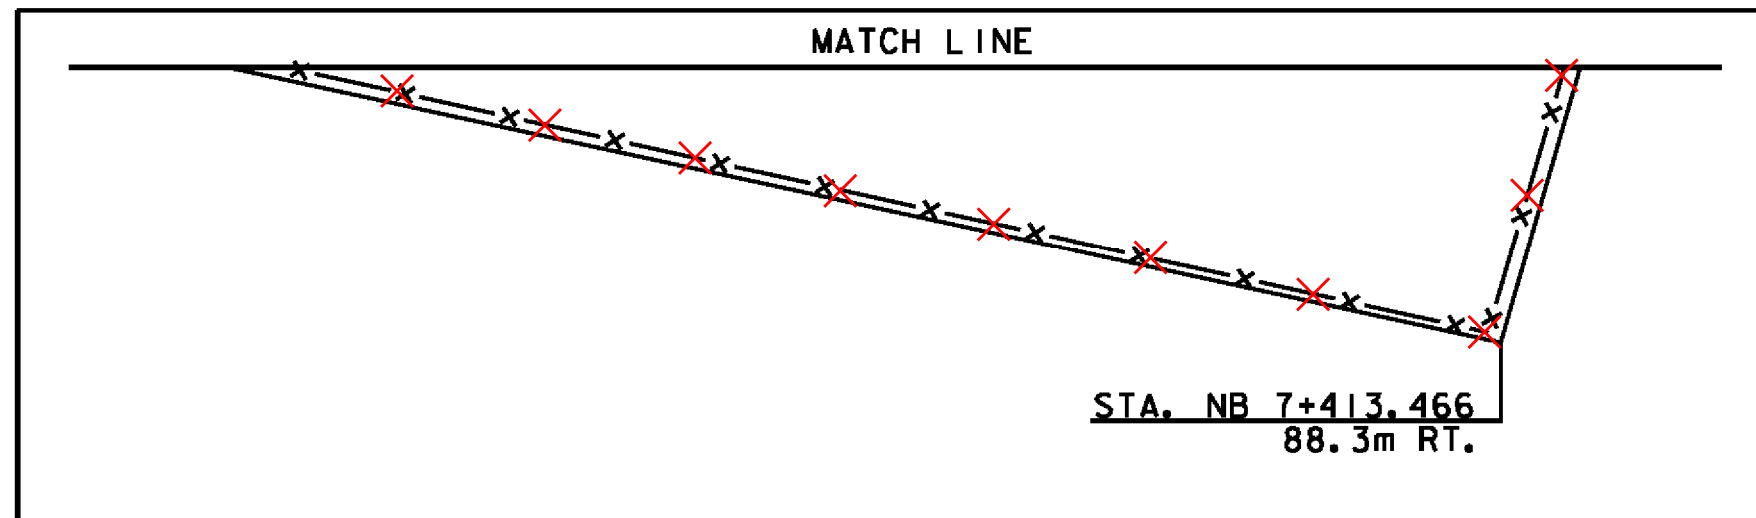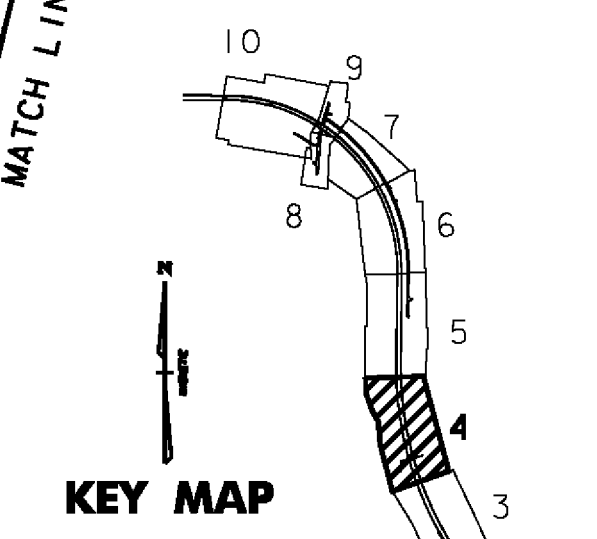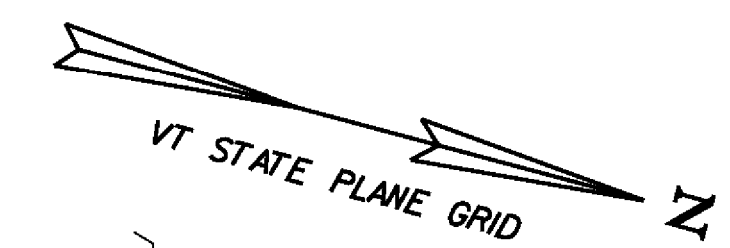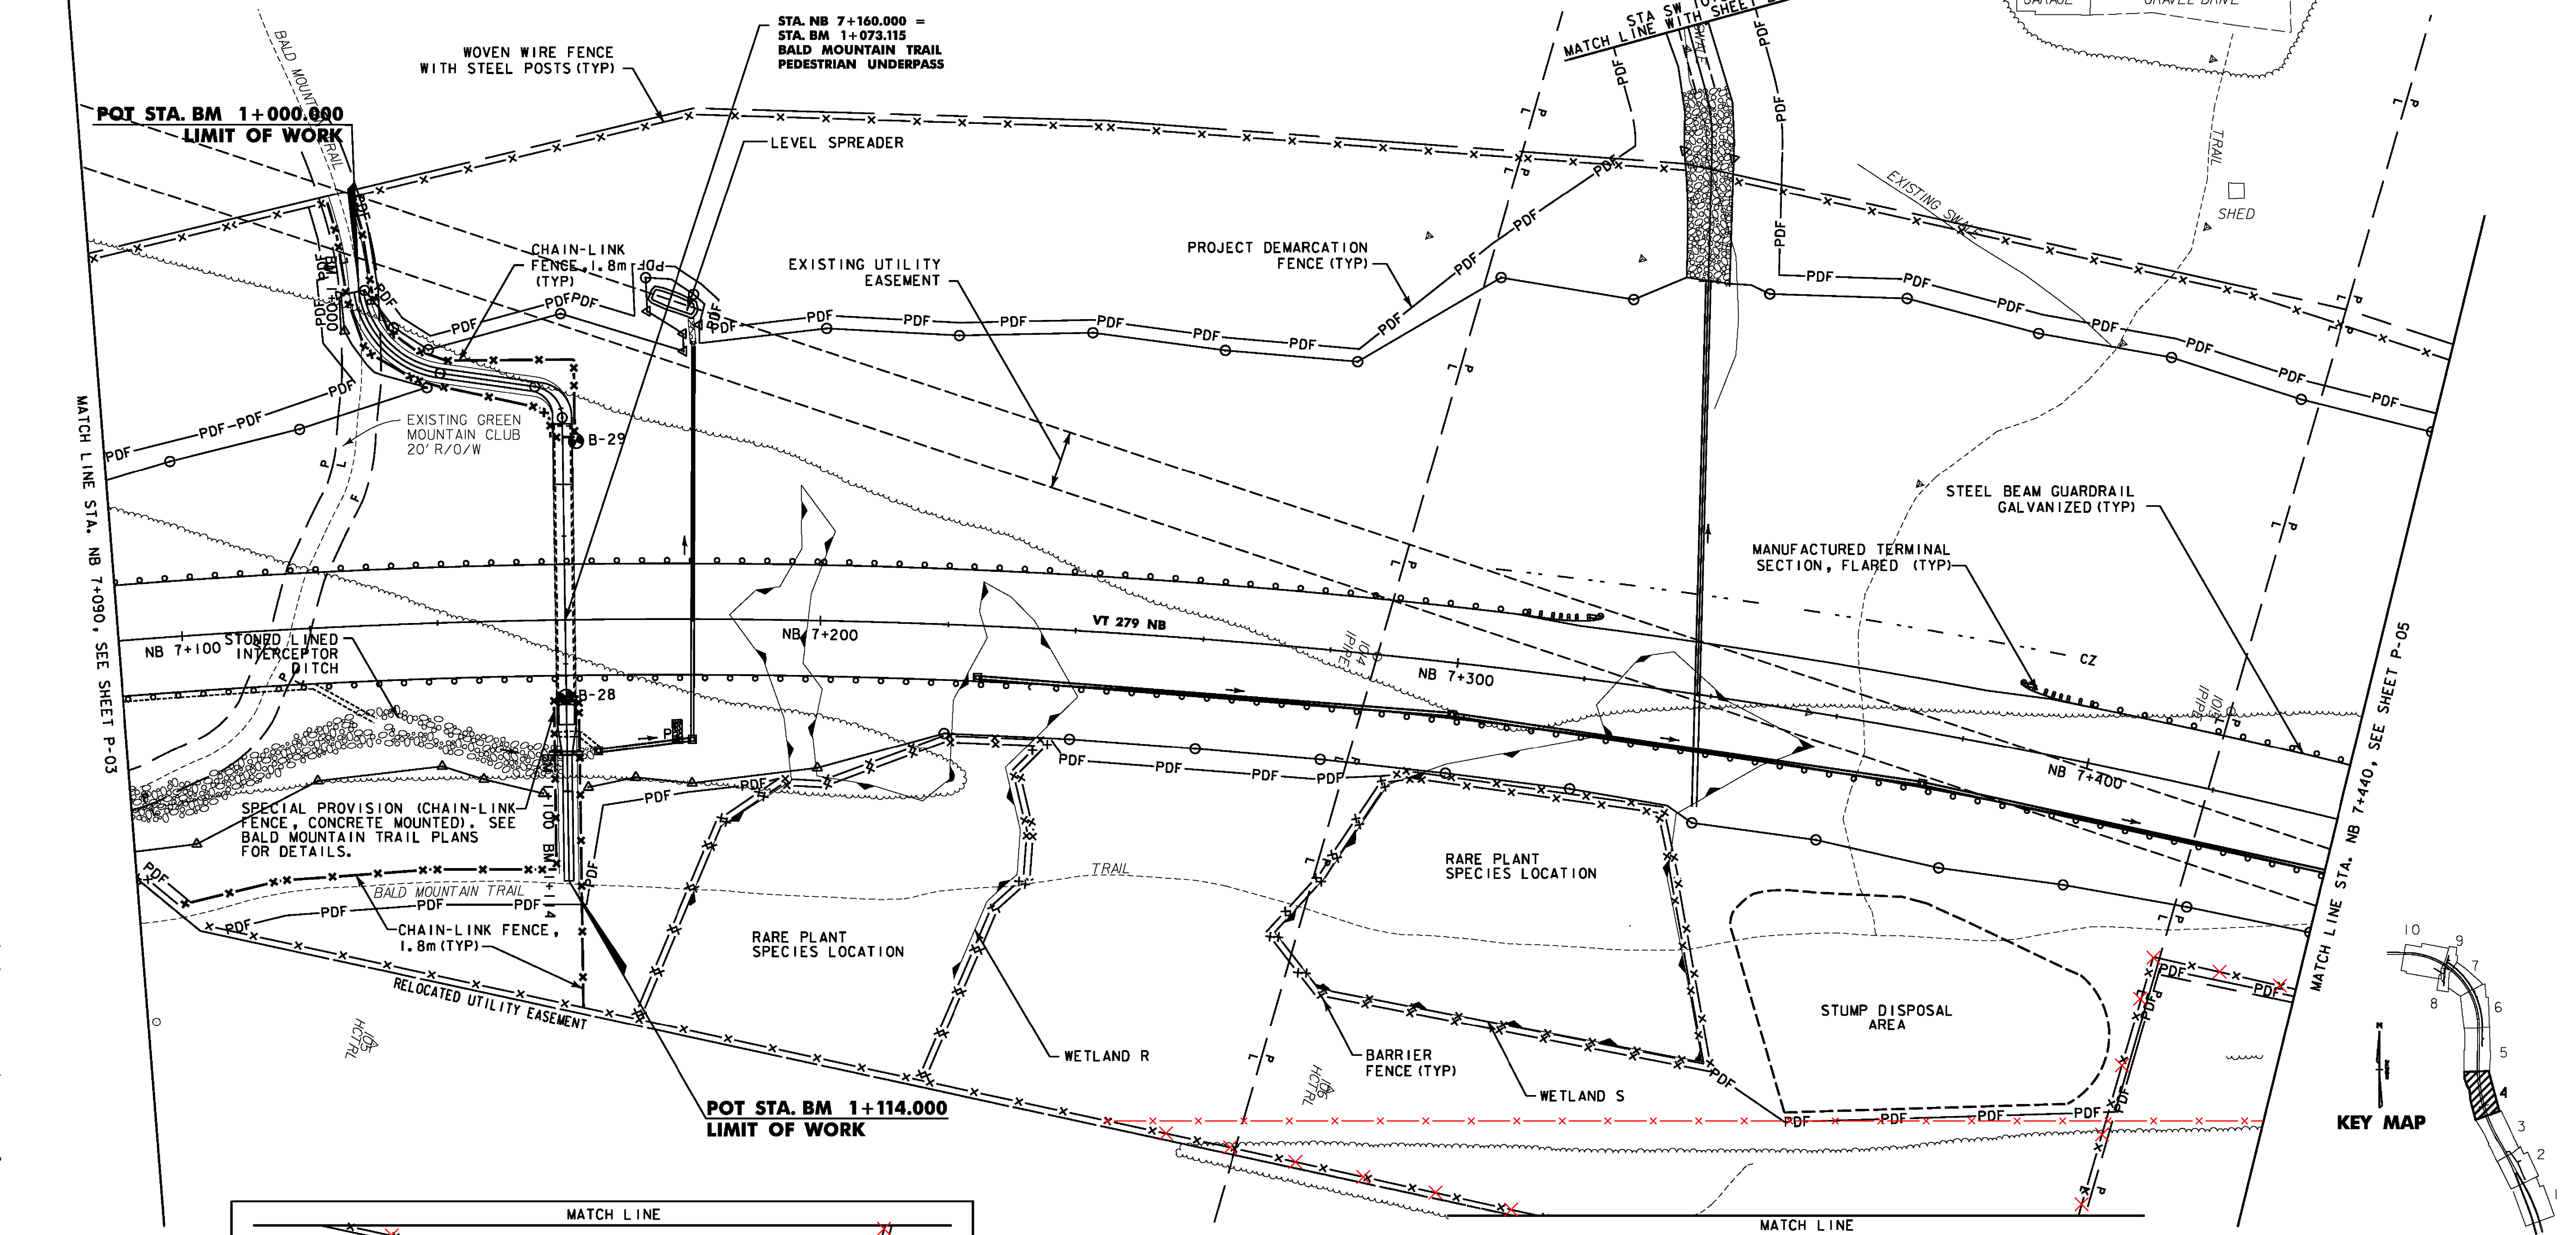

VERMONT AGENCY OF TRANSPORTATION



PROJECT NAME: BENNINGTON
 PROJECT NUMBER: AC NH 019-1(52)
 FILE NAME: ...plot_files\zd307c2p04.pff
 DESIGN SUPERVISOR: GREG EDWARDS
 DESIGNED BY: MARC FOISY
 GENERAL PLAN P-04

PLOT DATE: 5/16/2011
 DRAWN BY: STANTEC
 CHECKED BY: GARY SANTY
 SHEET 74 OF 267

V:\953\active\9530002\transportation\vdrawing\conform.ctb - 2:10:11 - files\zd307c2p04.pff