



**CONSTRUCT DRIVE**  
STA. CH 1+430.563, RT. (4.4 m GRAVEL)

**BARRIER FENCE**  
STA. CH 1+420.000 - CH 1+470.000, LT.

**STEEL BEAM GUARDRAIL, GALVANIZED**  
STA. NB 8+310.000, 8.7m LT. - STA. NB 8+310.790, 8.7m LT.  
STA. NB 8+310.000, 6.6m RT. - STA. NB 8+316.790, 6.6m RT.  
STA. NB 8+377.340, 8.7m LT. - STA. NB 8+390.000, 8.7m LT.  
STA. NB 8+383.110, 6.6m RT. - STA. NB 8+390.000, 6.6m RT.

**PROJECT DEMARCATION FENCE**  
STA. QR 1+750.000, 12.9m RT. - STA. QR 1+782.687, 19.6m RT.

**SPECIAL PROVISION (REMOVE AND STOCKPILE STONE WALL)**  
STA. CH 1+435.7, RT. - STA. CH 1+459.9, RT.

**GATE FOR CHAIN-LINK FENCE, 1.8m**  
STA. QR 1+784.602, 3.6m LT. - STA. QR 1+786.567, 3.6m RT.



**BITUMINOUS CONCRETE CURB, TYPE A**  
STA. NB 8+380.736, 8.7m LT. - STA. NB 8+390.000, 8.7m LT.

**CHAIN-LINK FENCE, 1.8m**  
STA. QR 1+750.000, 7.4m LT. - STA. QR 1+786.551, 7.4m LT.  
STA. QR 1+783.551, 7.4m LT. - STA. QR 1+784.602, 3.6m LT.  
STA. QR 1+786.567, 3.6m RT. - STA. QR 1+787.498, 7.1m RT.

**SPECIAL PROVISION (DECOMMISSION OBSERVATION WELL)**  
STA. NB 8+390.000, 35.0m LT.

**STONE FILL, TYPE II**  
STA. NB 8+369.000, LT. - STA. NB 8+390.000, LT. (FOR SLOPE STABILIZATION)  
STA. NB 8+375.000, RT. - STA. NB 8+390.000, RT. (FOR SLOPE STABILIZATION)

**GRUBBING MATERIAL**  
STA. NB 8+369.000, LT. - STA. NB 8+390.000, LT. (FOR SLOPE STABILIZATION)  
STA. NB 8+375.000, RT. - STA. NB 8+390.000, RT. (FOR SLOPE STABILIZATION)

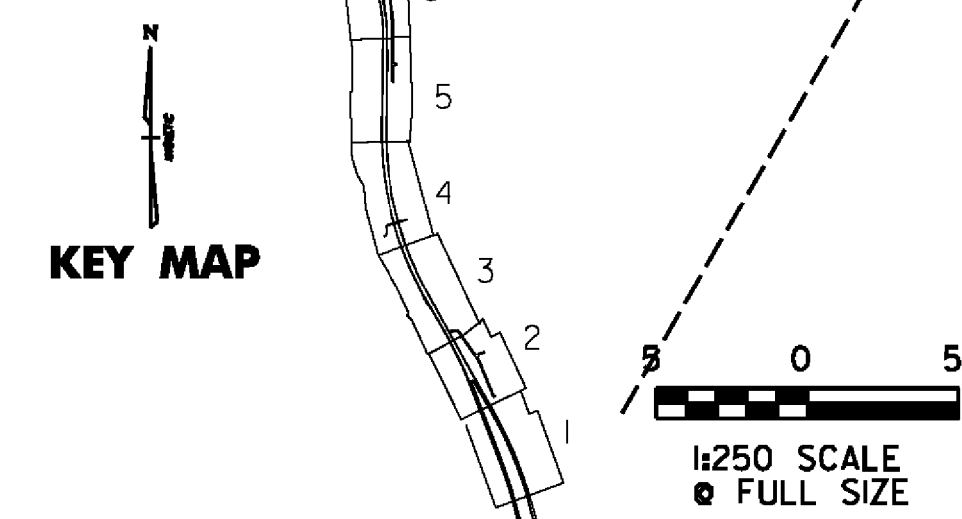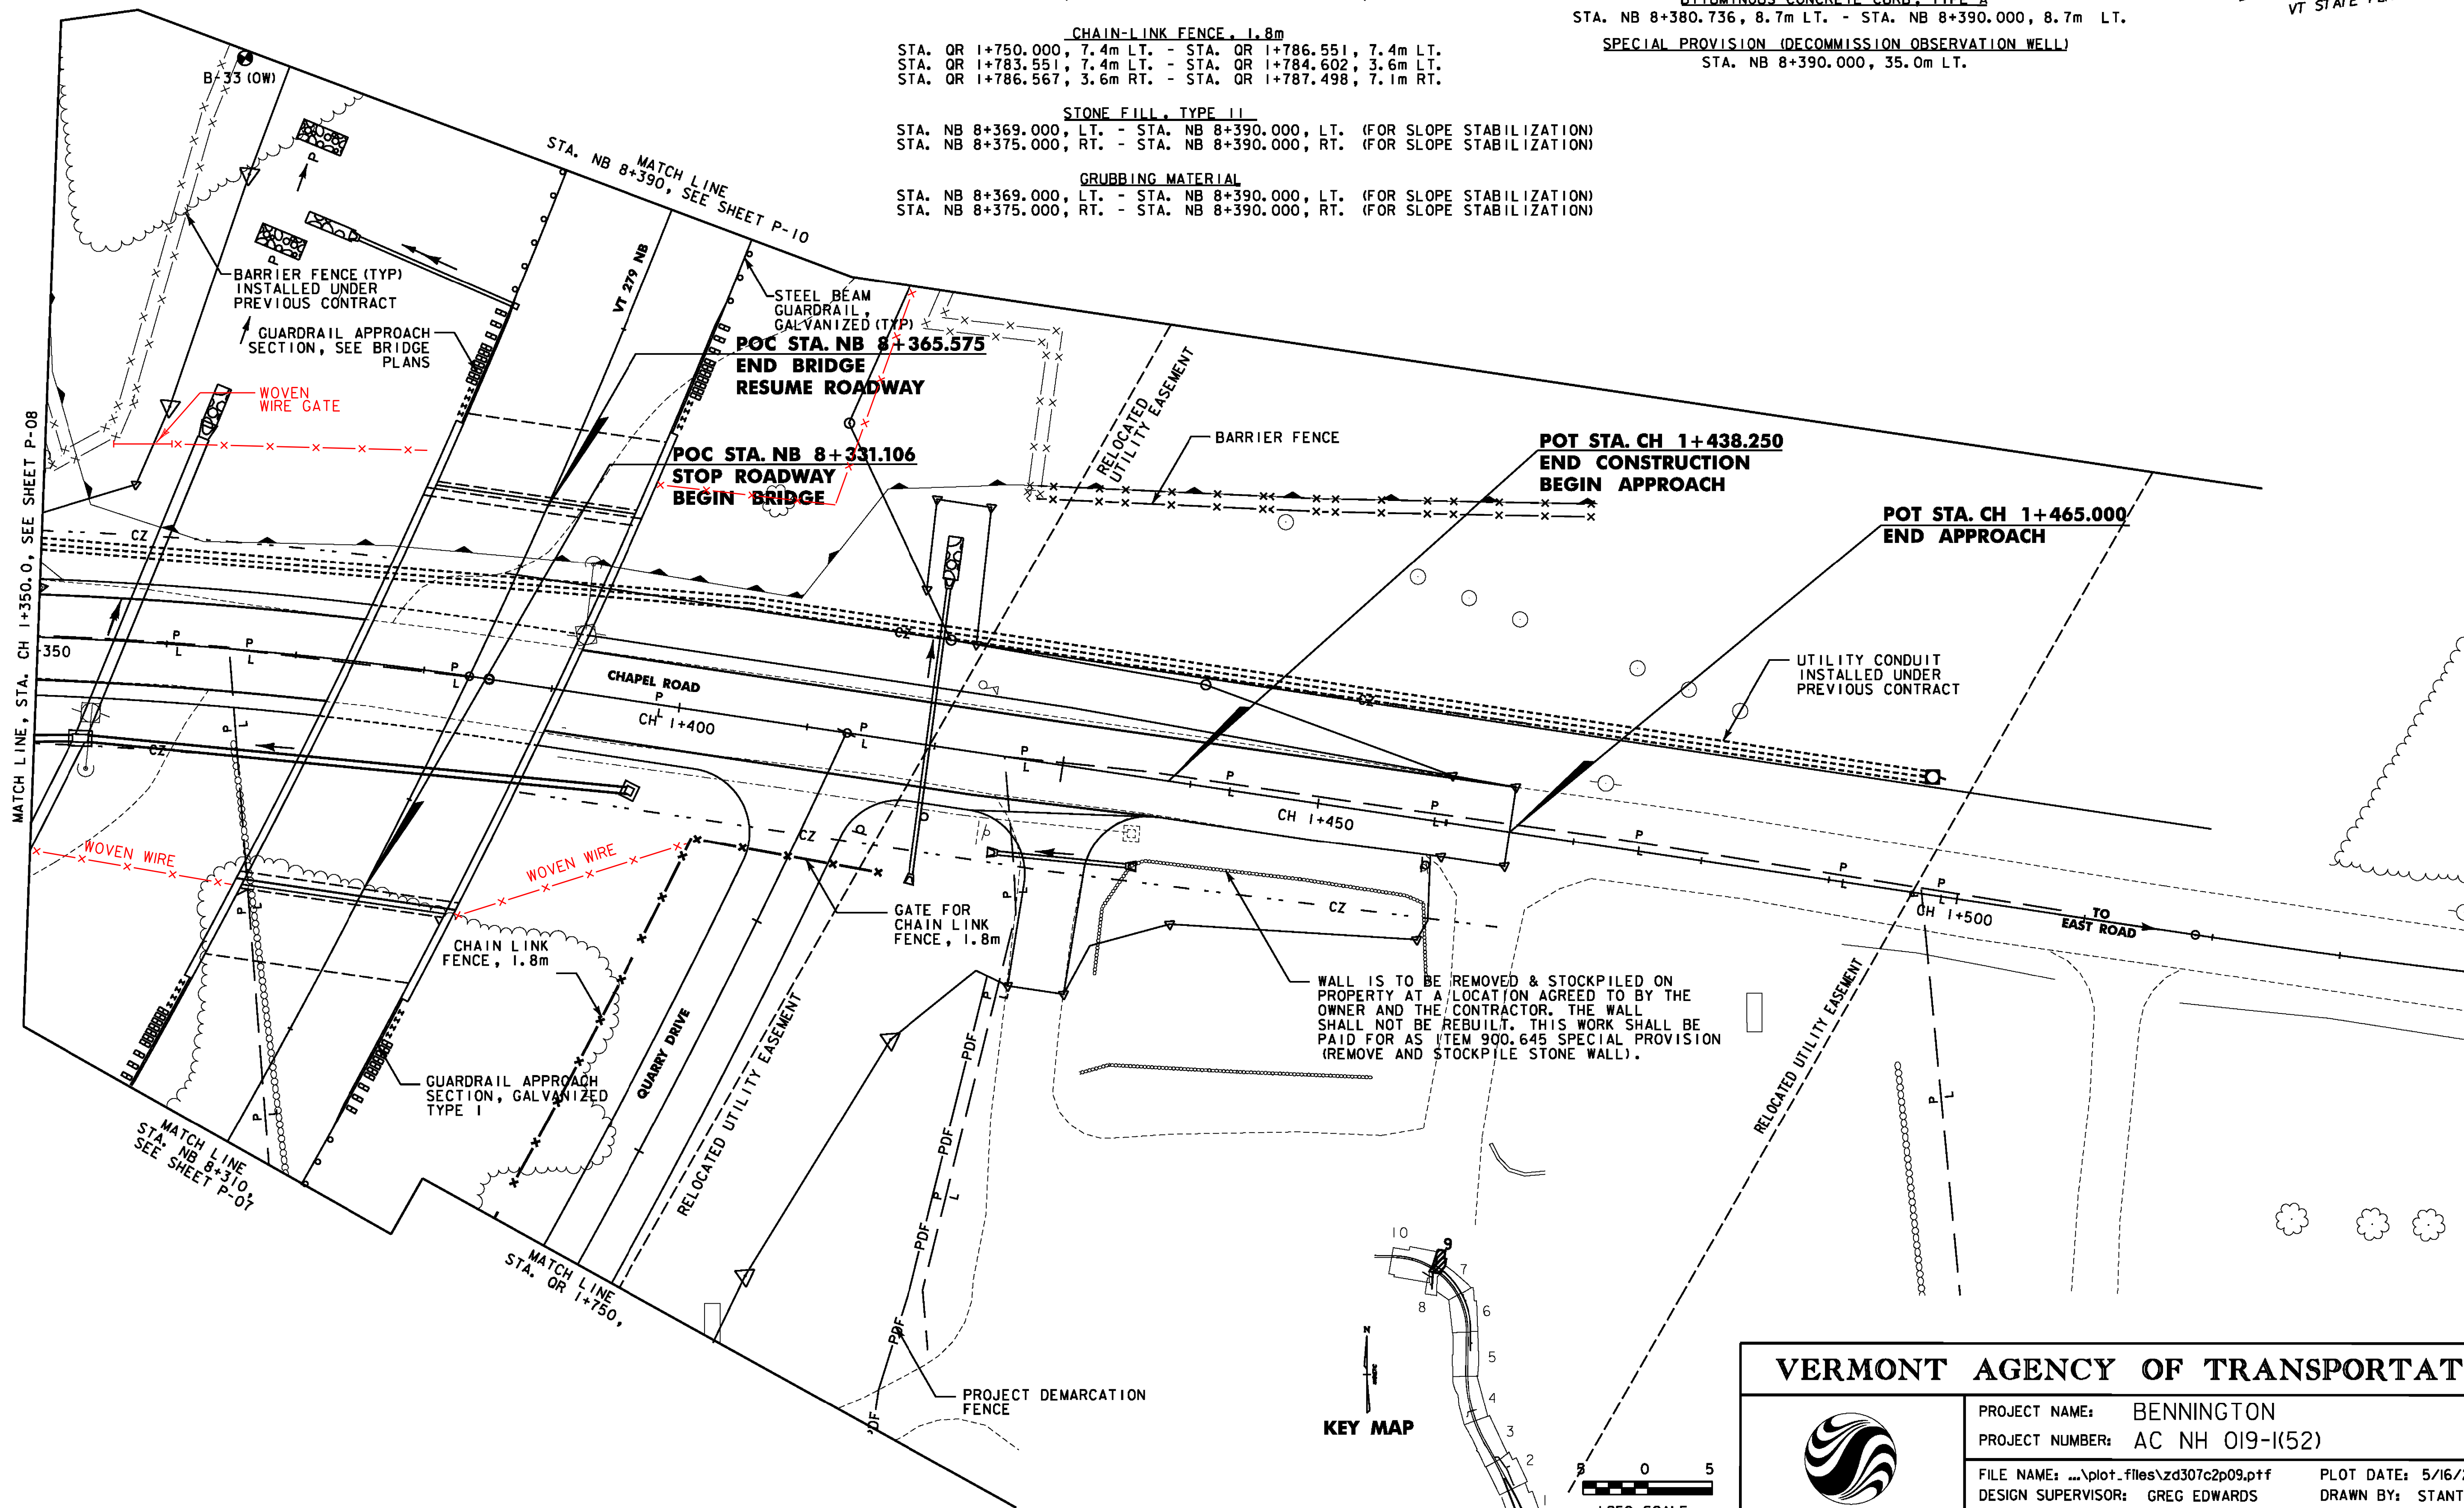

**VERMONT AGENCY OF TRANSPORTATION**



PROJECT NAME:	BENNINGTON	PLLOT DATE:	5/16/2011
PROJECT NUMBER:	AC NH 019-(K52)	DRAWN BY:	STANTEC
FILE NAME:	...plot-files\zd307c2p09.pff	CHECKED BY:	GARY SANTY
DESIGN SUPERVISOR:	GREG EDWARDS	SHEET	79 OF 267
DESIGNED BY:	MARC FOISY	GENERAL PLAN	P-09

V:\953\active\9530002\transportation\drawing\constr\cctf\_2.plot\_files\zd307c2p09.pff