


NOT INSTALLED
STORMWATER
AMENDMENT UNDER
CONTRACT '51


- STONE FILL, TYPE II**
STA. NB 8+390.000, LT. - STA. NB 8+515.000, LT. (FOR SLOPE STABILIZATION)
STA. NB 8+390.000, RT. - STA. NB 8+515.000, RT. (FOR SLOPE STABILIZATION)
- GRUBBING MATERIAL**
STA. NB 8+390.000, LT. - STA. NB 8+515.000, LT. (FOR SLOPE STABILIZATION)
STA. NB 8+390.000, RT. - STA. NB 8+515.000, RT. (FOR SLOPE STABILIZATION)
- STEEL BEAM GUARDRAIL, GALVANIZED**
STA. NB 8+390.000, 6.6m RT. - STA. NB 8+526.000, 6.6m RT.
STA. NB 8+390.000, 8.7m LT. - STA. NB 8+526.000, 8.7m LT.
- PROJECT DEMARCATION FENCE**
STA. DR 1+047.610, 10.3m LT. - STA. DR 1+169.000, 4.7m LT.
STA. DR 1+050.000, 8.0m RT. - STA. DR 1+083.000, 2.0m RT.
STA. DR 1+127.000, 4.0m RT. - STA. DR 1+169.000, 6.3m RT.
- BITUMINOUS CONCRETE CURB, TYPE A**
STA. NB 8+390.000 8.7m LT. - STA. NB 8+523.000, 8.7m LT.
- CONSTRUCT DRIVE**
STA. DR 1+050.000 - STA. DR 1+091.588
STA. DR 1+119.727 - STA. DR 1+169.347



VERMONT AGENCY OF TRANSPORTATION

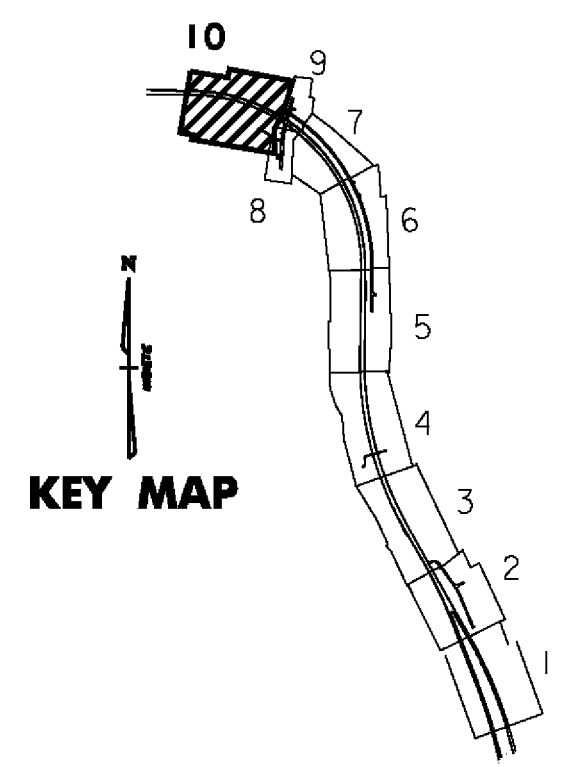

PROJECT NAME: BENNINGTON
 PROJECT NUMBER: AC NH 019-1(52)
 FILE NAME: ...\\plot.files\zd307c2p10.ptf
 DESIGN SUPERVISOR: GREG EDWARDS
 DESIGNED BY: MARC FOISY
 GENERAL PLAN P-10
 PLOT DATE: 5/16/2011
 DRAWN BY: STANTEC
 CHECKED BY: GARY SANTY
 SHEET 80 OF 267

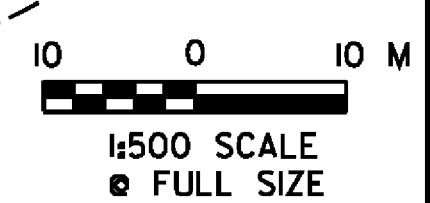

V:\953\active\9530002\transportation\dr\enr\contract\2\plot_files\zd307c2p10.prf