

MATCH LINE
STA. NB 6+740
SEE SHEET L-03



MATCH LINE
STA. NB 6+120
SEE SHEET L-03

MATCH LINE STA. NB 7+090, SEE SHEET L-05

NOTE:
THIS SHEET TO BE USED FOR
LANDSCAPING INFORMATION ONLY

LEGEND

- | | | | |
|-----------|---|--|-----------------------------------|
| AMC.01(9) | DECIDUOUS SHRUB GROUPING WITH PLANT TYPE AND (QUANTITY) | | EXISTING DECIDUOUS TREE |
| AR.01(3) | DECIDUOUS TREE GROUPING WITH PLANT TYPE AND (QUANTITY) | | EXISTING EVERGREEN TREE |
| AC.01(4) | EVERGREEN TREE GROUPING WITH PLANT TYPE AND (QUANTITY) | | TOE OF SLOPE |
| | | | LIMIT OF CUT |
| | | | APPROXIMATE ULTIMATE TOE OF SLOPE |
| | | | APPROXIMATE ULTIMATE LIMIT OF CUT |
| | | | TREELINE |
| | | | R.O.W. |

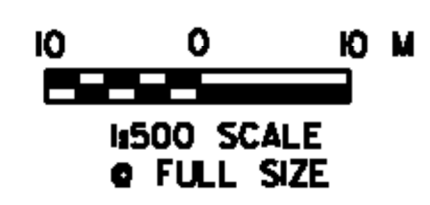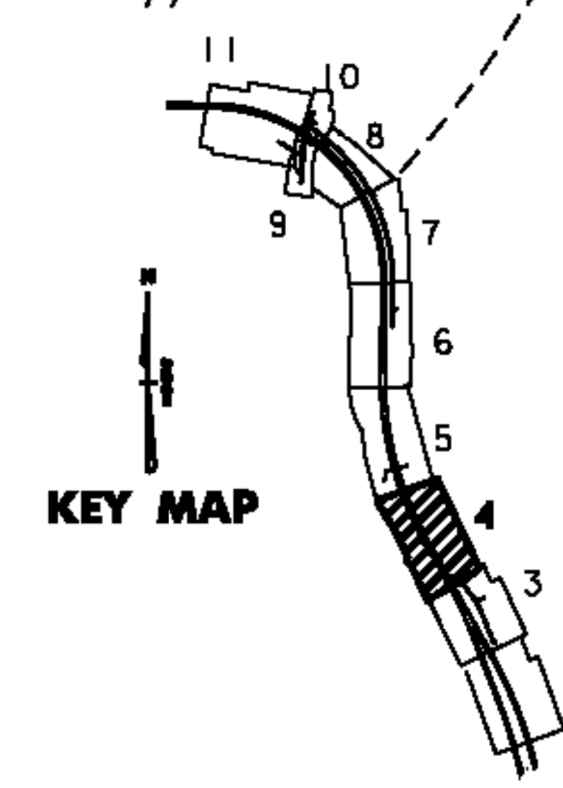

VERMONT AGENCY OF TRANSPORTATION	
DuBois & King INC.	
PROJECT NAME:	BENNINGTON - NORTH
PROJECT NUMBER:	BENNINGTON AC NH 019-(52)
FILE NAME:	\\DGN\zd307c2p03.p1f
DESIGN SUPERVISOR:	J. BENSON
DESIGNED BY:	J. STEELE/C. BRODIE
LANDSCAPE PLAN:	L-04
PLOT DATE:	12/10/2007
DRAWN BY:	E. SMALL
CHECKED BY:	J. STEELE
SHEET:	143 OF

L:\R463PC\CONTRACT NO 2\DRN\zd307c2p03.p1f