


LEGEND

AMC.01(9)	DECIDUOUS SHRUB GROUPING WITH PLANT TYPE AND (QUANTITY)		EXISTING DECIDUOUS TREE
AR.01(3)	DECIDUOUS TREE GROUPING WITH PLANT TYPE AND (QUANTITY)		TOE OF SLOPE
AC.01(4)	EVERGREEN TREE GROUPING WITH PLANT TYPE AND (QUANTITY)		LIMIT OF CUT
			APPROXIMATE ULTIMATE TOE OF SLOPE
			APPROXIMATE ULTIMATE LIMIT OF CUT
			TREELINE
			R.O.W.

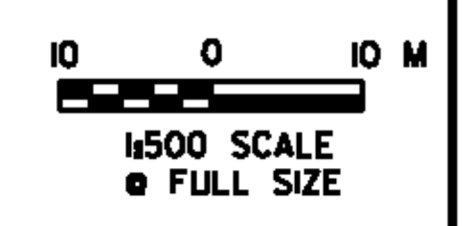

VERMONT AGENCY OF TRANSPORTATION

DuBois & King

PROJECT NAME:	BENNINGTON - NORTH	FILE NAME:	LDGN\zd307c2p04.p1f	PLOT DATE:	12/10/2007
PROJECT NUMBER:	BENNINGTON AC NH 019-(152)	DESIGN SUPERVISOR:	J. BENSON	DRAWN BY:	E. SMALL
		DESIGNED BY:	J. STEELE/C. BRODIE	CHECKED BY:	J. STEELE
		LANDSCAPE PLAN	L-05		SHEET 144 OF

1413463PC CONTRACT NO. 2308N103070204.d1f

NOTE: THIS SHEET TO BE USED FOR LANDSCAPING INFORMATION ONLY