


LEGEND

	DECIDUOUS SHRUB GROUPING WITH PLANT TYPE AND (QUANTITY)		EXISTING DECIDUOUS TREE
	DECIDUOUS TREE GROUPING WITH PLANT TYPE AND (QUANTITY)		EXISTING EVERGREEN TREE
	EVERGREEN TREE GROUPING WITH PLANT TYPE AND (QUANTITY)		TOE OF SLOPE
			LIMIT OF CUT
			APPROXIMATE ULTIMATE TOE OF SLOPE
			APPROXIMATE ULTIMATE LIMIT OF CUT
			TREELINE
			R.O.W.

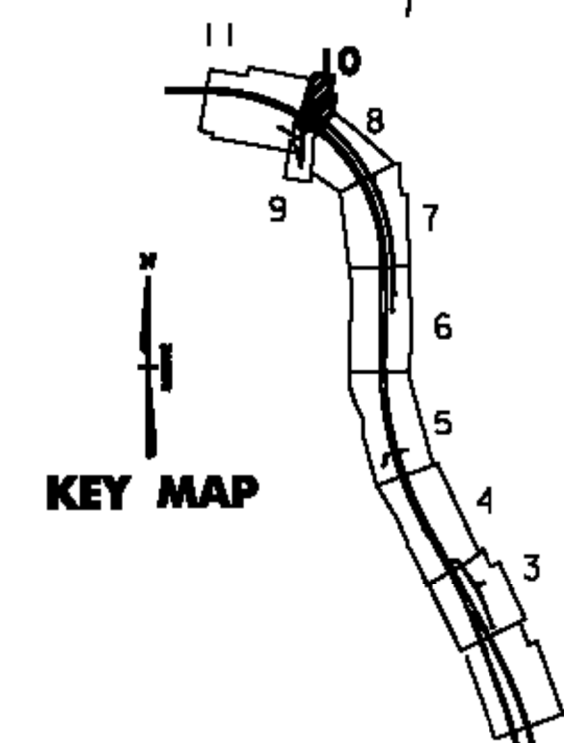

NOTE: THIS SHEET TO BE USED FOR LANDSCAPING INFORMATION ONLY

VERMONT AGENCY OF TRANSPORTATION	
PROJECT NAME: BENNINGTON - NORTH	PROJECT NUMBER: BENNINGTON AC NH 019-(152)
FILE NAME: \DGN\zd307c2p09.p1f	PLOT DATE: 12/10/2007
DESIGN SUPERVISOR: J. BENSON	DRAWN BY: E. SMALL
DESIGNED BY: J. STEELE/C. BRODIE	CHECKED BY: J. STEELE
LANDSCAPE PLAN L-10	SHEET 149 OF

1:VR463PC/CONTRACT NO. 2:VDNRVZ4307C2P09.P1F