



*SEE VAOT STANDARD A-80 FOR BOLLARD DETAILS



PLAN

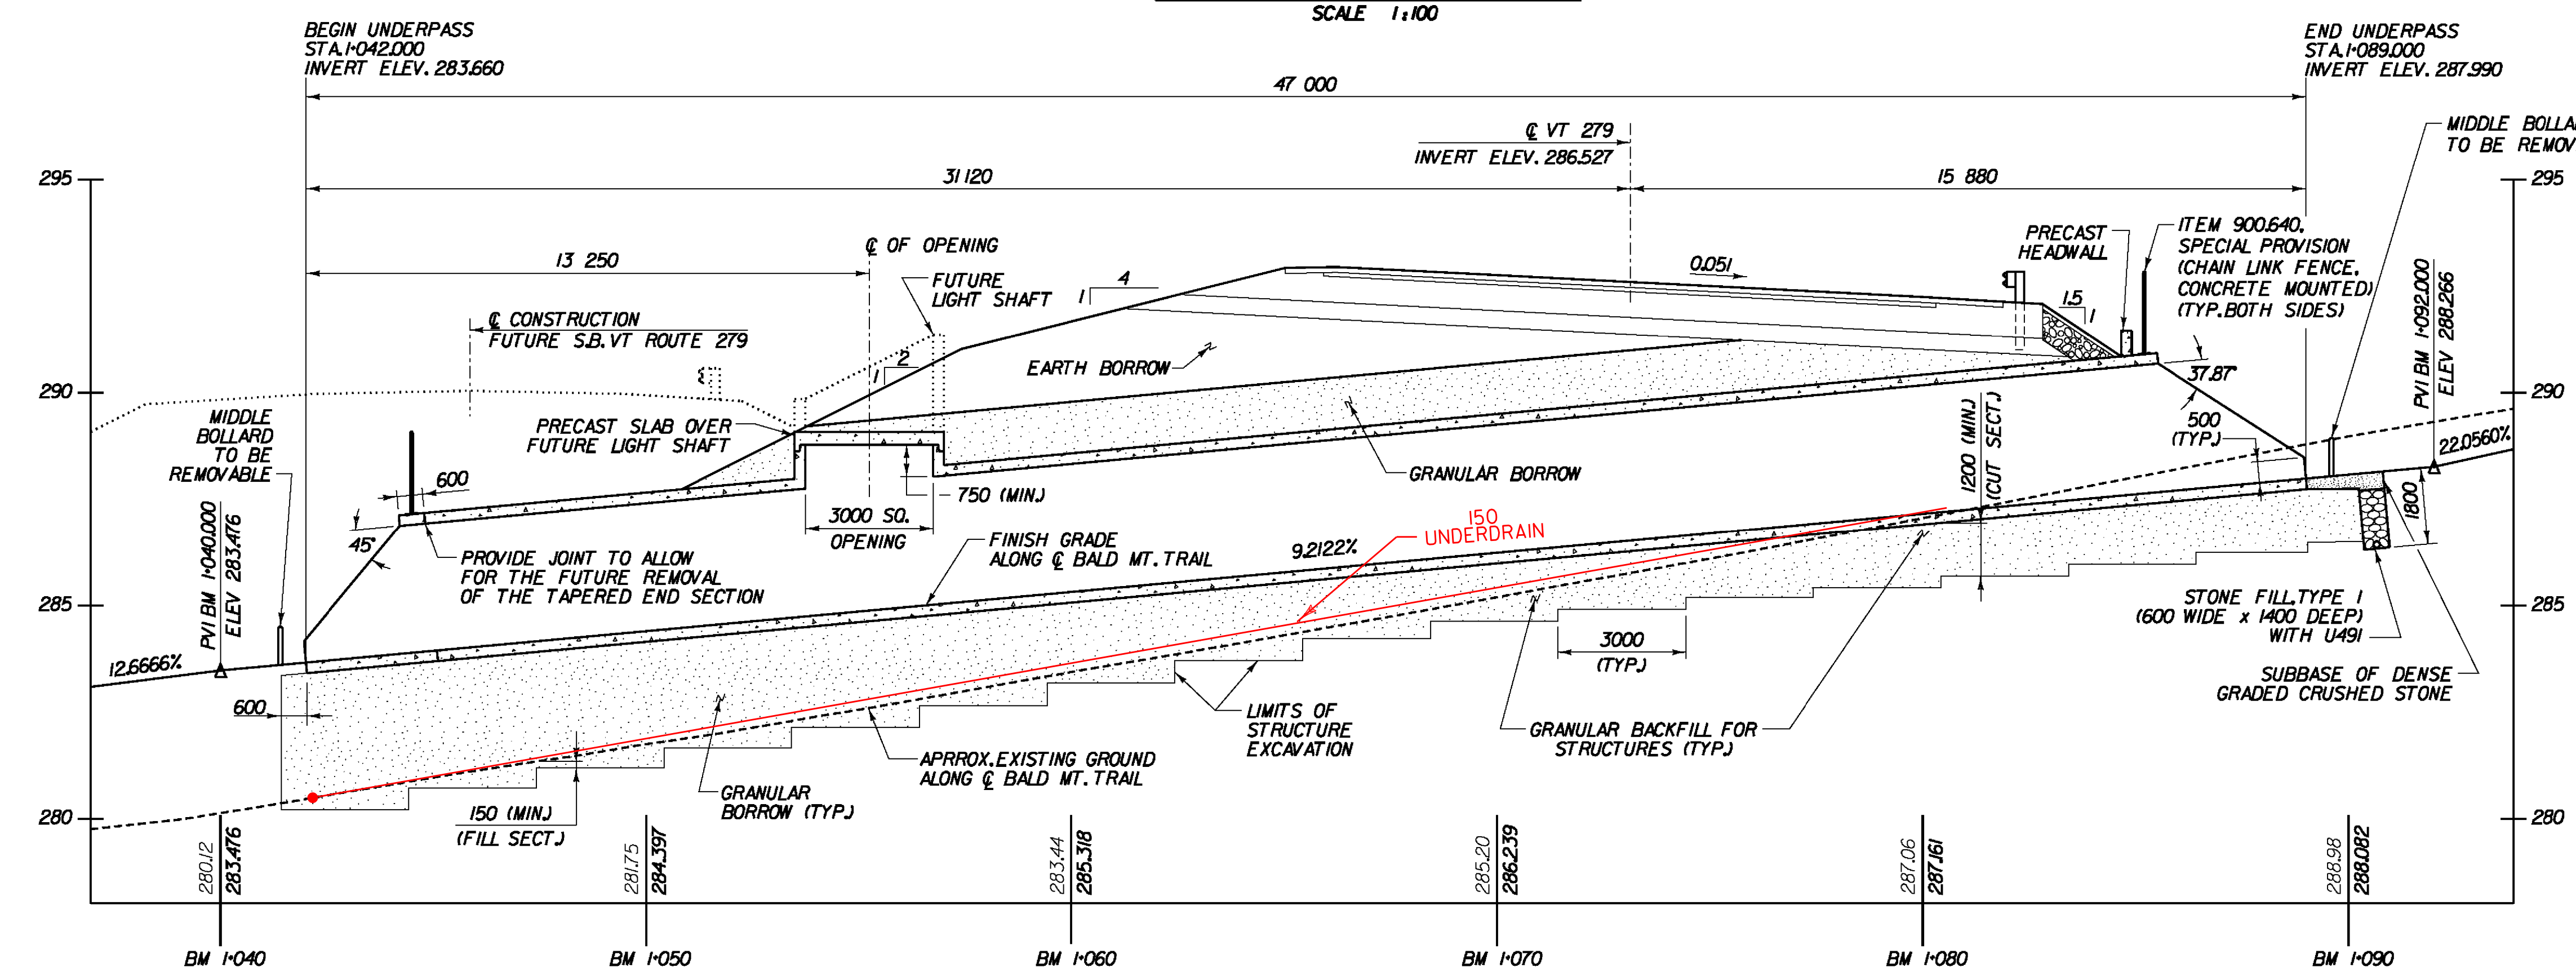

BALD MT. TRAIL PROFILE

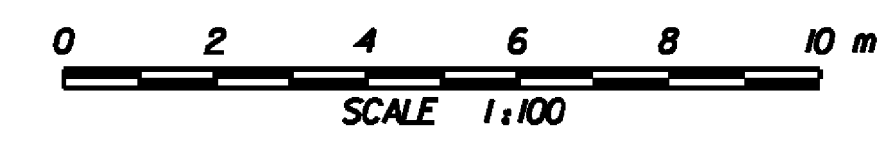

NOTE: ELEVATIONS SHOWN TO THE NEAREST HUNDREDTH ARE EXISTING GROUND. ELEVATIONS SHOWN TO THE NEAREST THOUSANDTH ARE FINISH GRADE OR ARE INVERT ELEVATION.

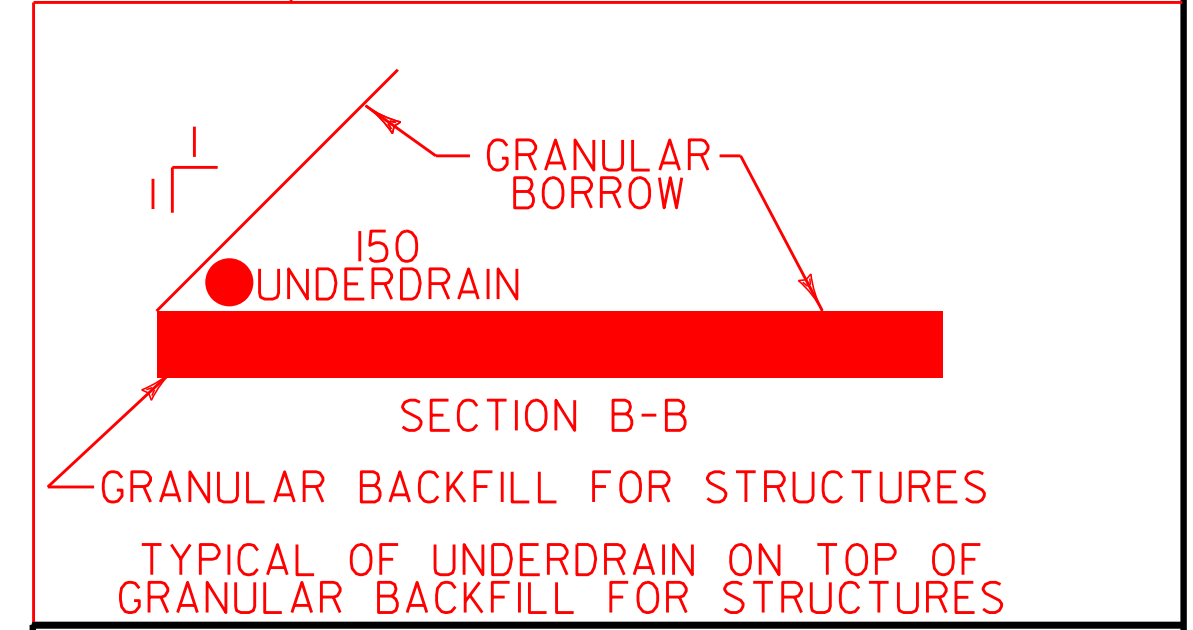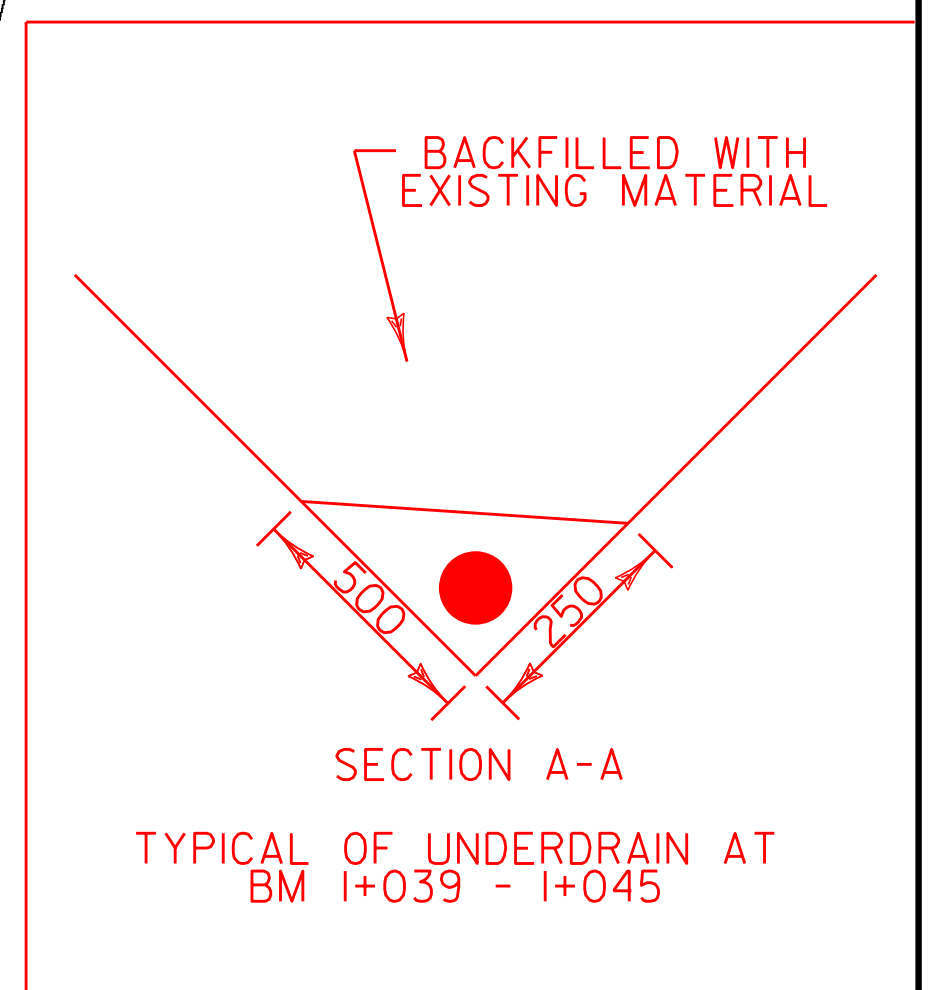

STATE OF VERMONT AGENCY OF TRANSPORTATION

Town Of	BENNINGTON	Bridge No.	
Highway No.		Log Sta.	
		Surv. Sta.	

VT ROUTE 279 OVER BALD MT. TRAIL

PLAN AND PROFILE	
Designed By	S. BURBANK
Checked By	M. CHENETTE
Date	10/05
Drawn By	S. BURBANK
Bridge Design Supervisor	G. BOGUE
Date	
PROJECT	BENNINGTON
PROJECT NO.	AC NH 019-11521
Dgn.:	... \Design\BM\BM-Plan.dgn
Plot Date:	5/18/2011
Bridge Sheet No.	BR301
Sheet	154 of 267



V:\953\acc15e\9530002\transportation\struc\design\BM-Plan.dgn