



ABUTMENT 2 PLAN
SCALE 1:50

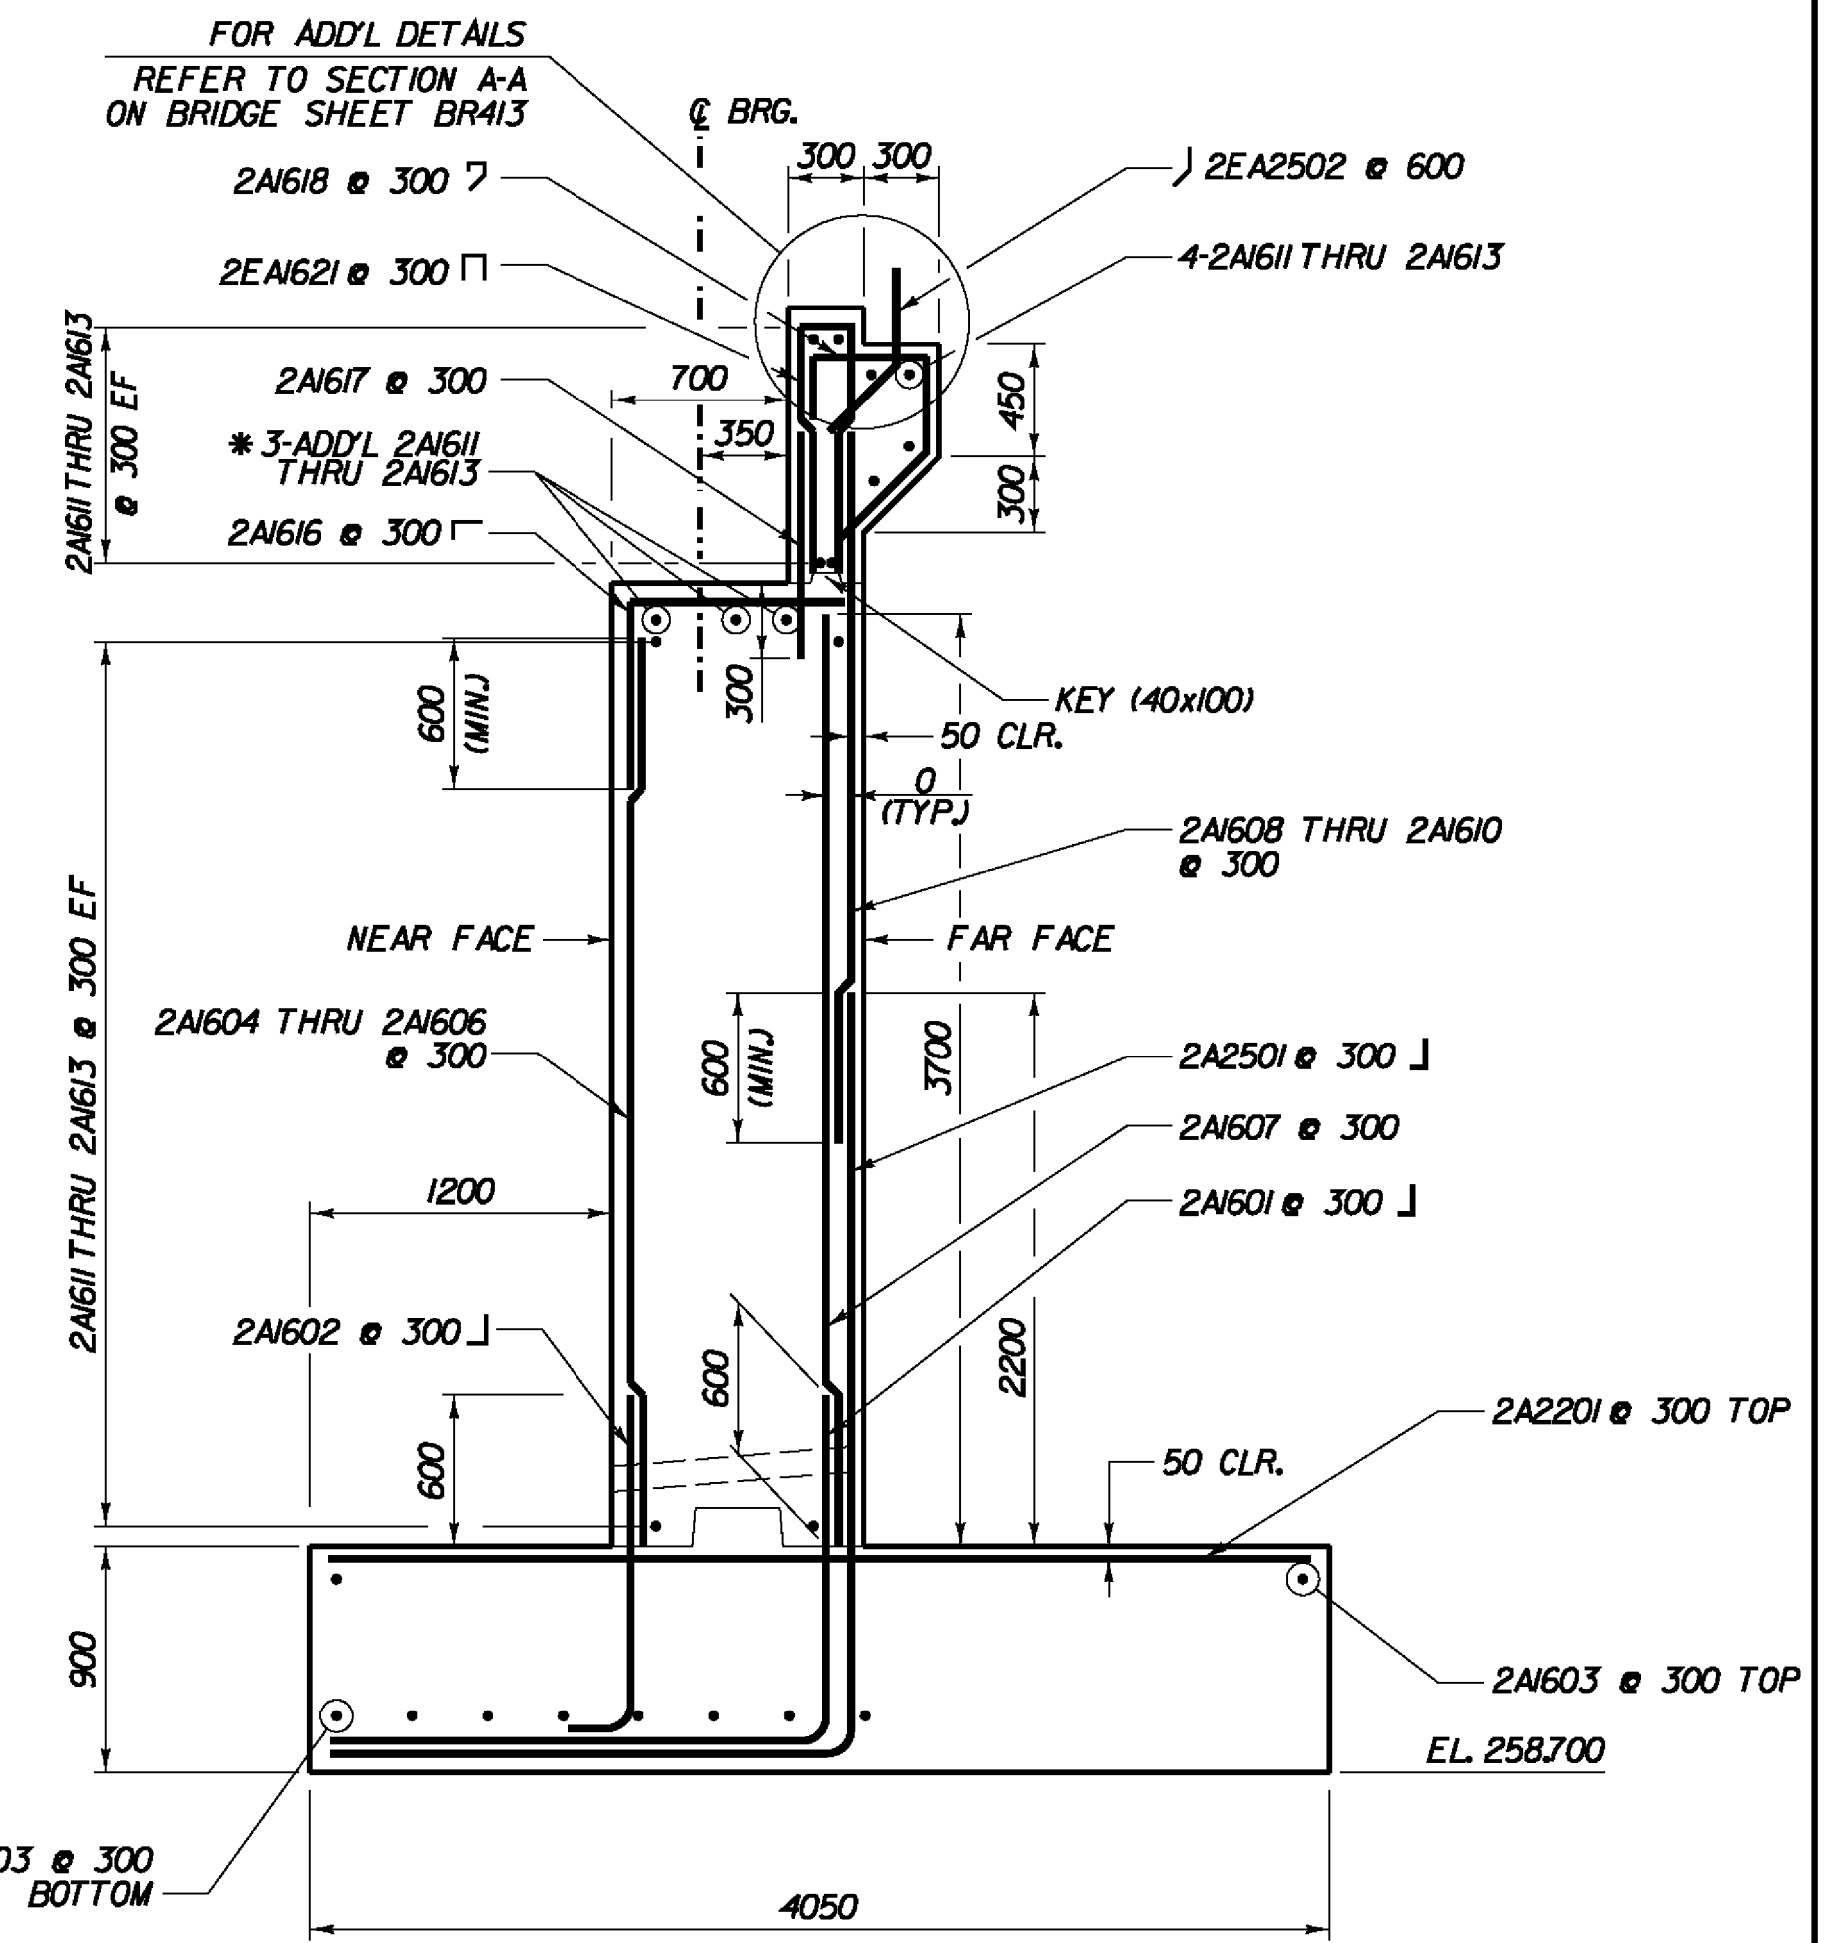

ABUTMENT 2 TYPICAL SECTION
SCALE 1:30

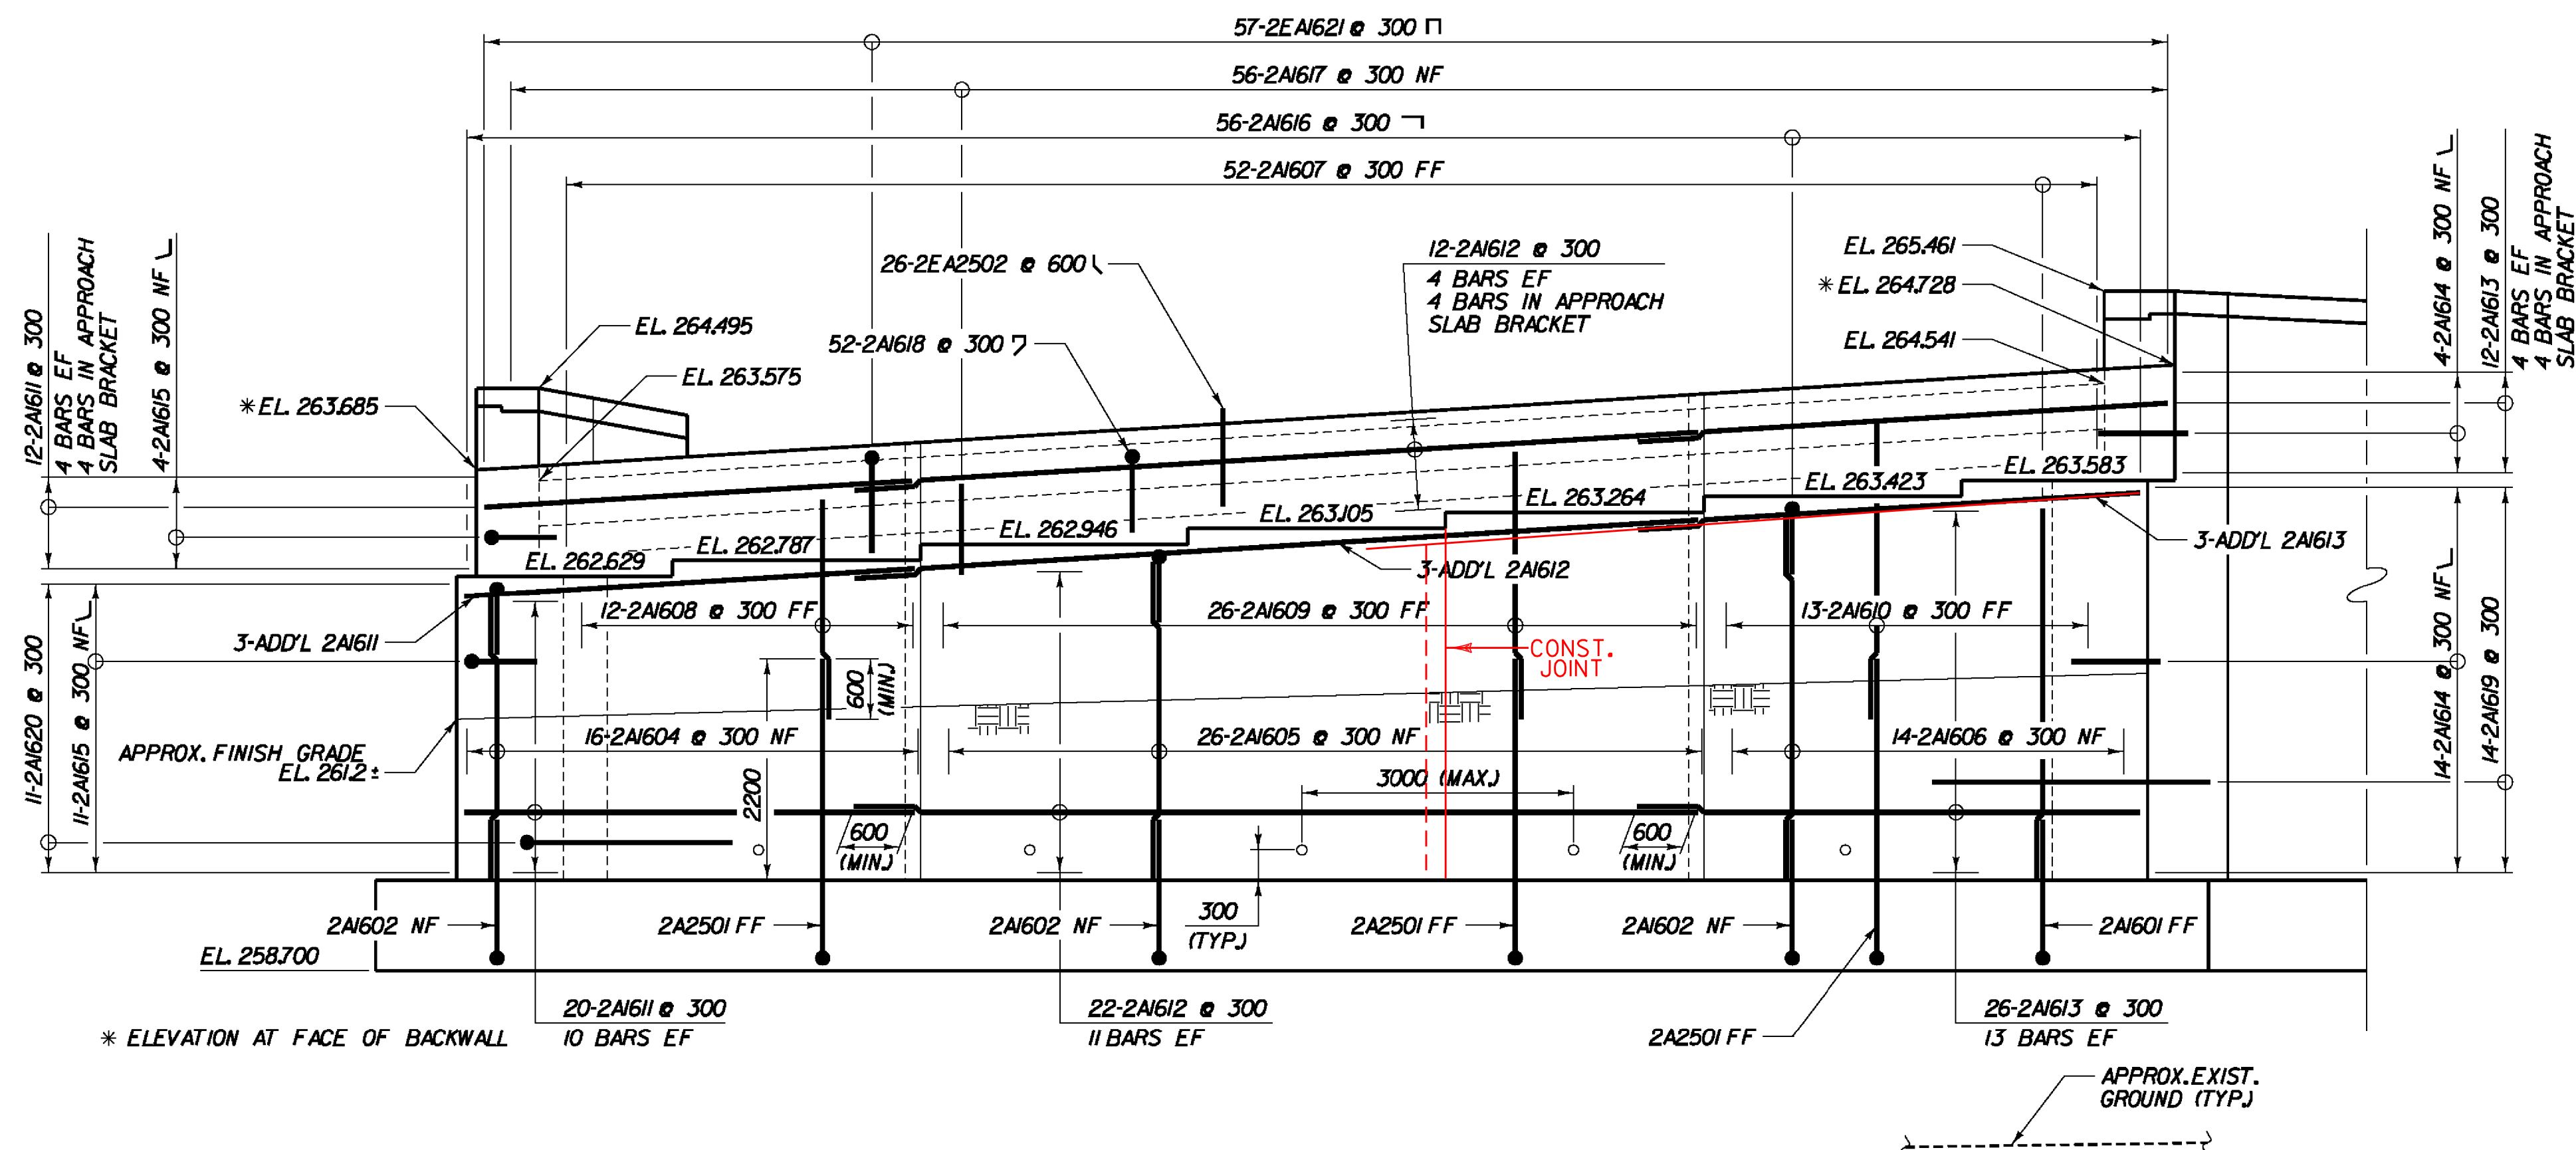

ABUTMENT 2 ELEVATION
SCALE 1:50

NOTE:

- NF - NEAR FACE
- FF - FAR FACE
- EF - EACH FACE
- ▲ - CUT TO FIT IN FIELD
- 75 CLR. UNLESS OTHERWISE SPECIFIED ON THE PLANS.

STATE OF VERMONT AGENCY OF TRANSPORTATION

Town Of	BENNINGTON	Bridge No.	
Highway No.		Log Sta.	
		Surv. Sta.	
VT ROUTE 279 OVER CHAPEL ROAD			
ABUTMENT 2 DETAILS			
Designed By	T. KNIGHT	Drawn By	J. SOTER
Checked By	G. BOGUE	Date	05/06
		Bridge Design Supervisor	G. BOGUE
		Date	12/05
PROJECT	BENNINGTON	PROJECT NO.	AC NH 019-(K52)
Dgn.:	...desig\ch\CH-Abut 2.dgn	Plot Date:	5/18/2011
Bridge Sheet No.	BR427	Sheet	187 of 267

V:\1953\active\195310002\transportation\structural\design\ch\Abut 2.dgn