


**NOTE:**  
**ELEVATIONS SHOWN ARE FOR THE ULTIMATE FINISHED GRADE.**  
**THE TOP 50 PAVEMENT COURSE (TYPE IIIS) WILL NOT BE**  
**CONSTRUCTED AS PART OF THIS CONTRACT. THIS CONTRACT**  
**ONLY INCLUDES 100 OF TYPE IS AND 80 OF TYPE IIS**  
**SUPERPAVE BITUMINOUS CONCRETE PAVEMENT (ITEM 490.30).**  
**PLEASE REFER TO THE ROADWAY TYPICAL SECTIONS FOR DETAILS.**



**VERMONT AGENCY OF TRANSPORTATION**

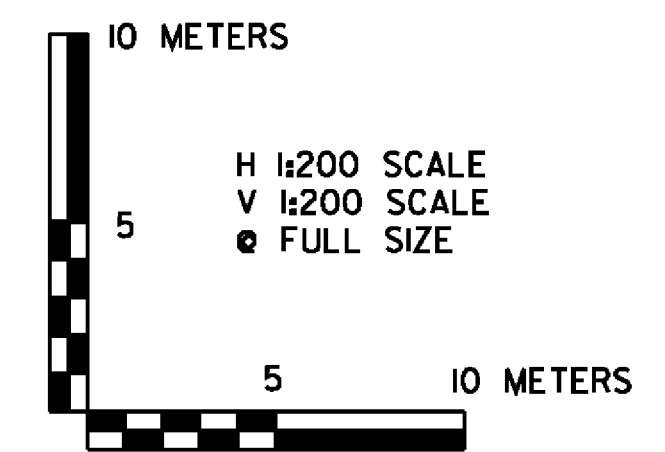

PROJECT NAME: BENNINGTON  
 PROJECT NUMBER: AC NH 019-(152)

FILE NAME: ...plot\_files\zd307c2xs\_nb.prf PLOT DATE: 5/16/2011  
 DESIGN SUPERVISOR: GREG EDWARDS DRAWN BY: STANTEC  
 DESIGNED BY: MARC FOISY CHECKED BY: GARY SANTY  
**NB MAINLINE CROSS SECTIONS NBX-25** SHEET 218 OF 267

V:\953\active\9530002\transportation\drawing\corridor\cct-2\plot\_files\zd307c2xs\_nb.prf