




SW 10+020

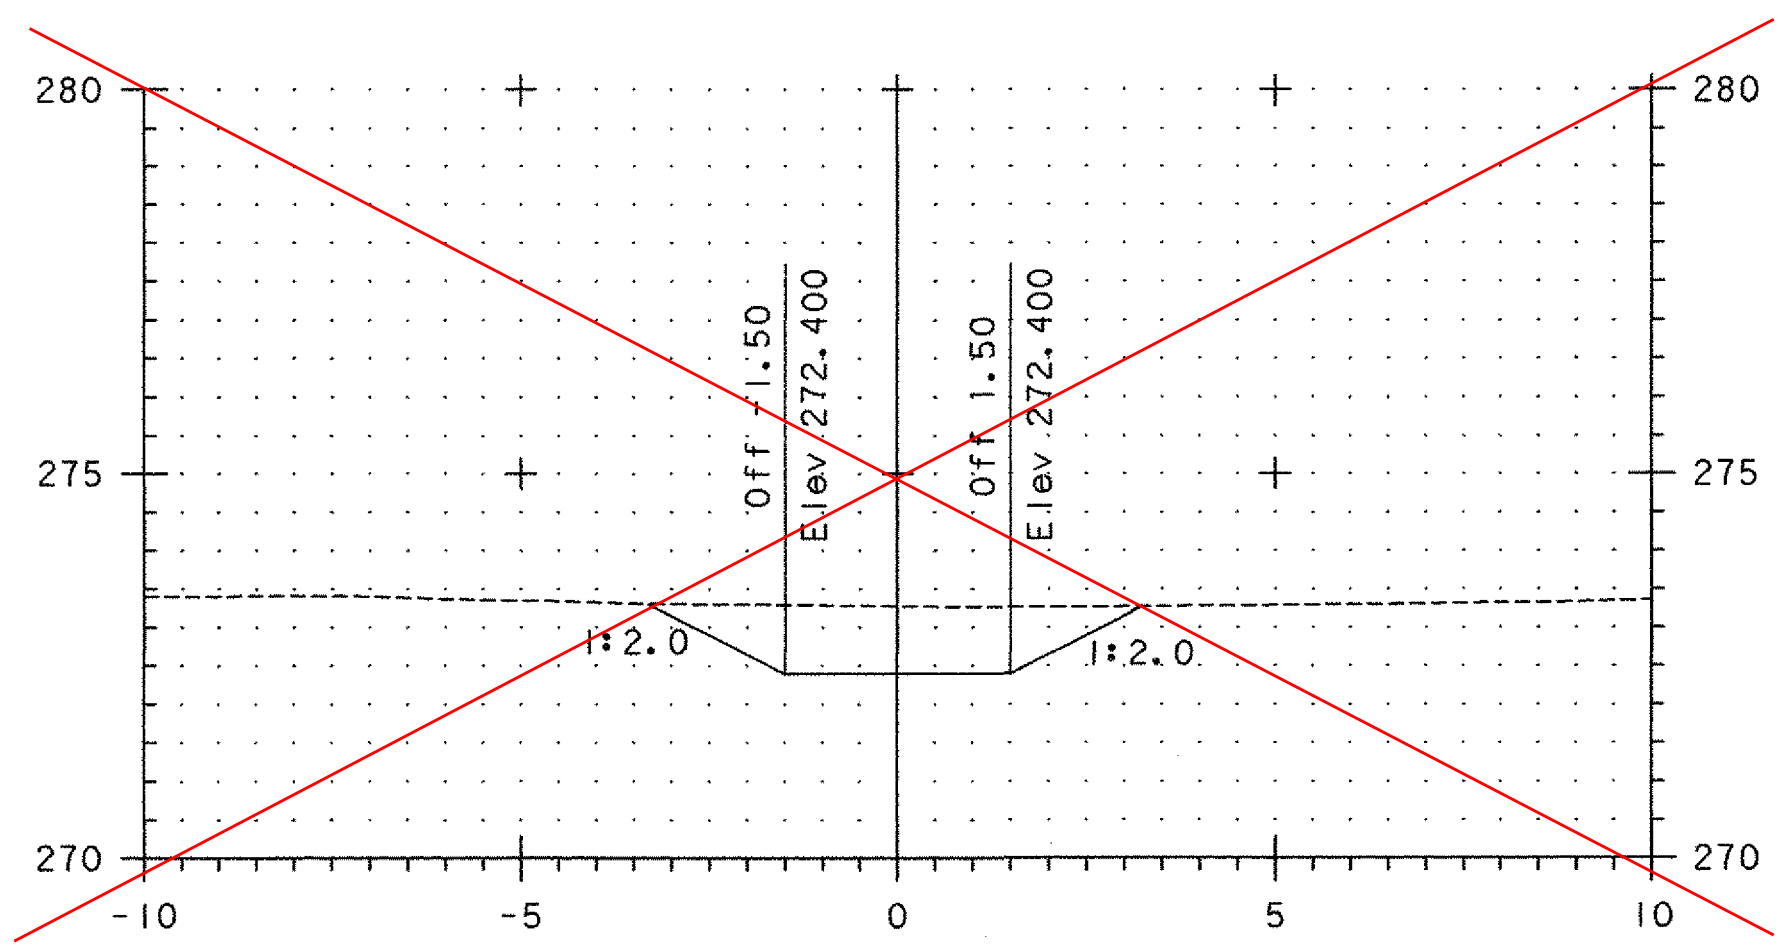


SW 10+000
 SW 1+000 TO SW 1+030
 IS NOT SWALE
 IT IS STONE OUTLET
 PROTECTION FOR CV439

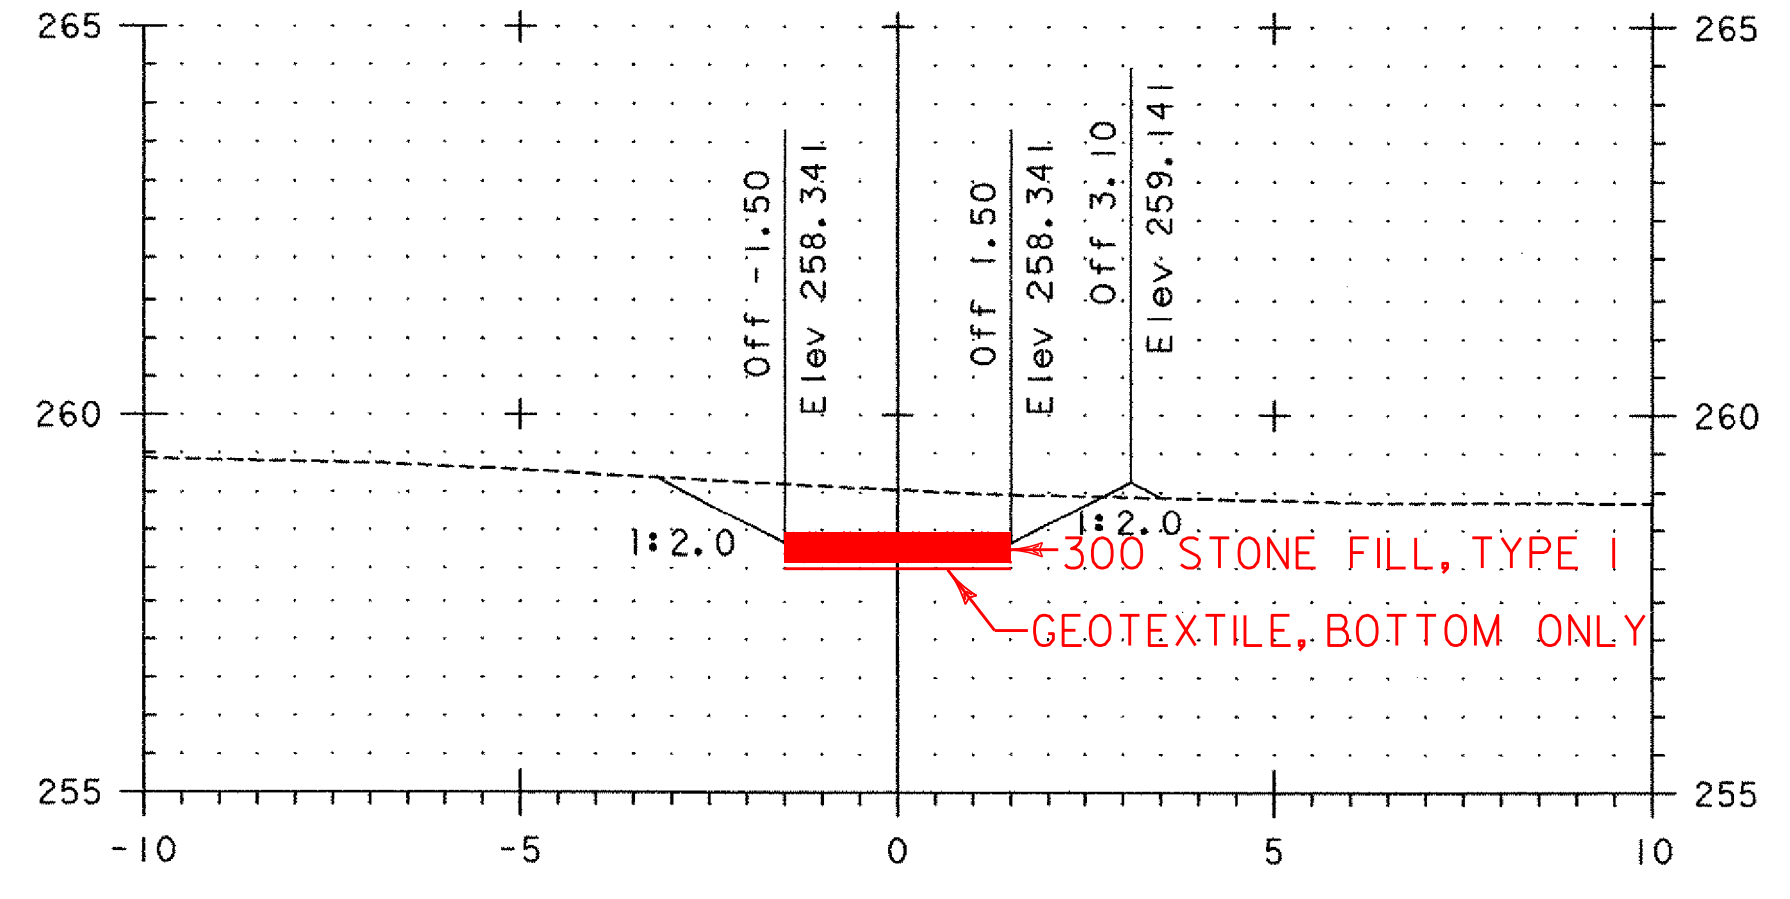


SW 10+080

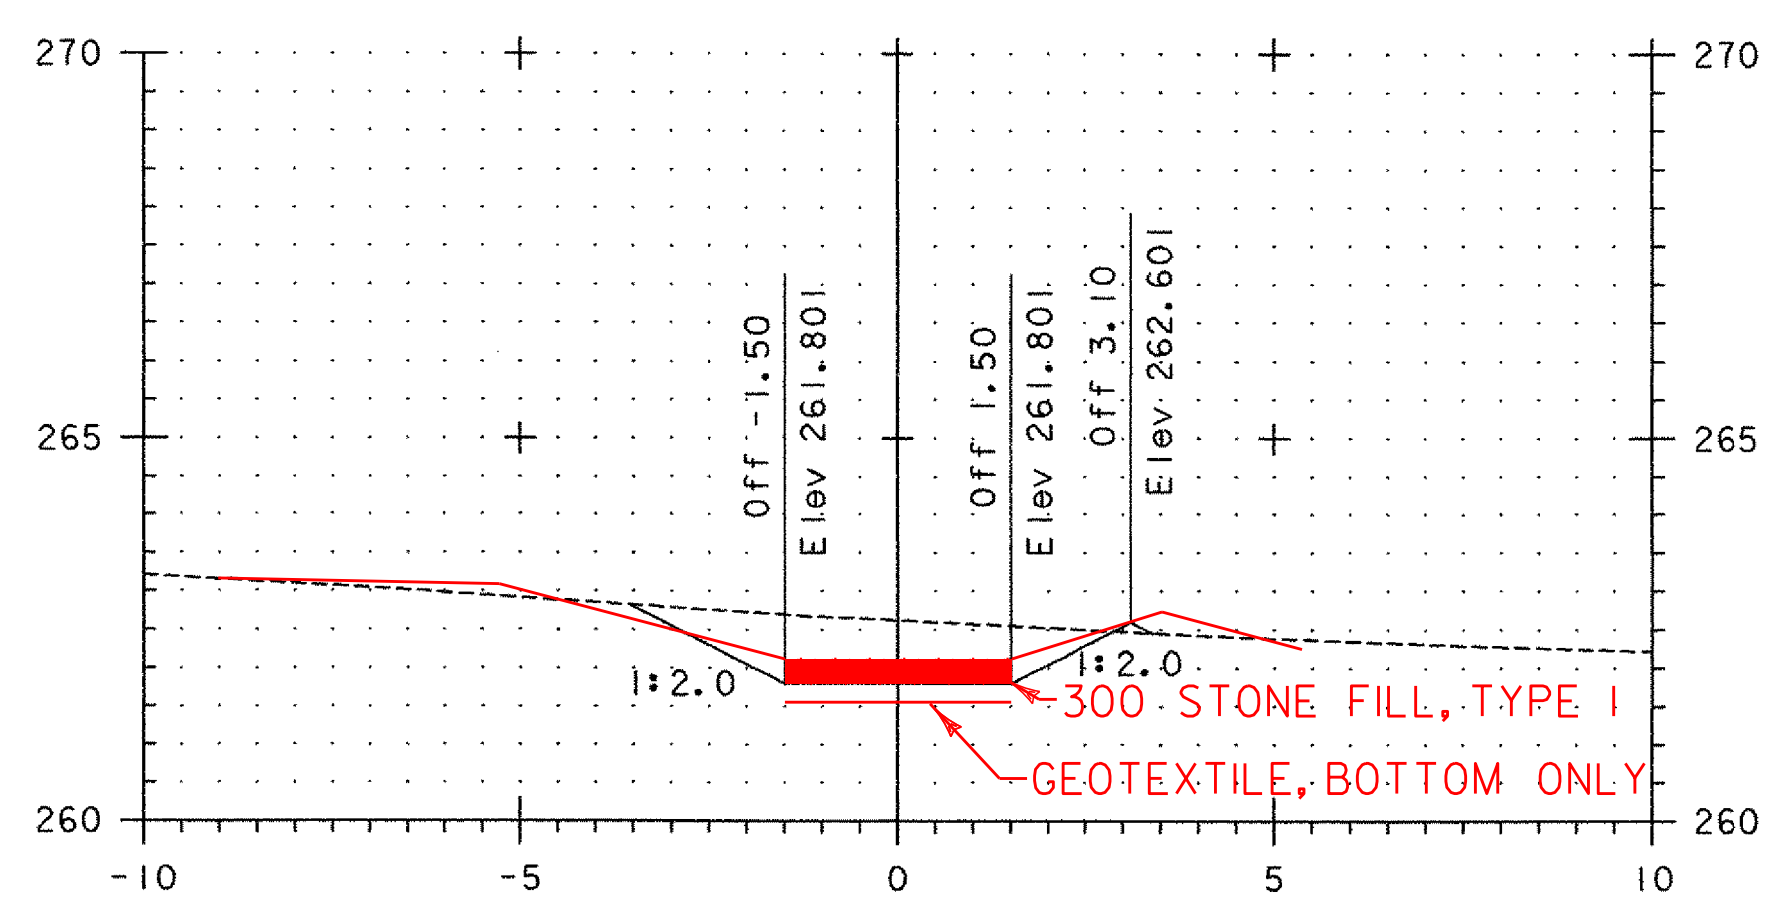

SW 10+060

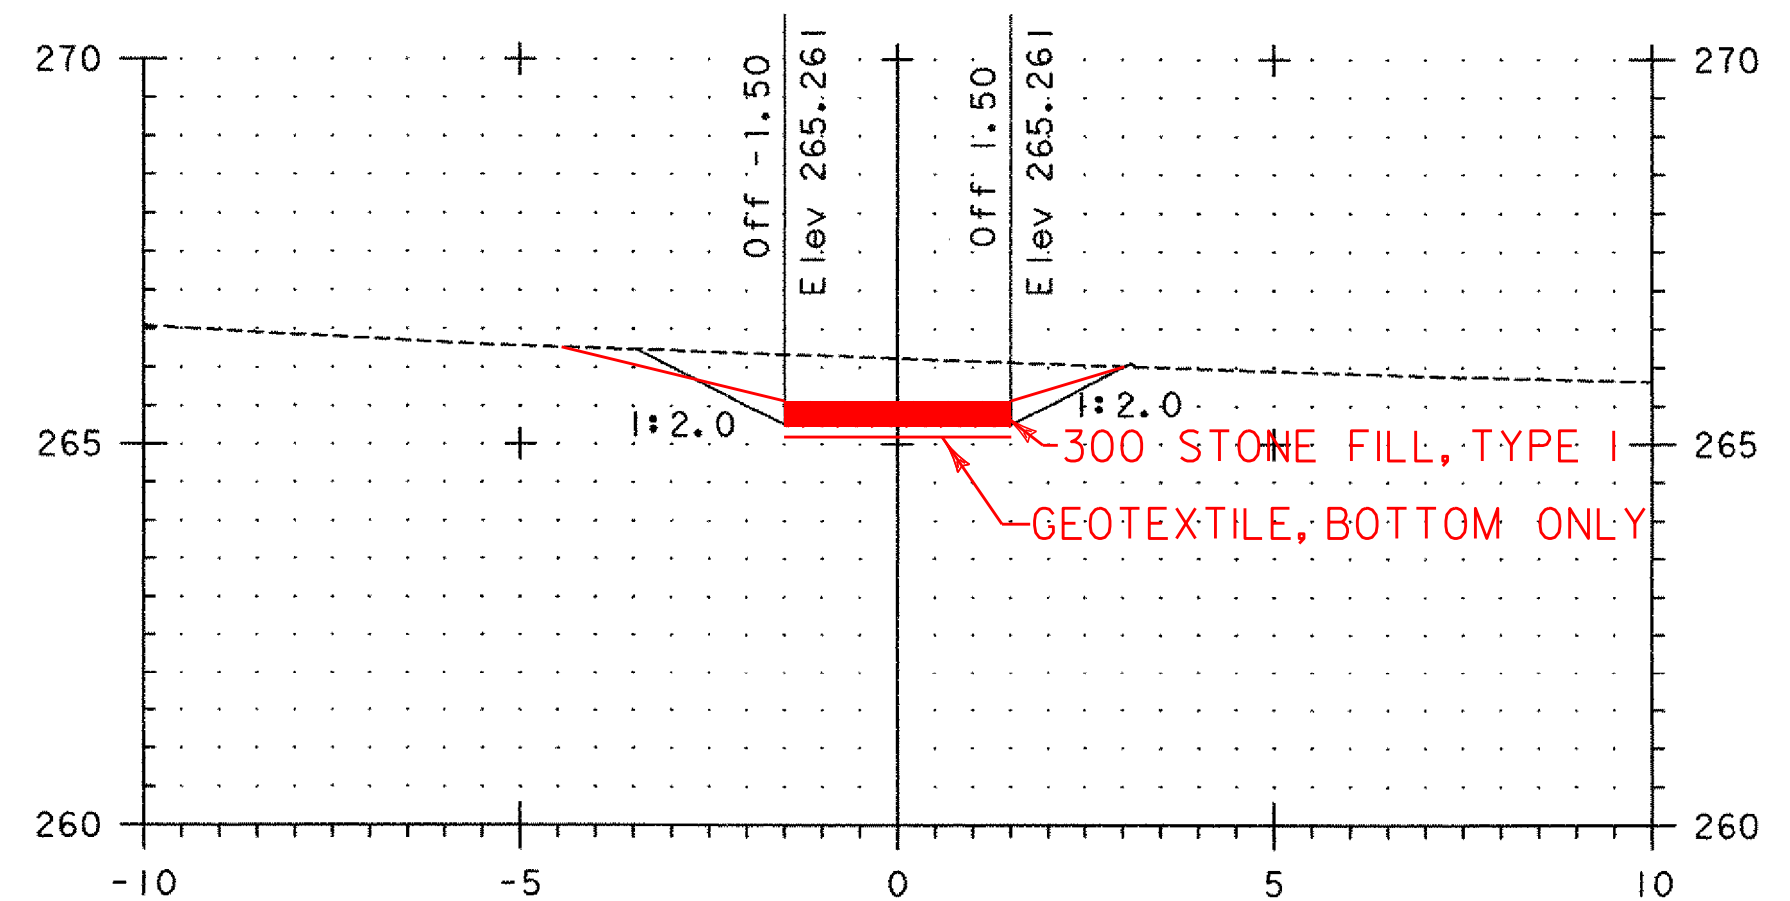

SW 10+040

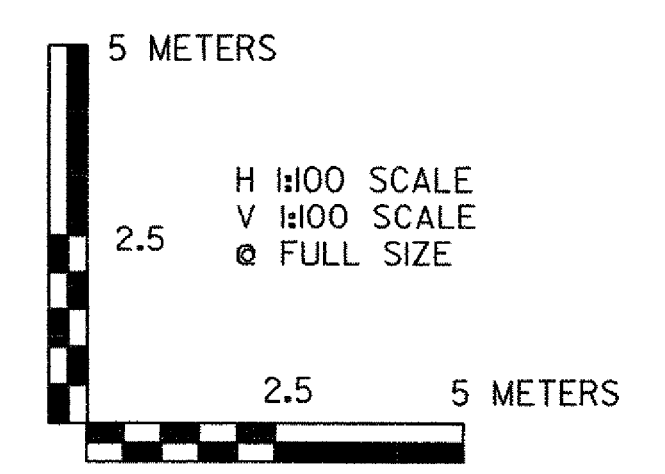

VERMONT AGENCY OF TRANSPORTATION	
	PROJECT NAME: BENNINGTON
	PROJECT NUMBER: AC NH 019-1(K52)
FILE NAME: ...vd307c2xs.prouty.ptf	PLOT DATE: 12/20/2007
DESIGN SUPERVISOR: GREG EDWARDS	DRAWN BY: STANTEC
DESIGNED BY: MARC FOISY	CHECKED BY: GARY SANTY
PROUTY SWALE CROSS SECTIONS PSX-1	SHEET 266 OF 267

V:\953\acofive\953\0002\transportation\drawing\contract_2\plot_files\vd307c2xs.prouty4.prf