




SW 10+140

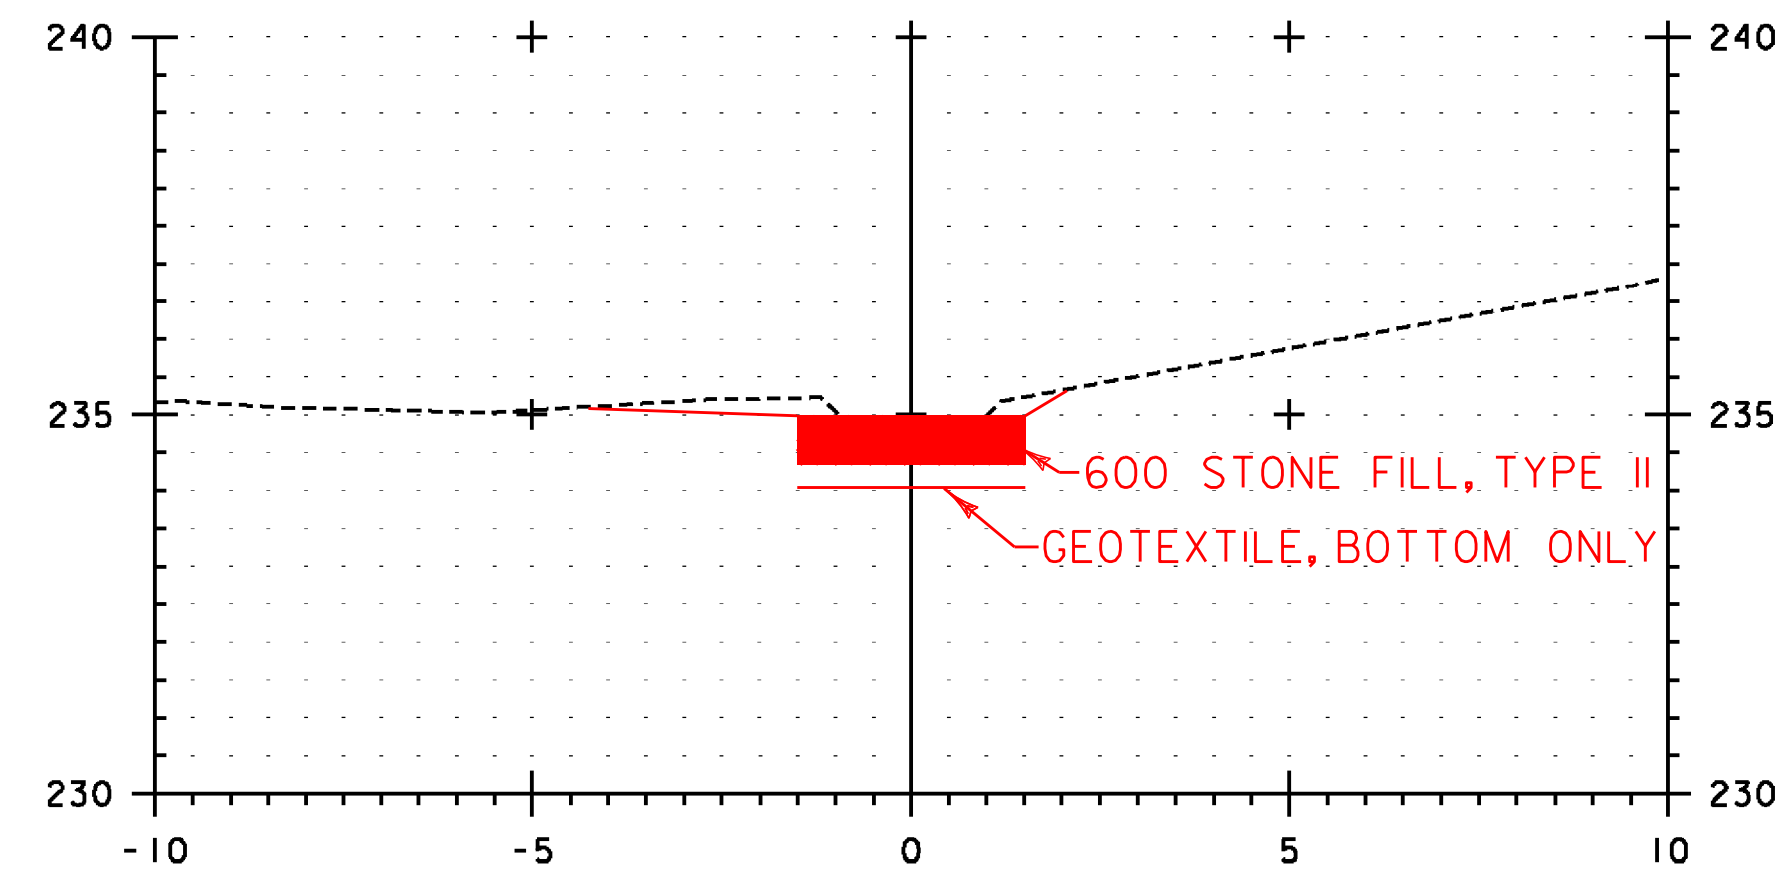


SW 10+200

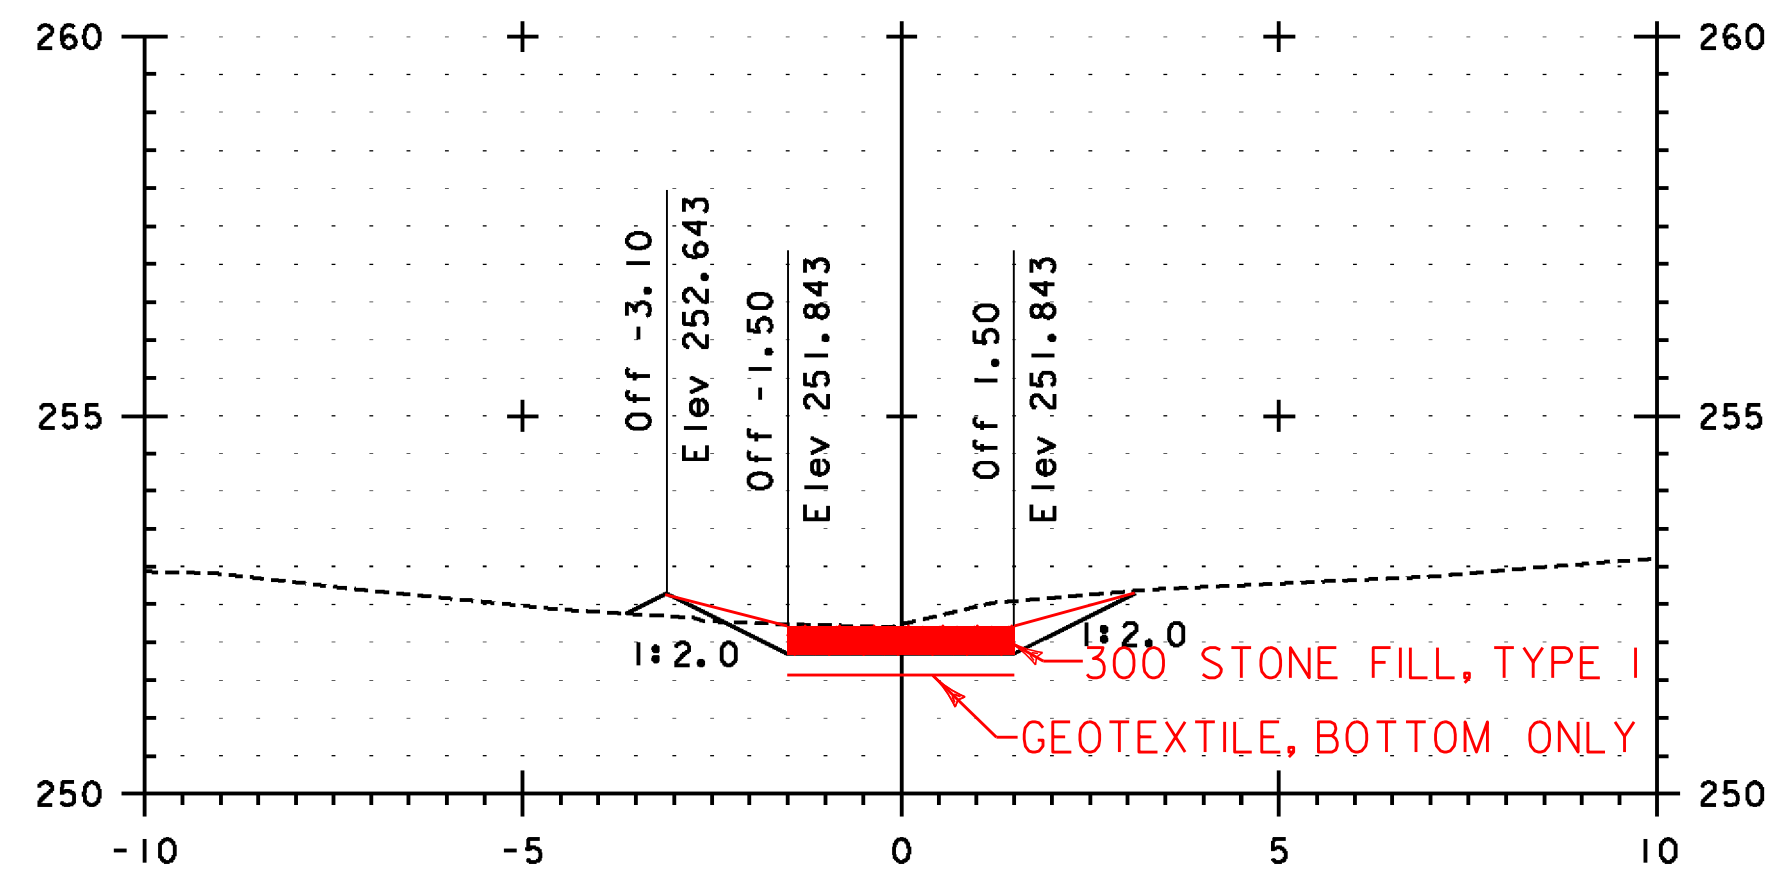


SW 10+120

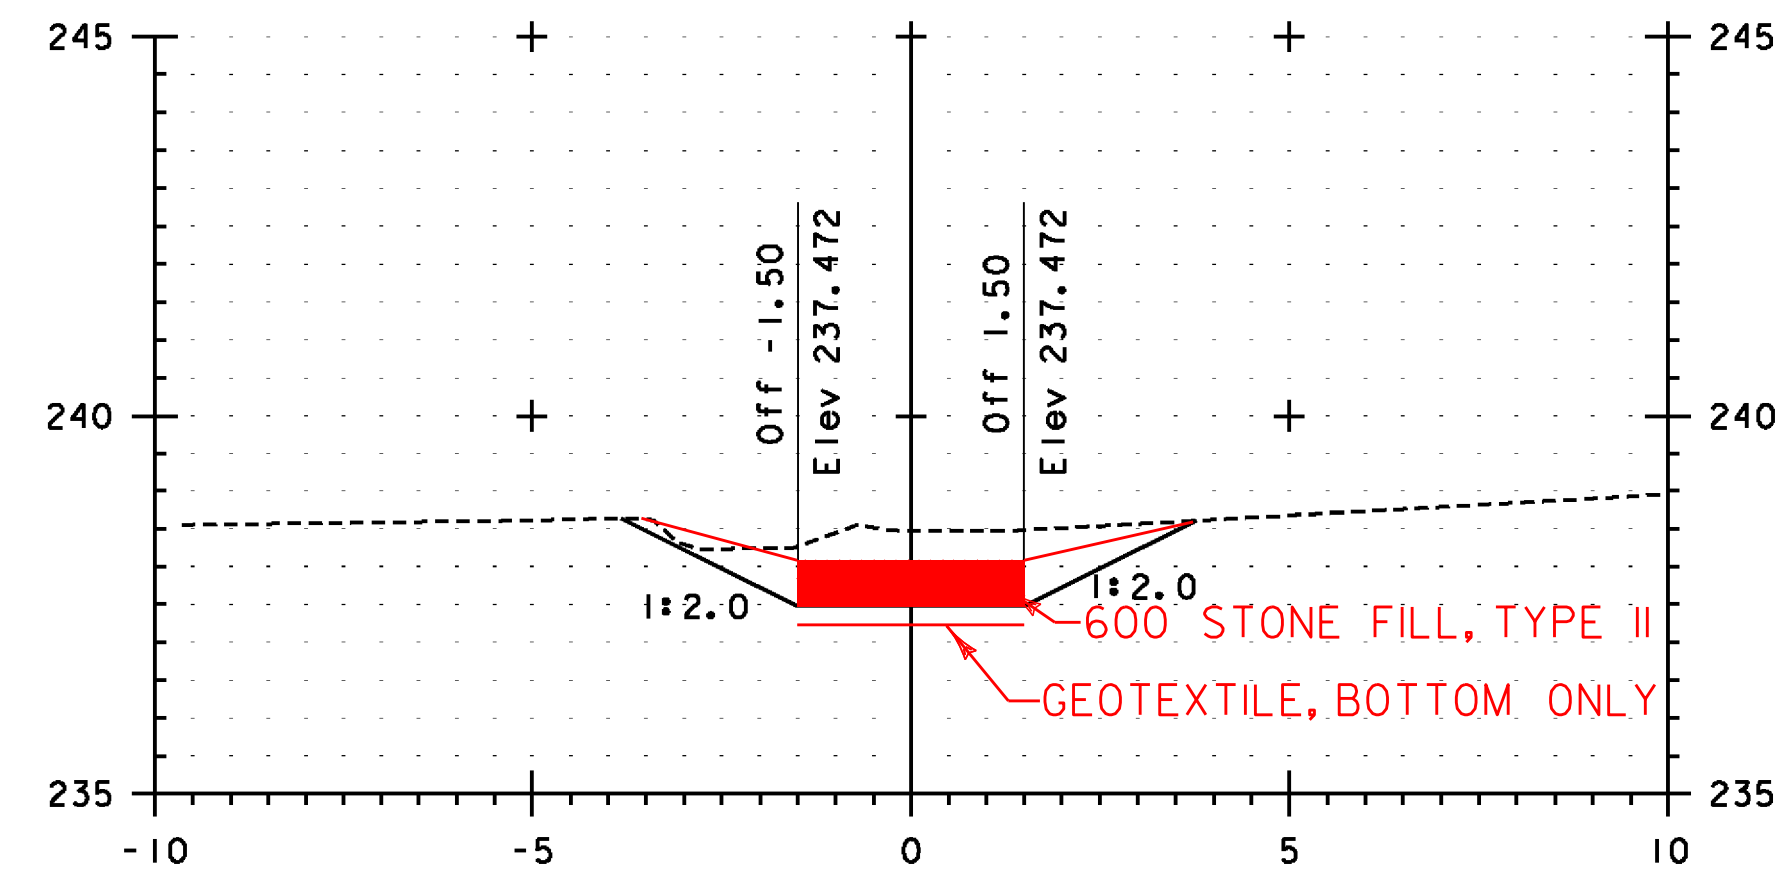


SW 10+180

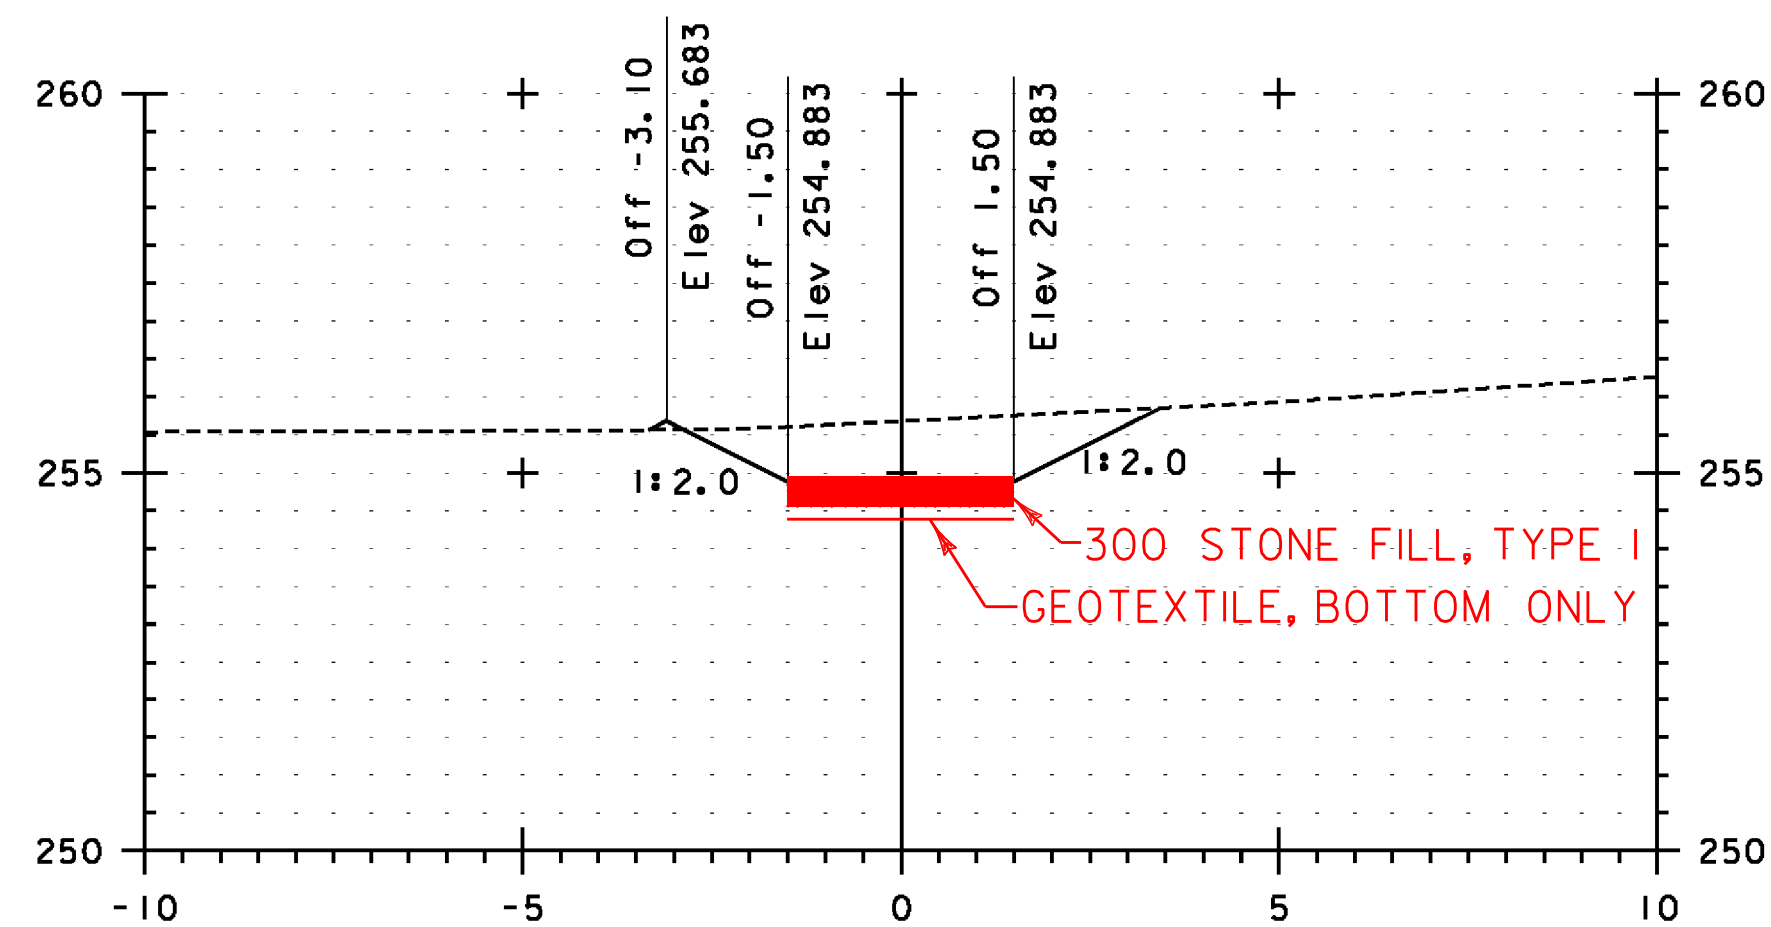

SW 10+100

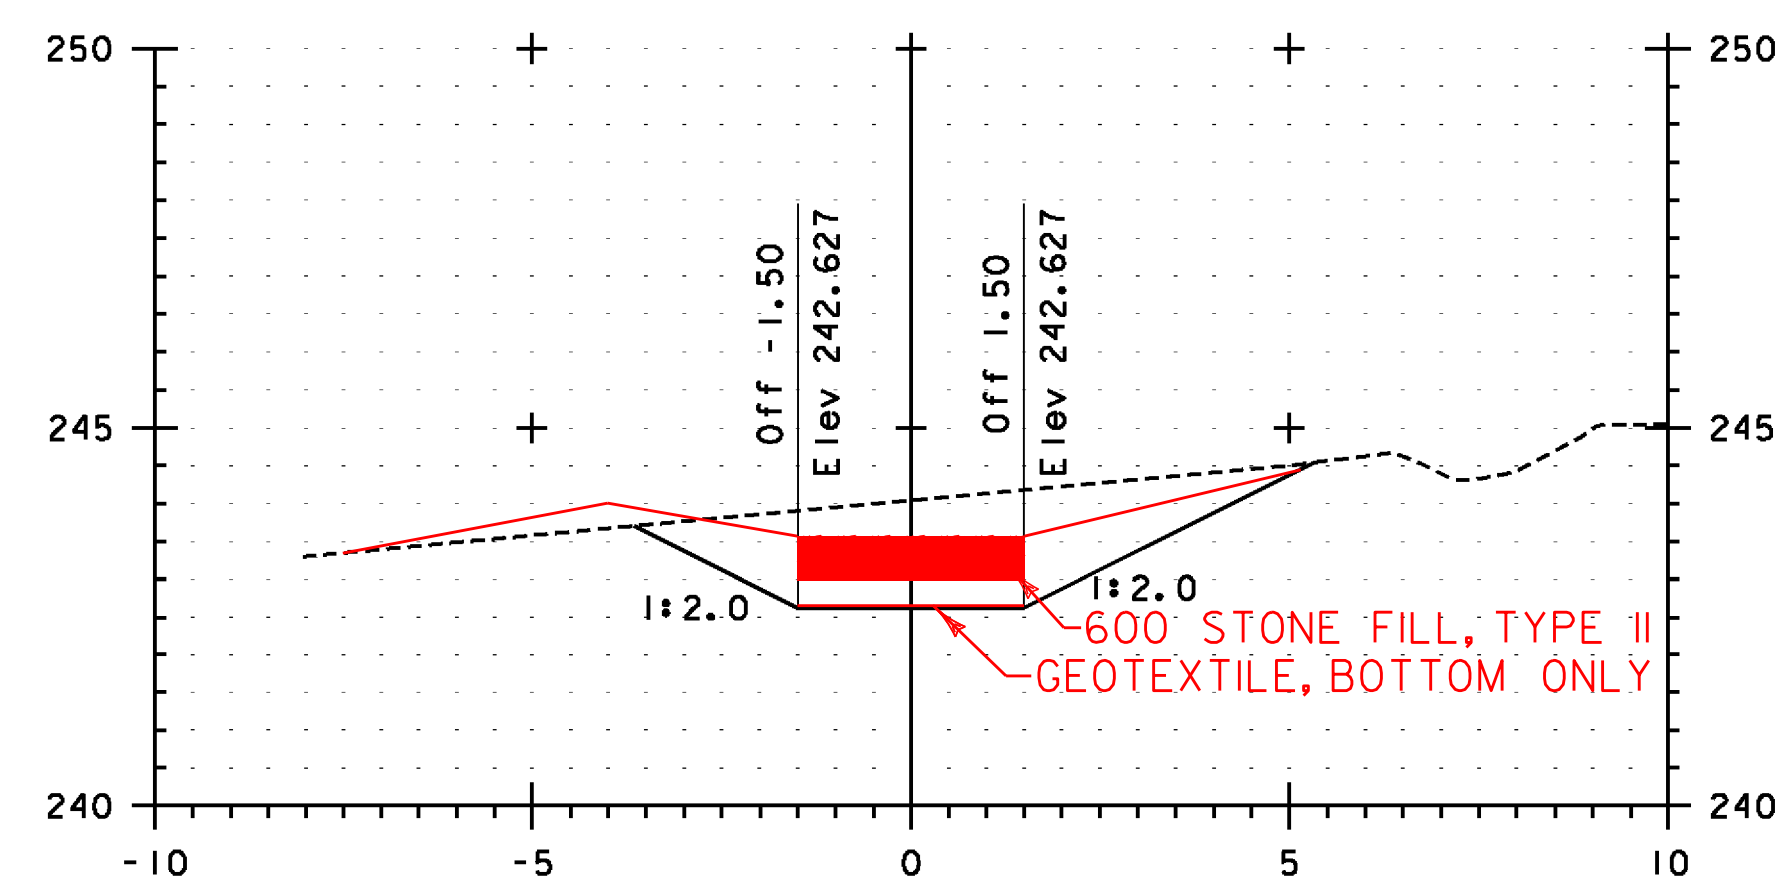

SW 10+160

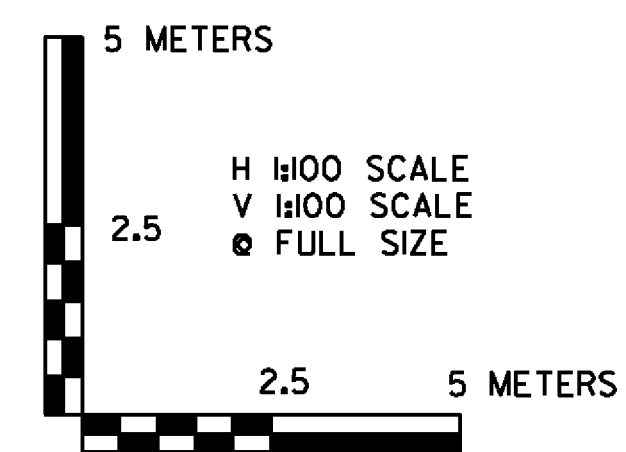

VERMONT AGENCY OF TRANSPORTATION	
	PROJECT NAME: BENNINGTON
	PROJECT NUMBER: AC NH 019-1(52)
FILE NAME: ...zd307c2xs.prouty.ptf	PLOT DATE: 5/18/2011
DESIGN SUPERVISOR: GREG EDWARDS	DRAWN BY: STANTEC
DESIGNED BY: MARC FOISY	CHECKED BY: GARY SANTY
PROUTY SWALE CROSS SECTIONS PSX-2	SHEET 267 OF 267

V:\1953\ac1ve\19530002\transportation\drawing\contract_2\plot_files\zd307c2xs.prouty.ptf