



**VT ROUTE 279 WESTBOUND / RAMP F DIVERGE
CRITICAL CROSS SECTIONS**

N. T. S.
FOR ADDITIONAL INFORMATION
SEE CROSS SECTION SHEETS:
WBX-02, WBX-03, WBX-04, WBX-05, FXS-01

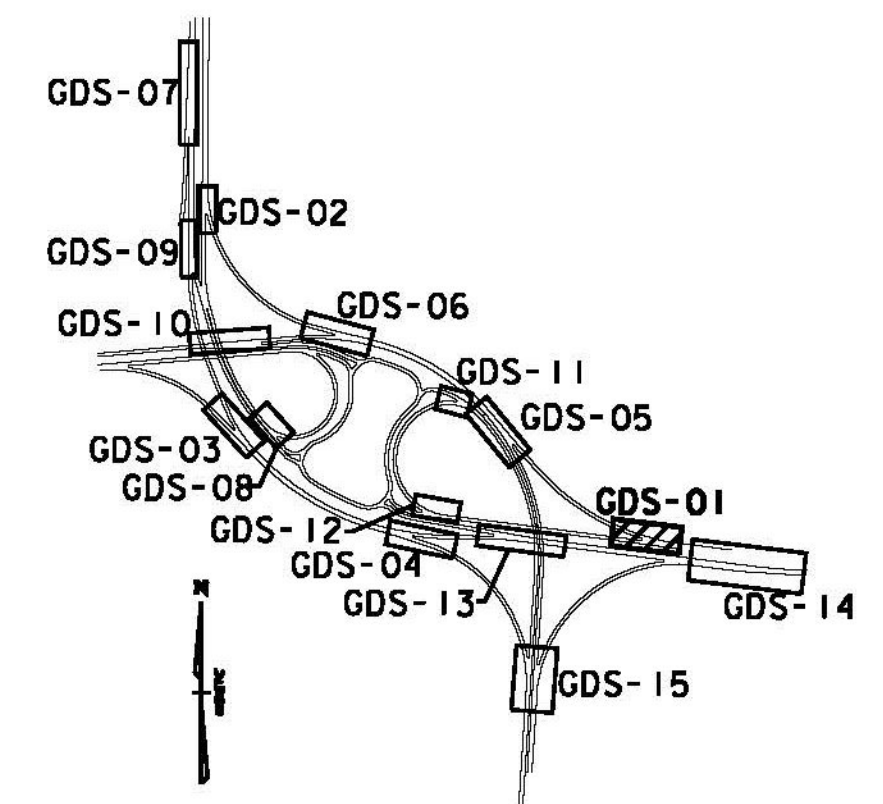

KEY MAP

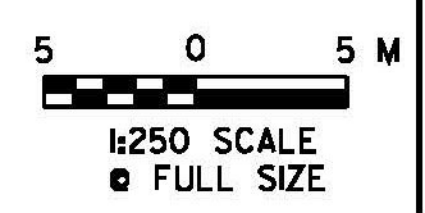

PROJECT NAME:	BENNINGTON
PROJECT NUMBER:	NH 019-1(54)
FILE NAME:	... \plot_files\zd307c4det.gore.prf
DESIGN SUPERVISOR:	GREG EDWARDS
DESIGNED BY:	MARC FOISY
GORE DETAIL SHEET -	GDS-01
PLOT DATE:	1/26/2010
DRAWN BY:	STANTEC
CHECKED BY:	GARY SANTY
SHEET	30 OF 468

1/26/2010 4:45:16 PM v:\953\active\953002\transportation\gore\main\contract\4\plot_files\zd307c4det.gore.prf