



VT ROUTE 279 WESTBOUND / U.S. ROUTE 7 NORTHBOUND MERGE
CRITICAL CROSS SECTIONS
 N. T. S.
 FOR ADDITIONAL INFORMATION
 SEE CROSS SECTION SHEETS:
 WBX-13, WBX-14

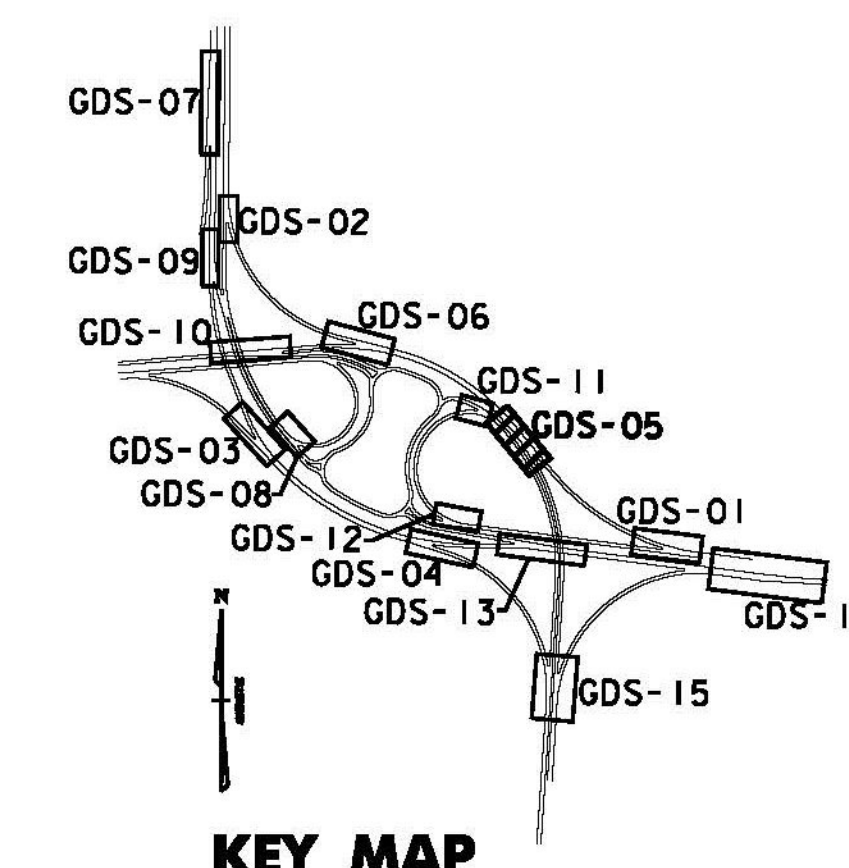

1/26/2010 4:46:20 PM v:\1955\active\19551002\transportation\drawings\comtr\cct-4\plot-1\files\zsd307c4det-gore.ppt

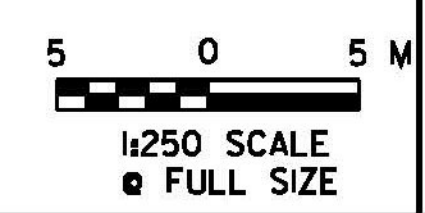

PROJECT NAME:	BENNINGTON
PROJECT NUMBER:	NH 019-1(54)
FILE NAME:	... \plot_files\zsd307c4det.gore.ppt
DESIGN SUPERVISOR:	GREG EDWARDS
DESIGNED BY:	MARC FOISY
GORE DETAIL SHEET -	GDS-05
PLOT DATE:	1/26/2010
DRAWN BY:	STANTEC
CHECKED BY:	GARY SANTY
SHEET	34 OF 468