



VT ROUTE 279 WESTBOUND / U.S. ROUTE 7 NORTHBOUND DIVERGE
CRITICAL CROSS SECTIONS

N. T. S.
 FOR ADDITIONAL INFORMATION
 SEE CROSS SECTION SHEETS:
 WBX-21, WBX-22, WBX-23, NBX-12, NBX-13

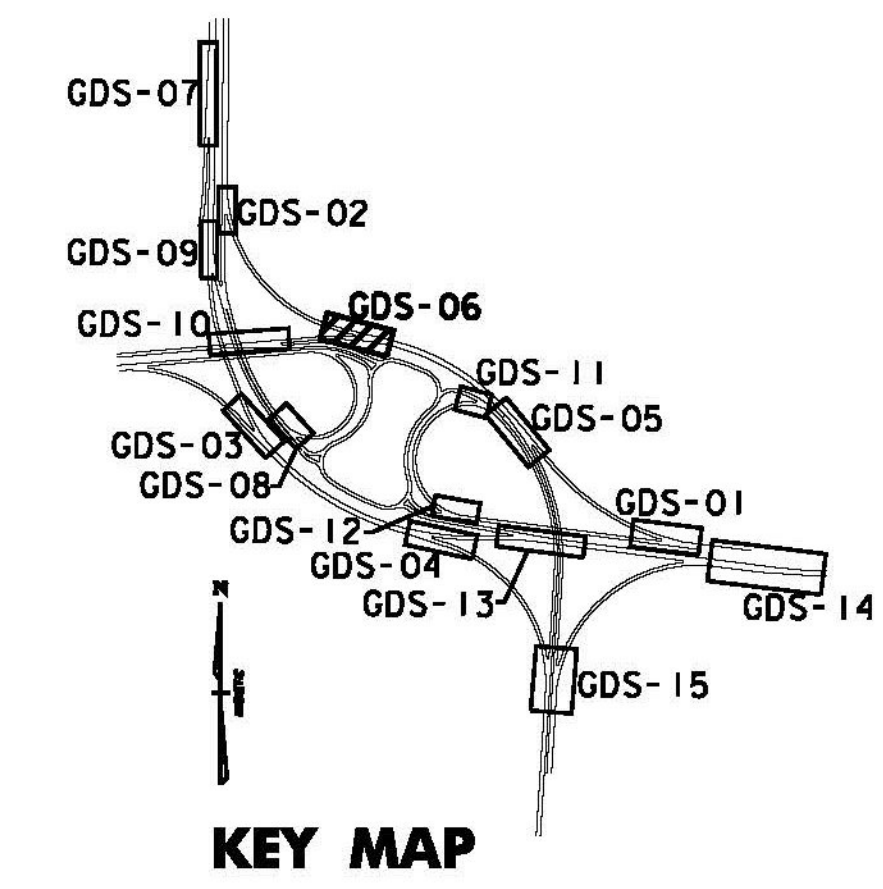

I:\25\2010_44621\W -\1953\active\1953002\transportation\gore\main\contract\4\plot_files\z307c4det_gore.ppt

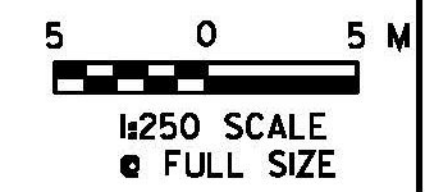

PROJECT NAME:	BENNINGTON
PROJECT NUMBER:	NH 019-1(54)
FILE NAME:	...\\plot_files\z307c4det_gore.ppt
DESIGN SUPERVISOR:	GREG EDWARDS
DESIGNED BY:	MARC FOISY
GORE DETAIL SHEET -	GDS-06
PLOT DATE:	1/26/2010
DRAWN BY:	STANTEC
CHECKED BY:	GARY SANTY
SHEET	35 OF 468