


**VT ROUTE 279 WESTBOUND / RAMP P MERGE
CRITICAL CROSS SECTIONS**

N. T. S.
FOR ADDITIONAL INFORMATION
SEE CROSS SECTION SHEETS:
WBX-24, WBX-25, WBX-26, PXS-03, PXS-04

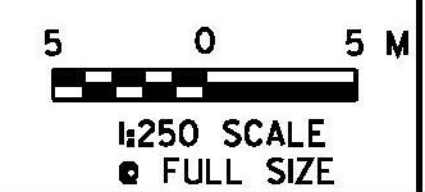

PROJECT NAME:	BENNINGTON
PROJECT NUMBER:	NH 019-1(54)
FILE NAME:	... \plot_files\zd307c4det.gore.ptf
DESIGN SUPERVISOR:	GREG EDWARDS
DESIGNED BY:	MARC FOISY
GORE DETAIL SHEET -	GDS-10
PLOT DATE:	1/26/2010
DRAWN BY:	STANTEC
CHECKED BY:	GARY SANTY
SHEET	39 OF 468

1/26/2010 4:46:26 PM v:\955\active\9551002\transportation\drawing\contract\4\plot_files\zd307c4det.gore.ptf