


**VT ROUTE 279 EASTBOUND / RAMP L  
CRITICAL CROSS SECTIONS**

N. T. S.  
FOR ADDITIONAL INFORMATION  
SEE CROSS SECTION SHEETS:  
EBX-01, LXS-06

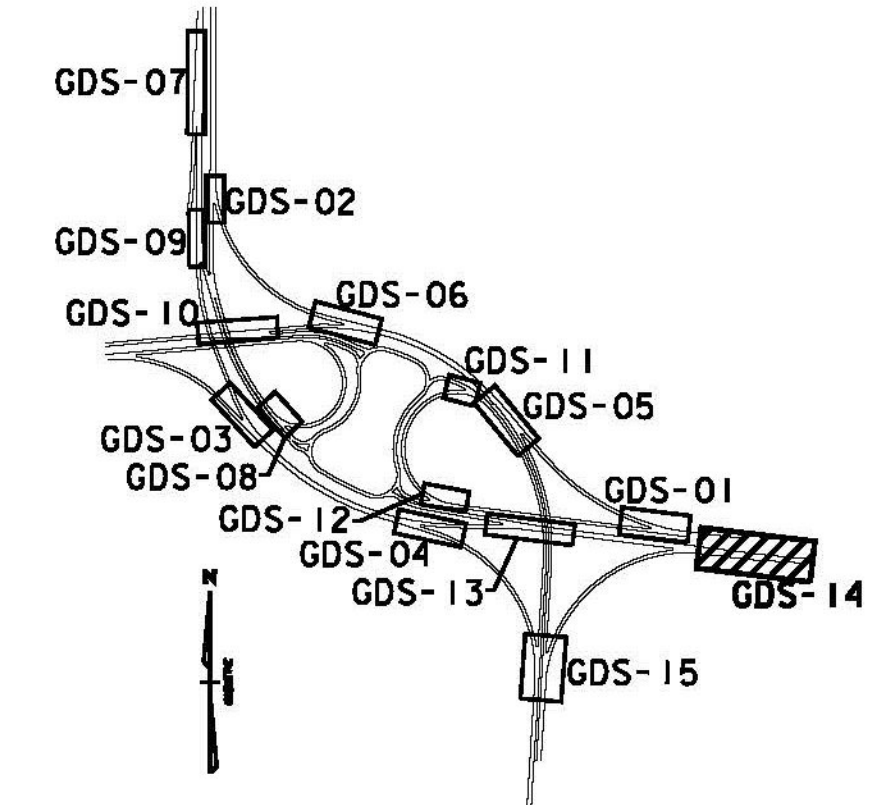

**KEY MAP**



PROJECT NAME:	BENNINGTON
PROJECT NUMBER:	NH 019-1(54)
FILE NAME:	...\\plot_files\zd307c4det.gore.ptf
DESIGN SUPERVISOR:	GREG EDWARDS
DESIGNED BY:	MARC FOISY
GORE DETAIL SHEET -	GDS-14
PLOT DATE:	1/26/2010
DRAWN BY:	STANTEC
CHECKED BY:	GARY SANTY
SHEET	43 OF 468

1/26/2010 4:46:30 PM v:\95\active\951002\transportation\drawing\contract\4\plot\_files\zd307c4det.gore.ptf