




REMOVING AND RESETTING FENCE
 STA DRN 20+055 - DRN 20+220 RT

GATE FOR CHAIN-LINK FENCE, 1.8 m (6 FEET)
 STA DRN 20+117.6 - DRN 20+120.0 RT
 STA DRN 20+120.0 - DRN 20+122.4 RT
 STA DRN 20+177.6 - DRN 20+180.0 RT
 STA DRN 20+180.0 - DRN 20+182.4 RT

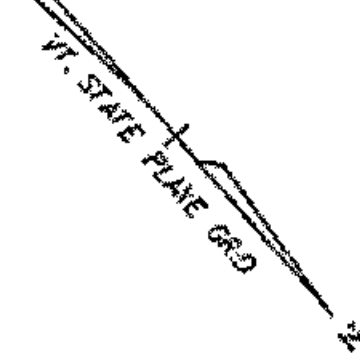

BENNINGTON HOUSING AUTHORITY

APPLGATE HOUSING LIMITED PARTNERSHIP

LEMAIRE, LAURENCE-P. JR. & LINDA L. ZENO

N/F DICKIE

STATE OF VERMONT

ORCHARD ROAD

COLLECTOR DISTRIBUTOR CB 1+200

MATCH LINE SHEET ROW-19

Record Plans

DATUM
 VERTICAL NAVD 88
 HORIZONTAL NAD 83 (1982)

LINES SHOWN ON THIS PLAN AS EXISTING PROPERTY LINES P/L ARE BELIEVED TO BE ACCURATE BUT SHOULD NOT BE RELIED UPON FOR PURPOSES UNRELATED TO THE STATE OF VERMONT'S ACQUISITION OF LAND AND RIGHTS FOR THIS PROJECT.

THIS SHEET TO BE USED FOR RIGHT-OF-WAY INFORMATION ONLY



R.O.W. PLAN
ROW-19A

PROJECT NAME: BENNINGTON	PROJECT NUMBER: NH 019-1(54)
DESIGN FILE NAME: c:\ndn\bennington\row	PLOT DATE: 8-27-12
PROJECT LEADER: JOP	DRAWN BY: ADM
	CHECKED BY: GAK
	SHEET: 91 OF 112