


CURVE SI	CURVE CNI
$\Delta = 82^{\circ}08'14.5''$ RT. $R. = 50.000m$ $T. = 43.570m$ $L. = 71.678m$ $E. = 16.320m$ $BANK = 0.060$ PI STA. S1+073.570 $N = 45209.2201$ $E = 442713.9169$ PC N = 45184.4691 $E = 442678.0602$ PT N = 45177.0864 $E = 442743.3403$	$\Delta = 91^{\circ}05'41.6''$ $R. = 465.700m$ $T. = 474.685$ $L. = 740.419m$ $E. = 199.283$ $BANK = 0.069$ Ls = 61.000m $\theta = 03^{\circ}45'08.9''$ $Ts = 572.307m$ $Lt = 40.676m$ $St = 20.342m$ PI STA. CN2+187.328 $N = 45343.9089$ $E = 442869.5951$ TS N = 44808.2875 $E = 442868.6700$ SC N = 44869.2261 $E = 442871.1345$ CS N = 45333.2994 $E = 442395.0283$ ST N = 45329.2762 $E = 442334.1728$

CURVE OI
$\Delta = 116^{\circ}50'48.7''$ LT. $R. = 50.000m$ $T. = 81.348m$ $L. = 101.968m$ $E. = 45.486m$ $BANK = 0.060$ PI STA. OI+081.348 $N = 45335.2497$ $E = 442459.8160$ PC N = 45312.0287 $E = 442537.7797$ PT N = 45255.2024 $E = 442474.3069$

CURVE CN2
$\Delta = 91^{\circ}06'59.6''$ LT. $R. = 468.400m$ $T. = 477.618m$ $L. = 744.889m$ $E. = 200.568m$ $BANK = 0.069$ Ls = 61.177m $Os = 3^{\circ}44'29.9''$ $Ts = 575.534m$ $Lt = 40.793m$ $St = 20.400m$

PI STA. CN 2+187.929 $N = 45346.7621$ $E = 442872.3761$ TS N = 44808.0314 $E = 442871.3593$ SC N = 44848.7459 $E = 442873.8348$ CS N = 45335.9968 $E = 442394.8794$ ST N = 45335.5370 $E = 442374.4841$


CURVE RI
$\Delta = 84^{\circ}46'06.2''$ RT. $R. = 70.000m$ $T. = 63.883m$ $L. = 103.564m$ $E. = 24.769m$ $BANK = 0.060$ PI STA. RI+528.649 $N = 45318.1042$ $E = 442458.0418$ PC N = 45312.5036 $E = 442394.4044$ PT N = 45255.2425 $E = 442469.4216$

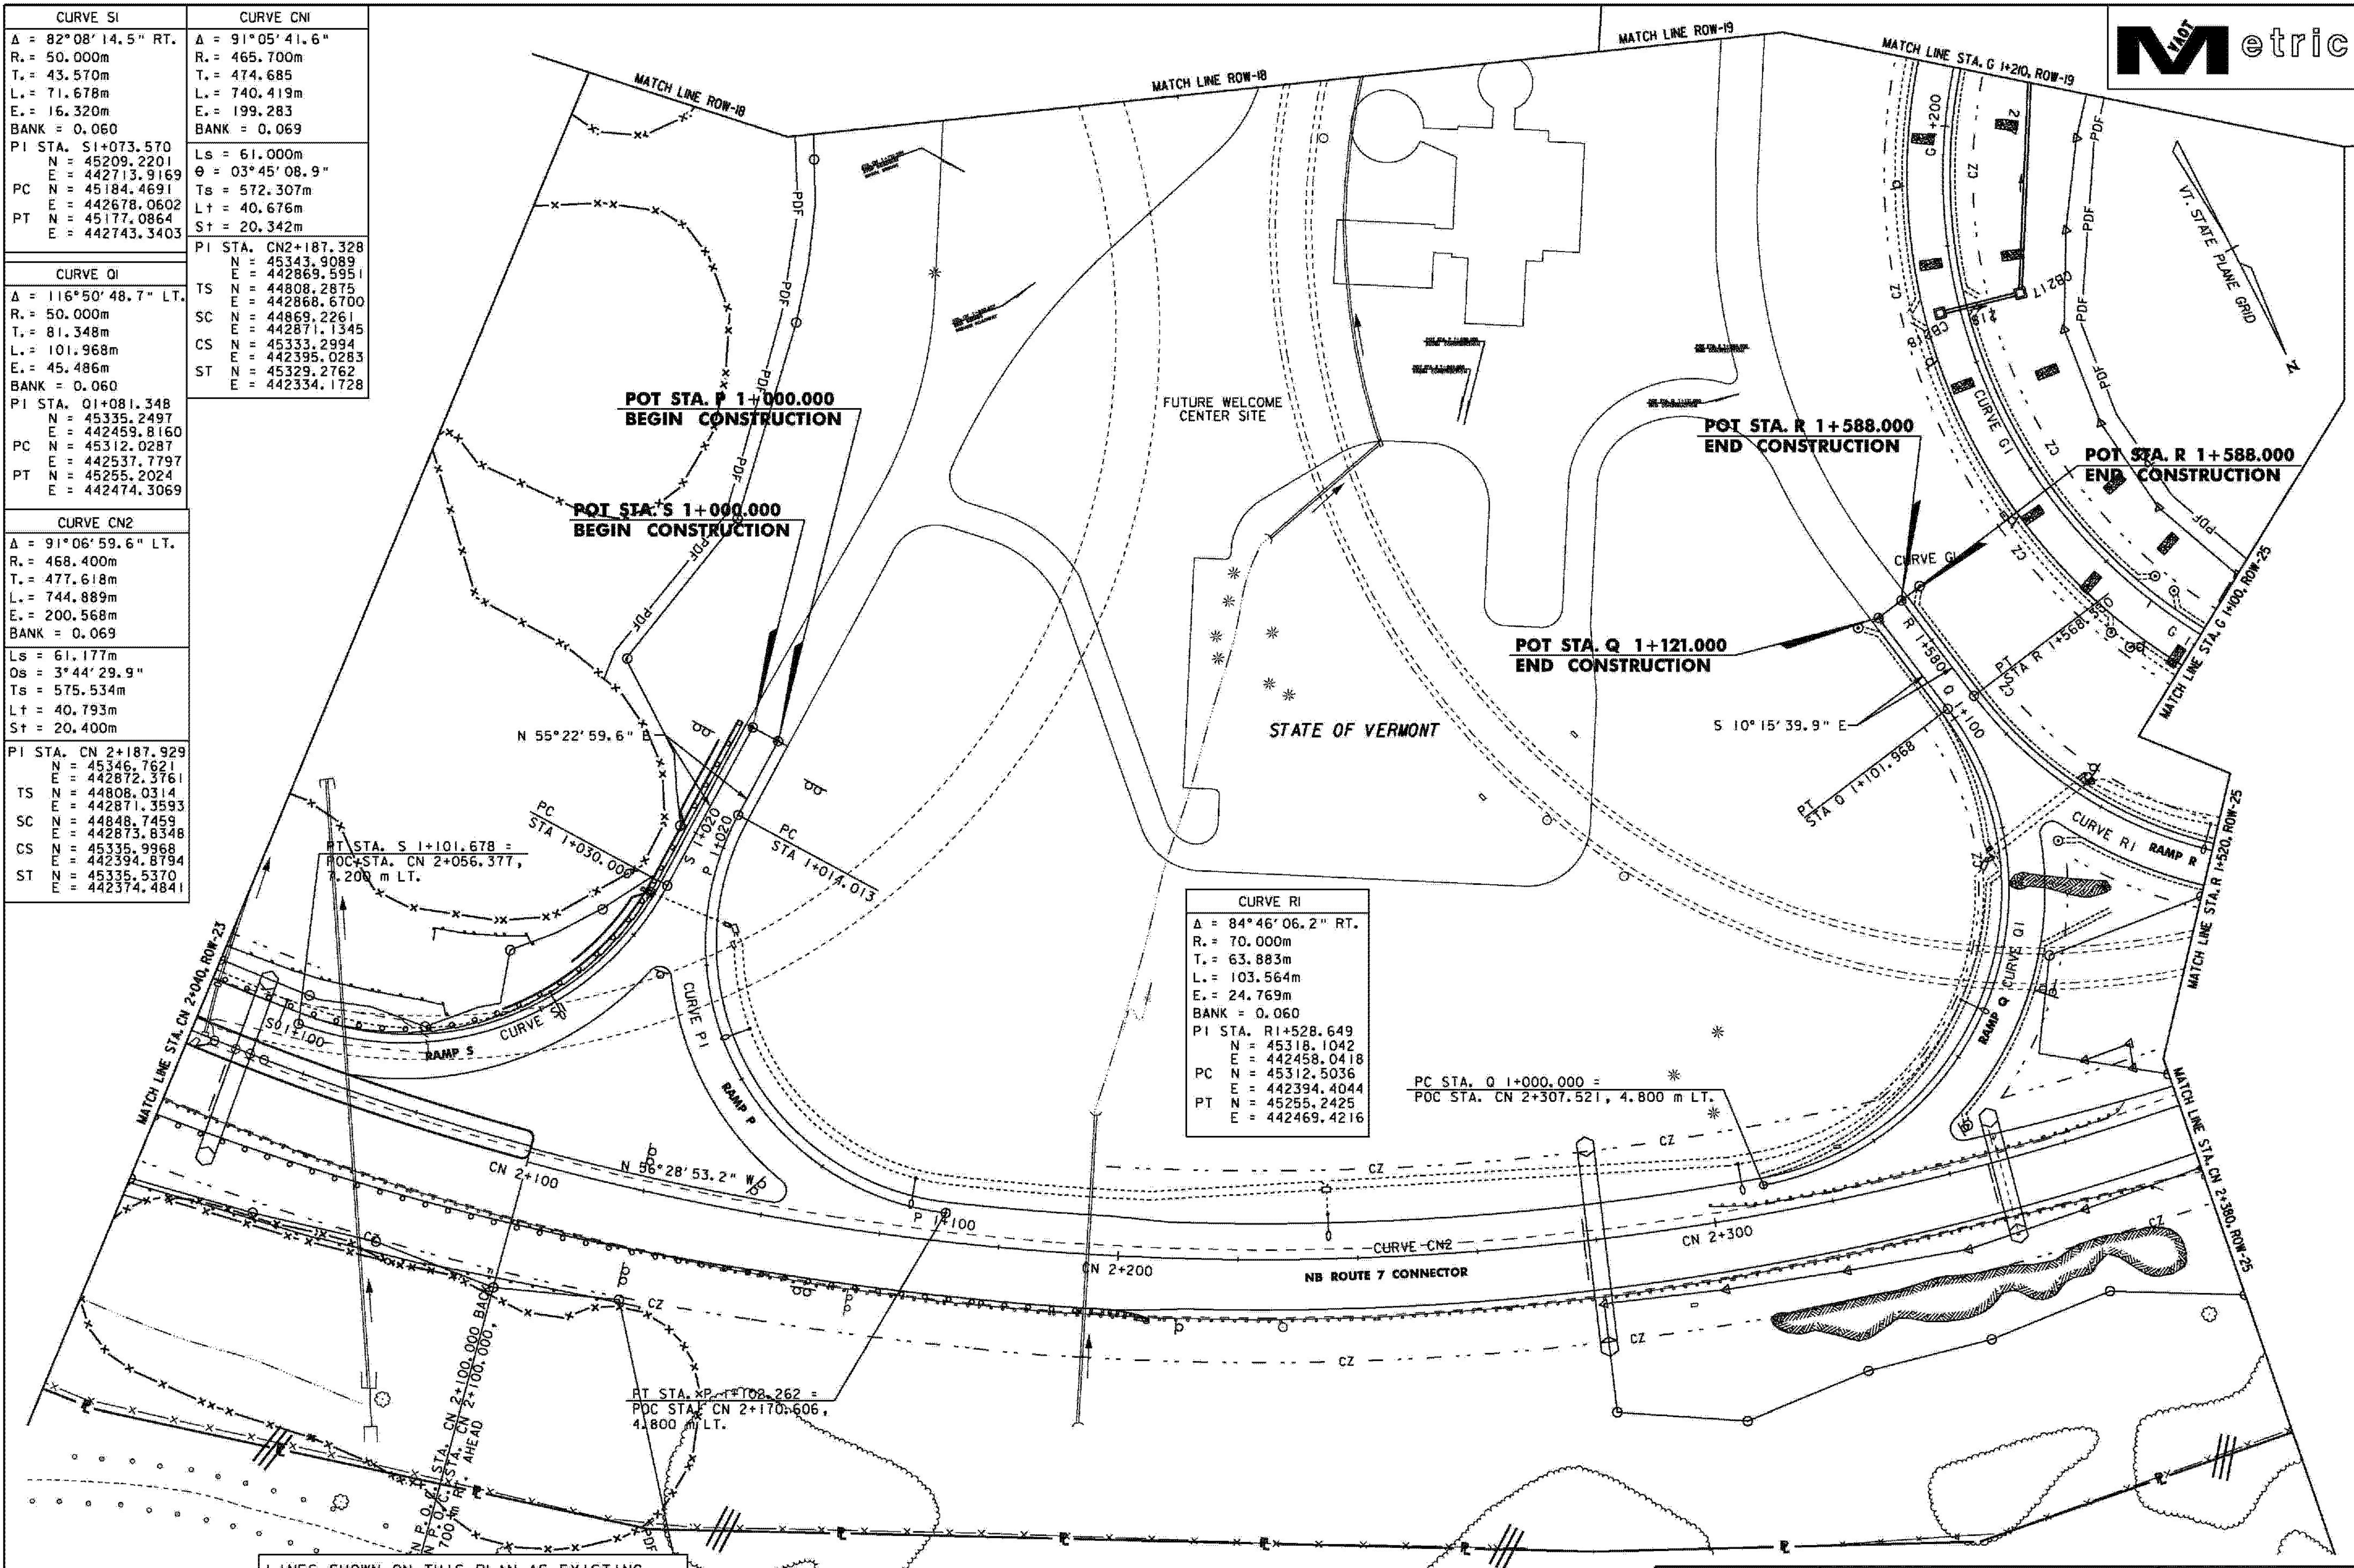

LINES SHOWN ON THIS PLAN AS EXISTING PROPERTY LINES P/L ARE BELIEVED TO BE ACCURATE BUT SHOULD NOT BE RELIED UPON FOR PURPOSES UNRELATED TO THE STATE OF VERMONT'S ACQUISITION OF LAND AND RIGHTS FOR THIS PROJECT.

THIS SHEET TO BE USED FOR RIGHT-OF-WAY INFORMATION ONLY

DATUM	
VERTICAL	NAVD 88
HORIZONTAL	NAD 83 (1992)

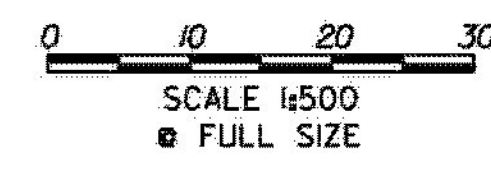

R.O.W. PLAN
ROW-24

PROJECT NAME: BENNINGTON
 DESIGN FILE NAME: c:\nh\bennington\row
 PROJECT LEADER: JDP

PROJECT NUMBER: NH 019-(54)

PLOT DATE: 1-25-10
 DRAWN BY: MBB
 CHECKED BY: GAK