
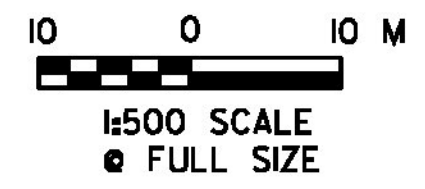
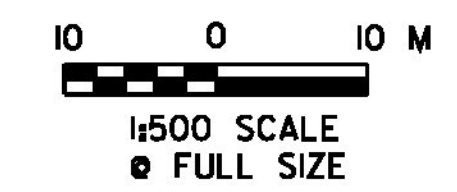


STA. NB 11+140.000
END BOX WIDENING

STA. NB 11+254.574
END COLD PLANE/OVERLAY
END CONSTRUCTION

STA. SB 11+488.856
END COLD PLANE/OVERLAY
END CONSTRUCTION

**APPLEGATE DRAINAGE
ALIGNMENT**

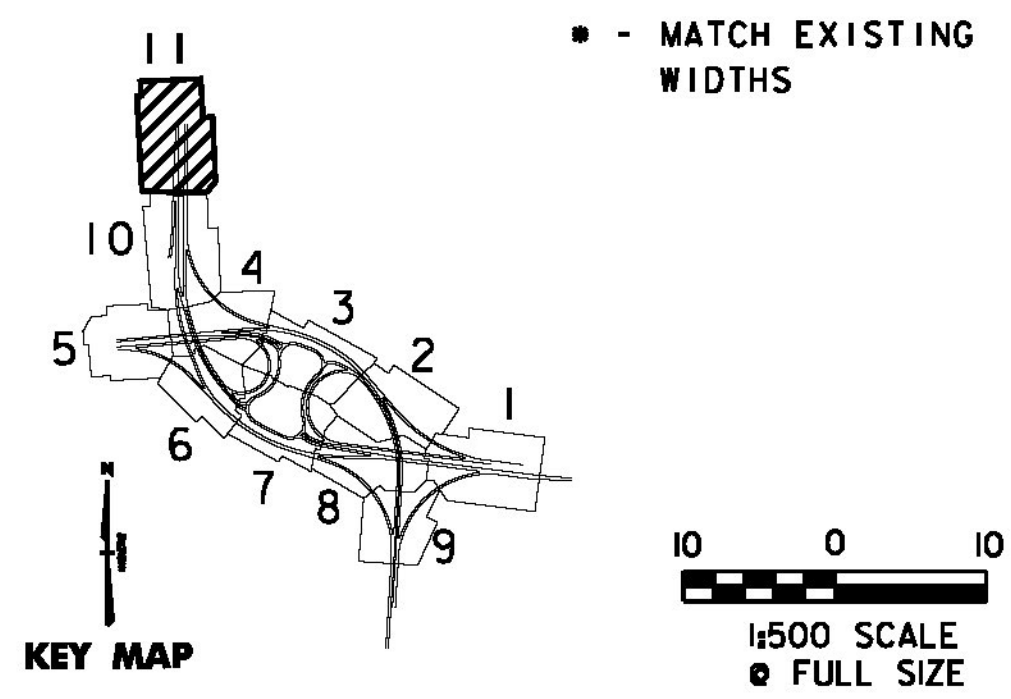

PROJECT NAME: BENNINGTON
PROJECT NUMBER: NH 019-1(54)

FILE NAME: ...z307c4alg.plans.ptf
DESIGN SUPERVISOR: GREG EDWARDS
DESIGNED BY: MARC FOISY
ALIGNMENT PLAN A-11

PLOT DATE: 1/26/2010
DRAWN BY: STANTEC
CHECKED BY: GARY SANTY
SHEET 76 OF 468

1/26/2010 4:47:02 PM v:\953\active\953002\transportation\drainage\contract\4\blot_files\z307c4alg.plans.ptf