


NOTE:
 ELEVATIONS SHOWN TO THE NEAREST HUNDREDTH ARE EXISTING GROUND.
 ELEVATIONS SHOWN TO THE NEAREST THOUSANDTH ARE FINISH GRADE.

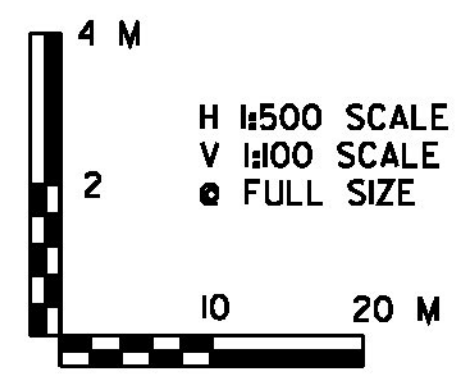

PROJECT NAME:	BENNINGTON	PLOT DATE:	1/26/2010
PROJECT NUMBER:	NH 019-1(54)	DRAWN BY:	STANTEC
FILE NAME:	...zd307c4pro.279WB.ptf	DESIGNED BY:	GARY SANTY
DESIGN SUPERVISOR:	GREG EDWARDS	CHECKED BY:	GARY SANTY
VT ROUTE 279 WESTBOUND PRO-01		SHEET	77 OF 468

I:\26\2010_447\05 PM v\1953\active\1953002\transportation\drawings\contract\4\blot_files\z307c4pro.279WB.plt