


NOTE:  
ELEVATIONS SHOWN TO THE NEAREST HUNDREDTH ARE EXISTING GROUND.  
ELEVATIONS SHOWN TO THE NEAREST THOUSANDTH ARE FINISH GRADE.

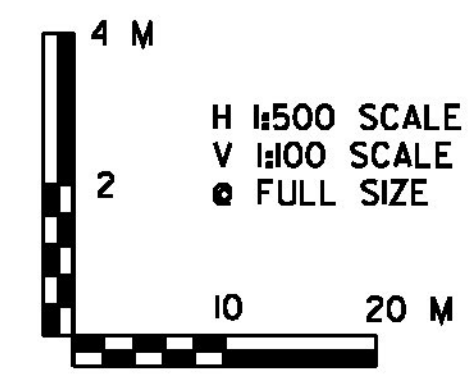

|                               |                          |
|-------------------------------|--------------------------|
| PROJECT NAME:                 | BENNINGTON               |
| PROJECT NUMBER:               | NH 019-1(54)             |
| FILE NAME:                    | ..\\zd307c4pro.279WB.ptf |
| DESIGN SUPERVISOR:            | GREG EDWARDS             |
| DESIGNED BY:                  | MARC FOISY               |
| VT ROUTE 279 WESTBOUND PRO-02 |                          |
| PLOT DATE:                    | 1/26/2010                |
| DRAWN BY:                     | STANTEC                  |
| CHECKED BY:                   | GARY SANTY               |
| SHEET                         | 78 OF 468                |

I:\26\2010\_4\47\06 PM\1\953\active\1953002\transportation\drawing\const\c4\pblst\_files\z307c4pro.279WB.ptf