


NOTE:
 ELEVATIONS SHOWN TO THE NEAREST HUNDREDTH ARE EXISTING GROUND.
 ELEVATIONS SHOWN TO THE NEAREST THOUSANDTH ARE FINISH GRADE.

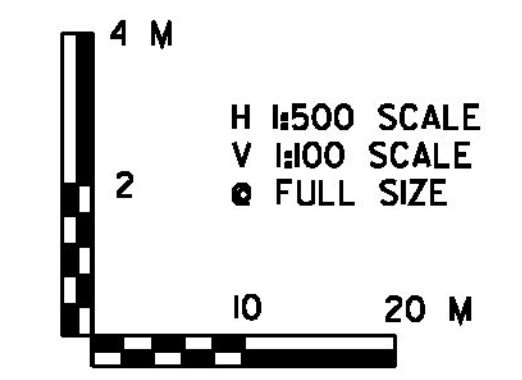

PROJECT NAME:	BENNINGTON	PLOT DATE:	1/26/2010
PROJECT NUMBER:	NH 019-1(54)	DRAWN BY:	STANTEC
FILE NAME:	..\\zd307c4pro.279WB.ptf	CHECKED BY:	GARY SANTY
DESIGN SUPERVISOR:	GREG EDWARDS	SHEET	79 OF 468
DESIGNED BY:	MARC FOISY	VT ROUTE 279 WESTBOUND PRO-03	

1/26/2010 4:47:07 PM v:\953\active\953002\transportation\drawing\contract\4\pilot_files\z307c4pro.279WB.ptf