


LEVEL  
 +0.080  
 +0.060  
 +0.040  
 +0.020  
 -0.020  
 -0.040  
 -0.060  
 -0.080

LEVEL  
 +0.080  
 +0.060  
 +0.040  
 +0.020  
 -0.020  
 -0.040  
 -0.060  
 -0.080

NOTE:  
 ELEVATIONS SHOWN TO THE NEAREST HUNDREDTH ARE EXISTING GROUND.  
 ELEVATIONS SHOWN TO THE NEAREST THOUSANDTH ARE FINISH GRADE.

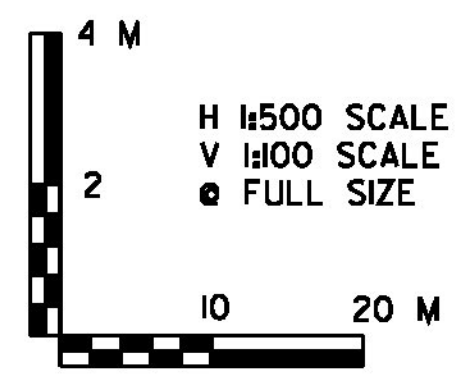

PROJECT NAME:	BENNINGTON	PLOT DATE:	1/26/2010
PROJECT NUMBER:	NH 019-1(54)	DRAWN BY:	STANTEC
FILE NAME:	...zd307c4pro.279WB.ptf	DESIGNED BY:	MARC FOISY
DESIGN SUPERVISOR:	GREG EDWARDS	CHECKED BY:	GARY SANTY
VT ROUTE 279 WESTBOUND PRO-05		SHEET	81 OF 468

1/26/2010 4:47:09 PM v:\953\active\953002\transportation\drawings\contract\4\blot\_files\z307c4pro.279WB.ptf