


NOTE:
ELEVATIONS SHOWN TO THE NEAREST HUNDREDTH ARE EXISTING GROUND.
ELEVATIONS SHOWN TO THE NEAREST THOUSANDTH ARE FINISH GRADE.

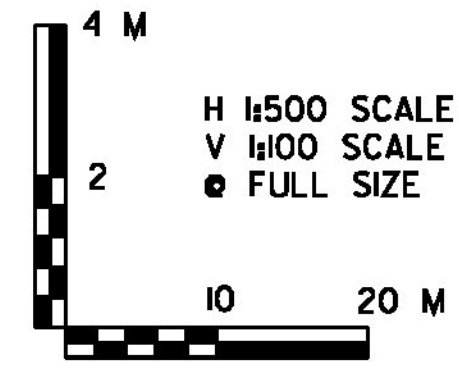

PROJECT NAME:	BENNINGTON	FILE NAME:	..\\zd307c4pro.279EB.ppf	PLOT DATE:	1/26/2010
PROJECT NUMBER:	NH 019-1(54)	DESIGN SUPERVISOR:	GREG EDWARDS	DRAWN BY:	STANTEC
		DESIGNED BY:	MARC FOISY	CHECKED BY:	GARY SANTY
		VT ROUTE 279 EASTBOUND PRO-06		SHEET	82 OF 468

1/26/2010 4:47:12 PM v:\953\active\953002\transportation\drw\metric\cont\cont.ctb...files\z307c4pro.279EB.ppf